


06-24-06B-101-014

SCAN # 45714

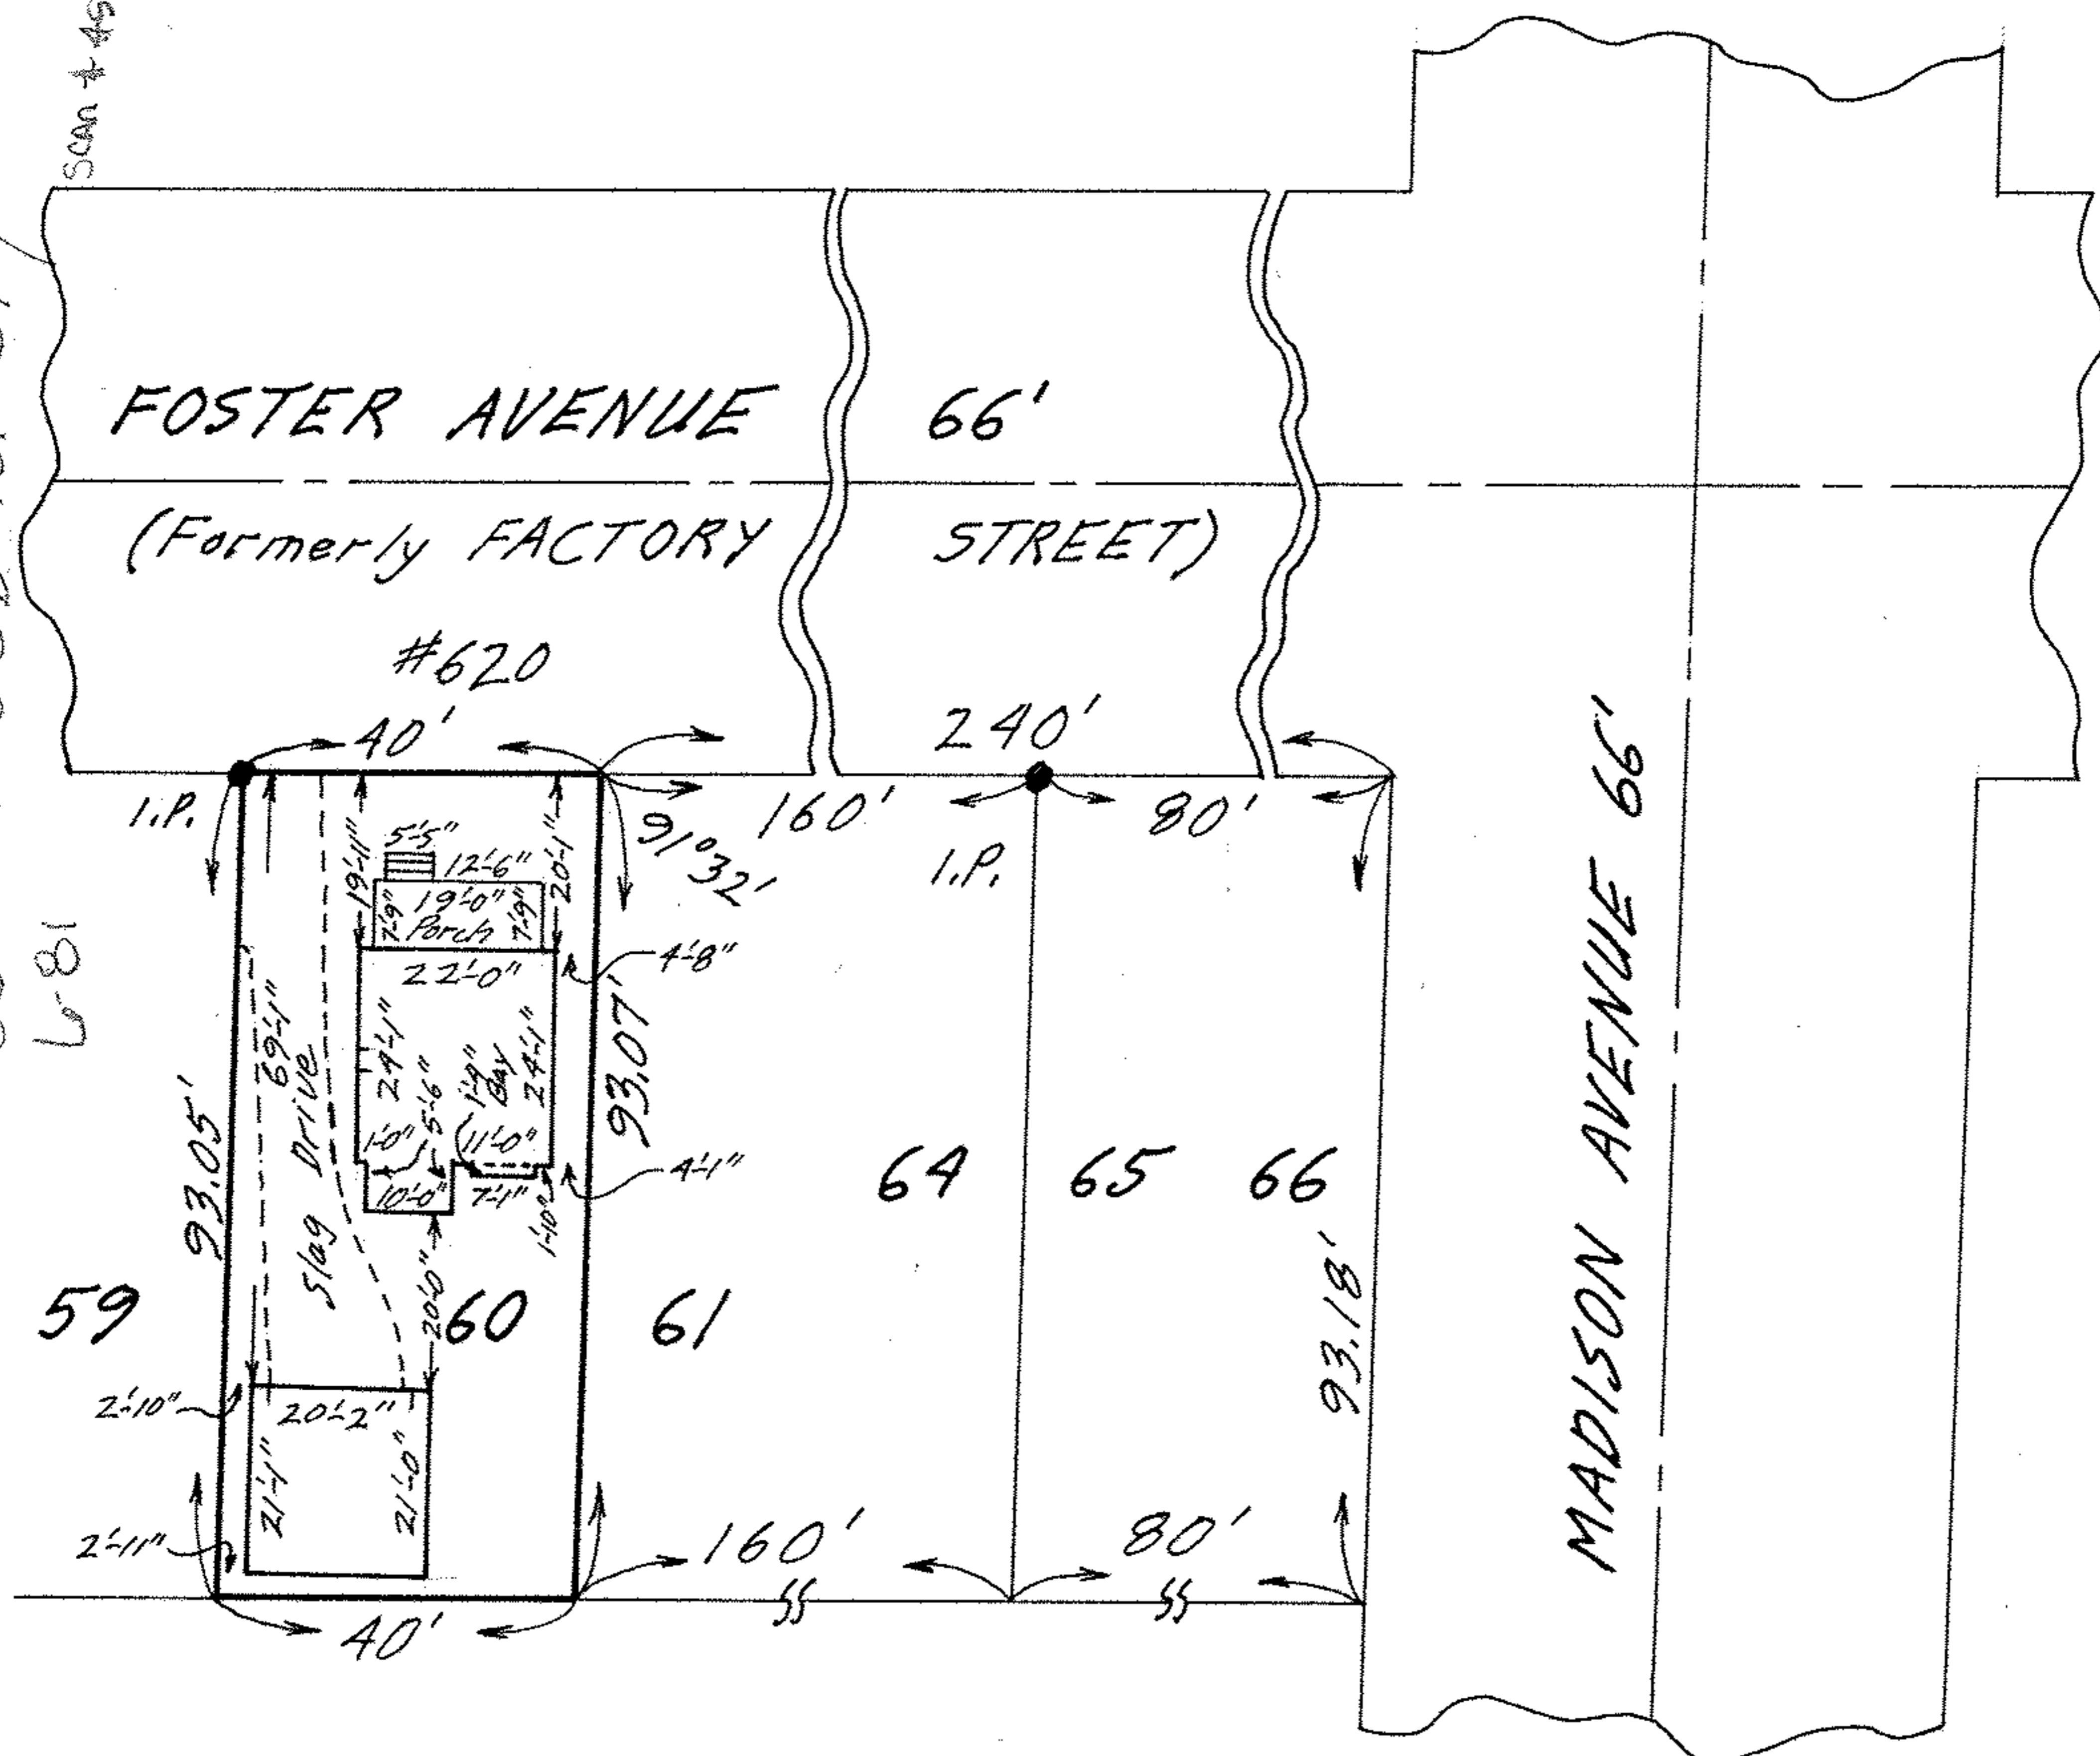

MAP OF SUB-LOT NO. 60

FOSTER'S SUB'N.

VOL. 5 PG. 7

ORIG. LOT 66 - WEST OF BLACK RIVER

ELYRIA TWP.

ELYRIA CITY

LORAIN COUNTY

OHIO

SCALE: 1" = 30' JUNE 30-1970 8:00 P.M.

NOTE: There are no encroachments on this property.

Gary E. Penfound REG. SURVEYOR NO. 4457

CITY TITLE Co. Order No. E-1179-80

Paul L. & Mary L. Lucas to

Edward L. & Karen L. Coverder

