


00.24.077.000.001-003  
6-100  
SCAN #45578

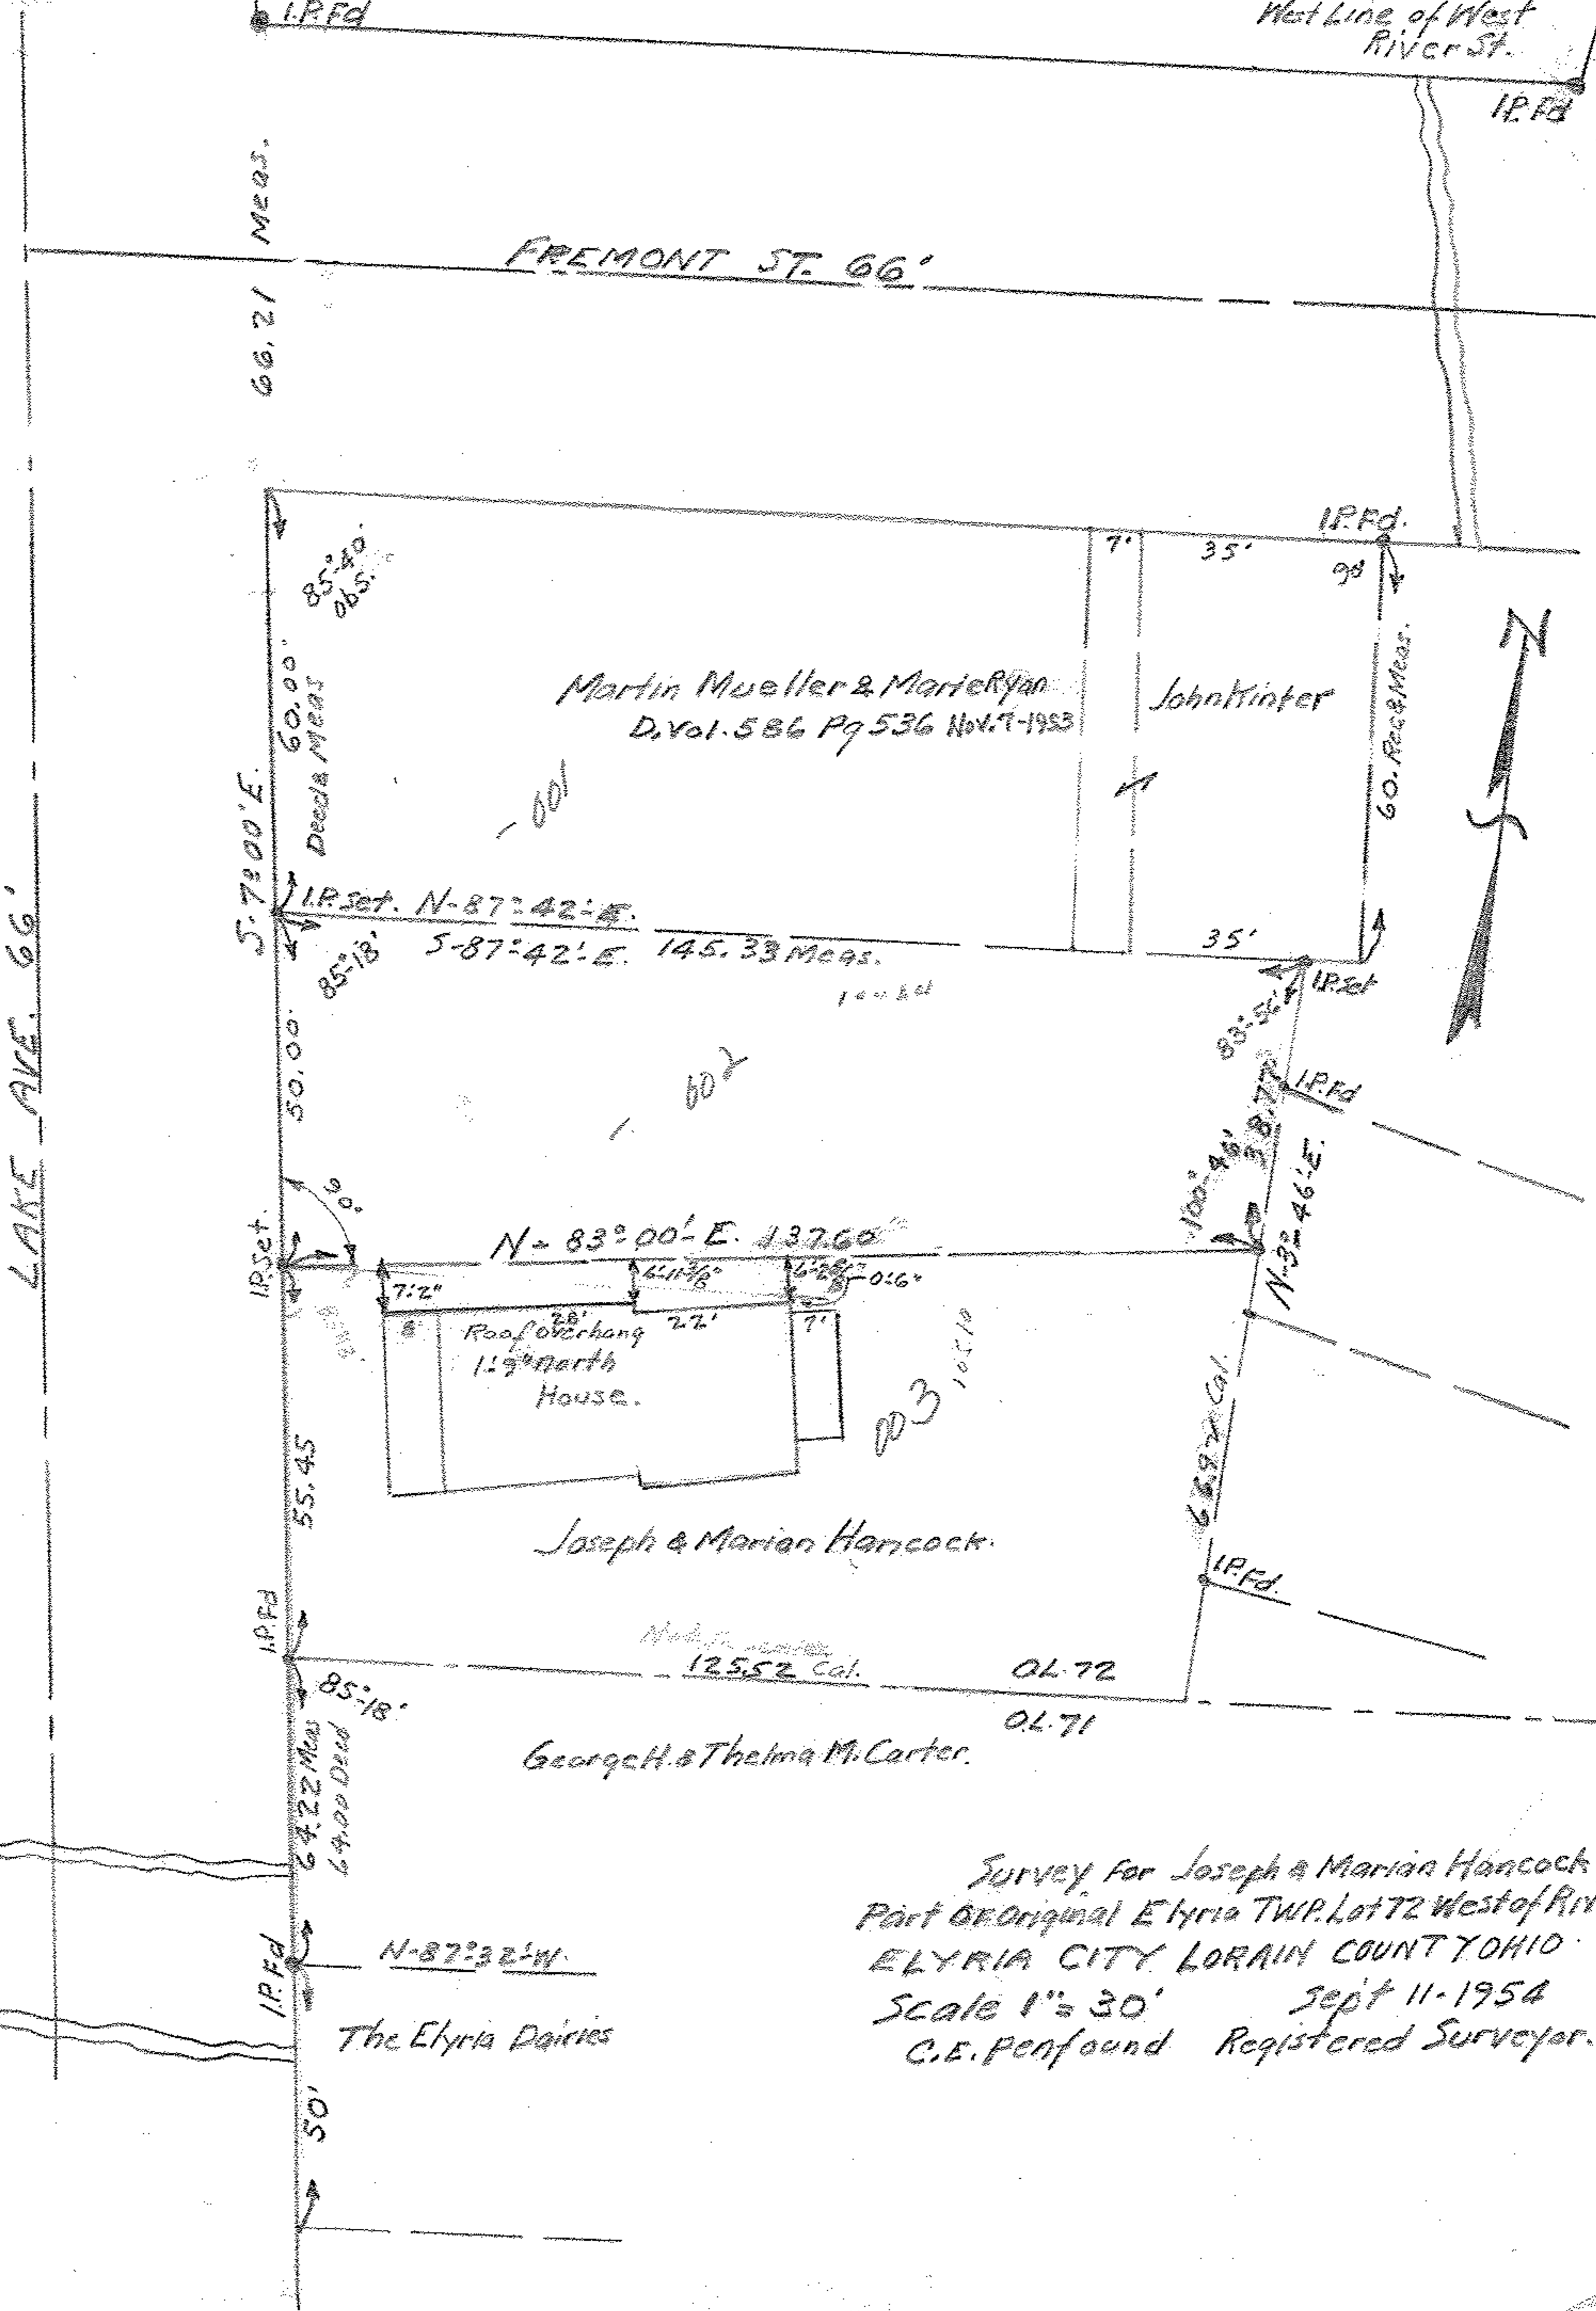

00.24.077.000.001-003

Survey for Joseph & Marian Hancock.  
Part of Original Elyria TWP. Lot 72 West of Riv.  
ELYRIA CITY LORAIN COUNTY OHIO  
Scale 1" = 30' Sept 11-1954  
C.E. Penfound Registered Surveyor.