

10-000-000-000-000


06-24-098-000-011

6-117

SCAN # 45784

E HAZEL STREET 60'

WEST RIVER STREET 66'

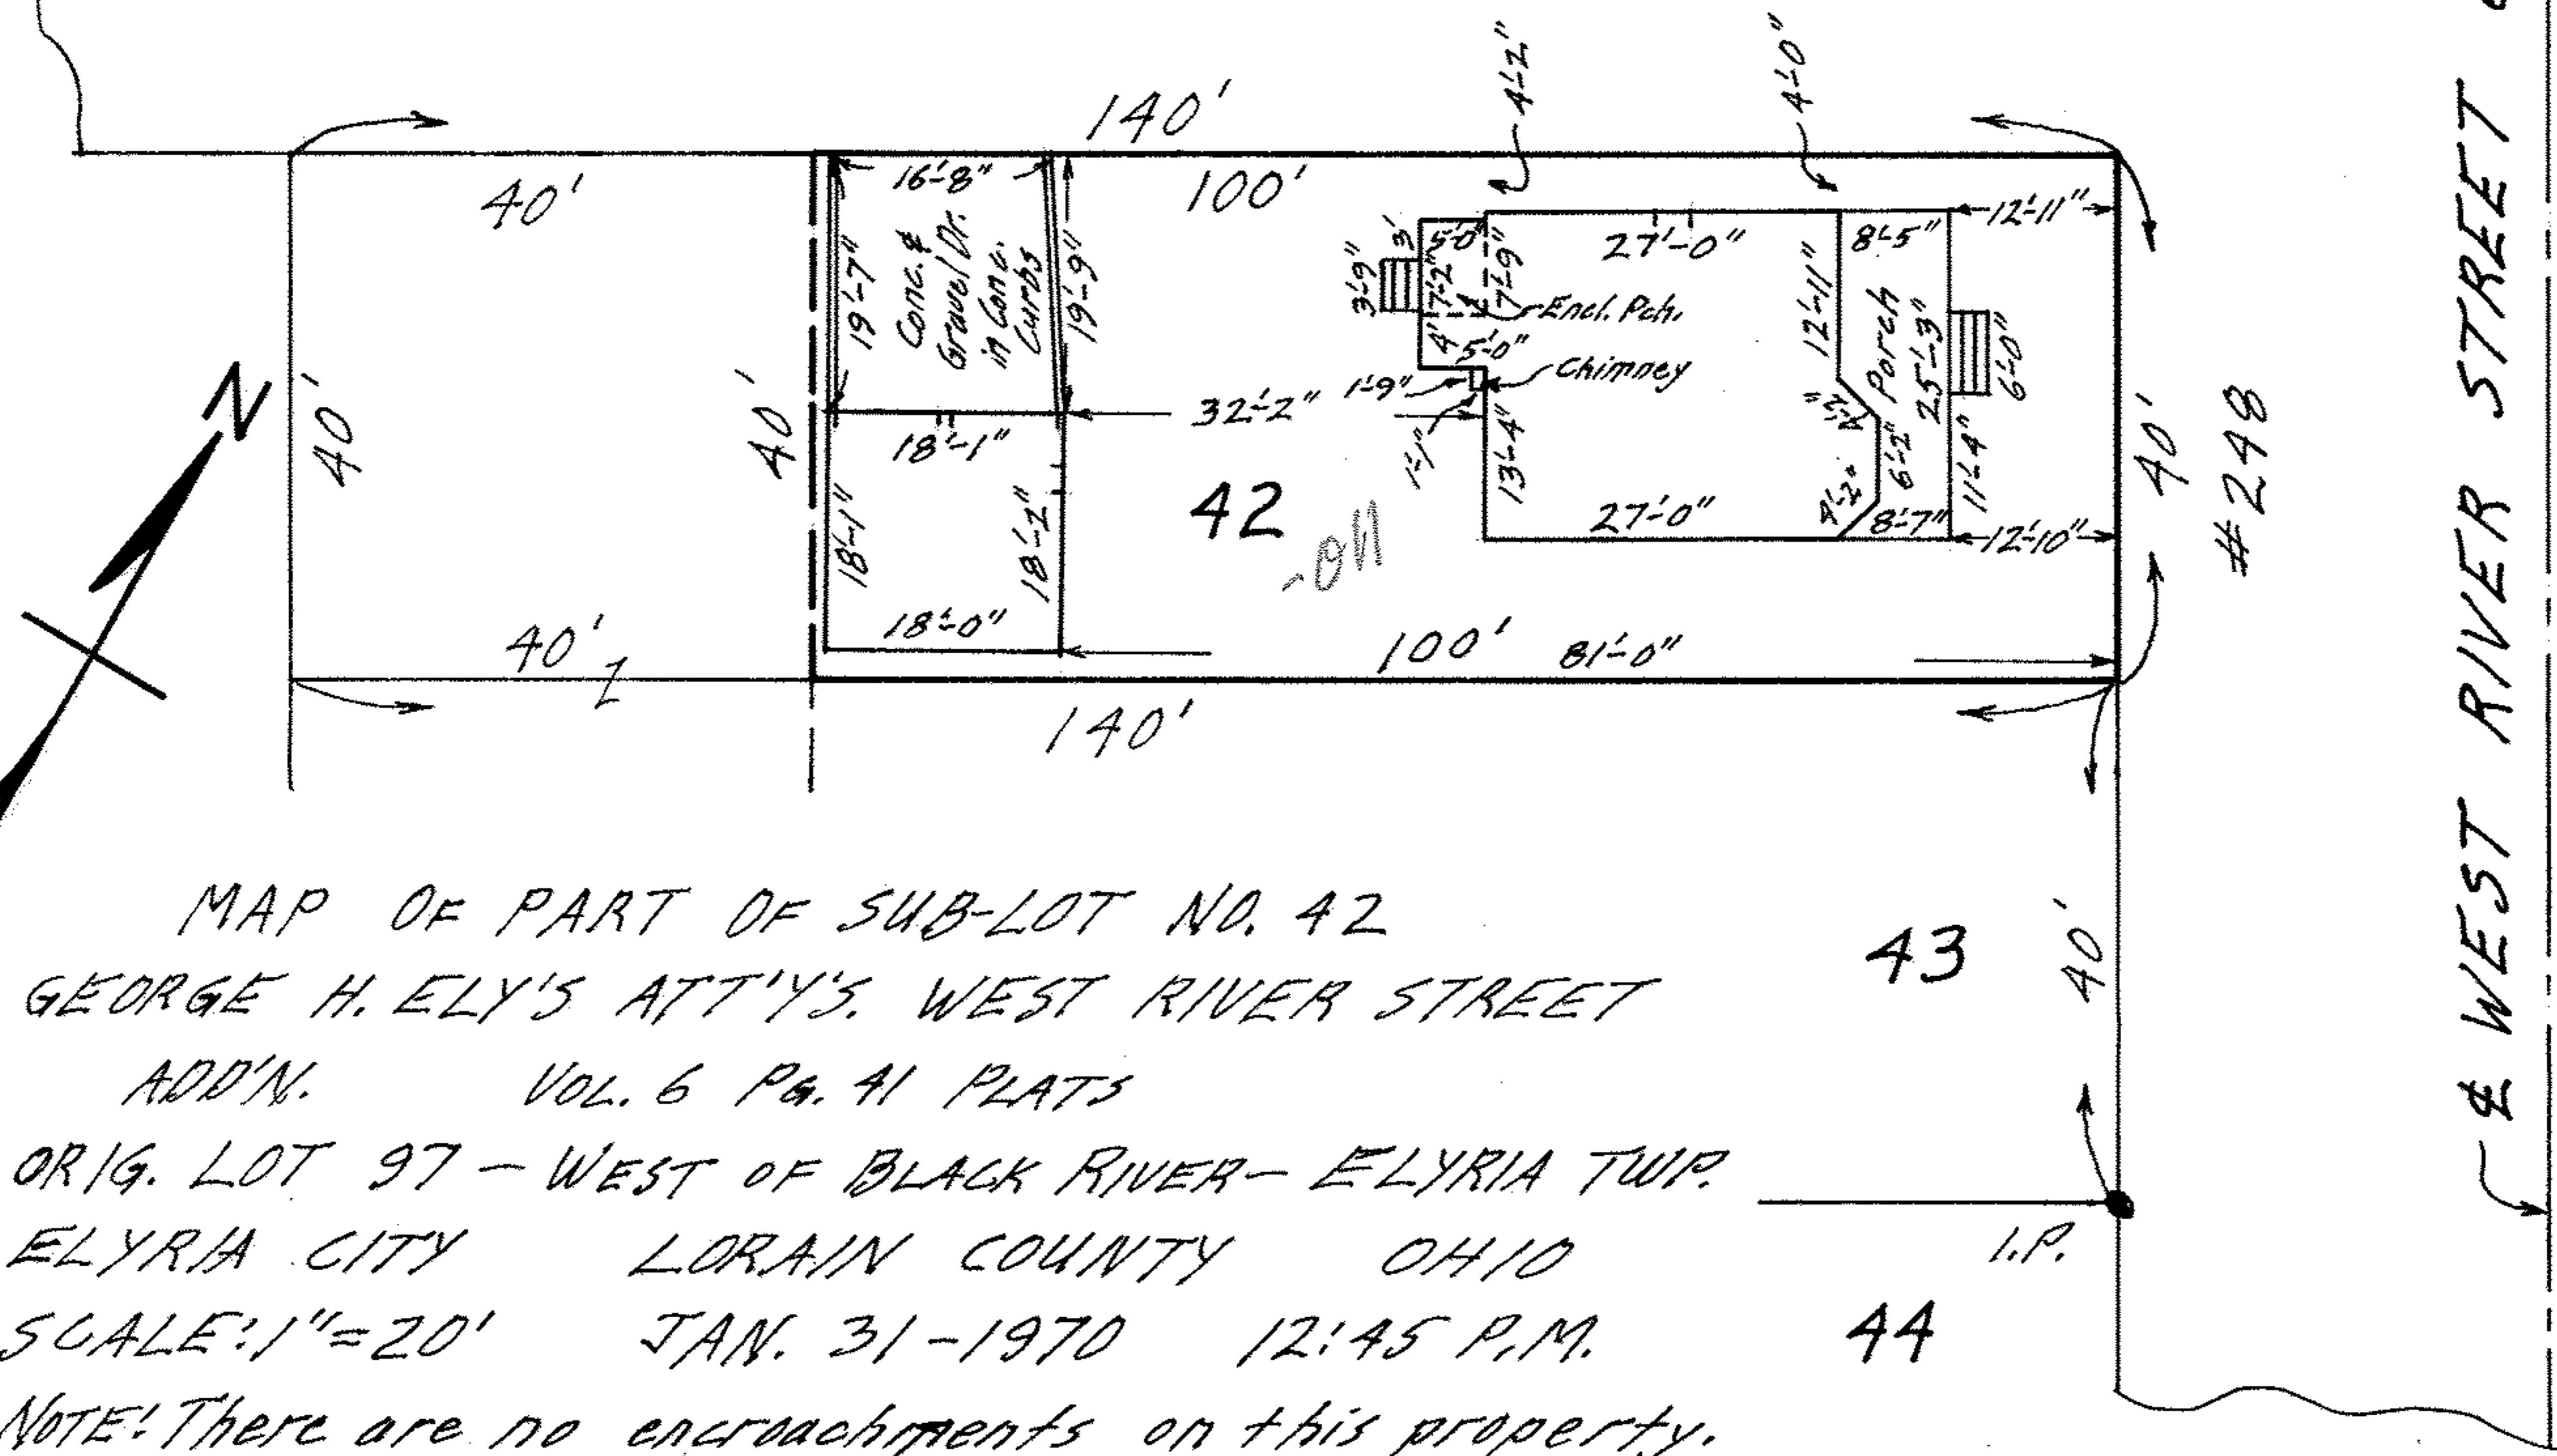

MAP OF PART OF SUB-LOT NO. 42
 GEORGE H. ELY'S ATT'Y'S. WEST RIVER STREET
 ADD'N. VOL. 6 PG. 41 PLATS
 ORIG. LOT 97 - WEST OF BLACK RIVER - ELYRIA TWP.
 ELYRIA CITY LORAIN COUNTY OHIO
 SCALE: 1" = 20' JAN. 31 - 1970 12:45 P.M.

NOTE: There are no encroachments on this property.
 Gary E. Penfound REG. SURVEYOR NO. 4457

CITY TITLE CO. Order No. E-1021-22 John H. Campbell to William James