


00 - ep. 10600c.004, 010, 011, 017, 018

PLAT OF SURVEYS FOR 6-99 MRS. FREDA MINNICH


SCANT 45784

ORIG. LOT 106 - WEST OF BLACK RIVER
ELYRIA TWP. - ELYRIA CITY
LORAIN COUNTY - OHIO
SCALE: 1"=30' OCTOBER 1972
Gary E. Penfound Reg. Surveyor No. 4957
REVISED AUGUST 4-1977

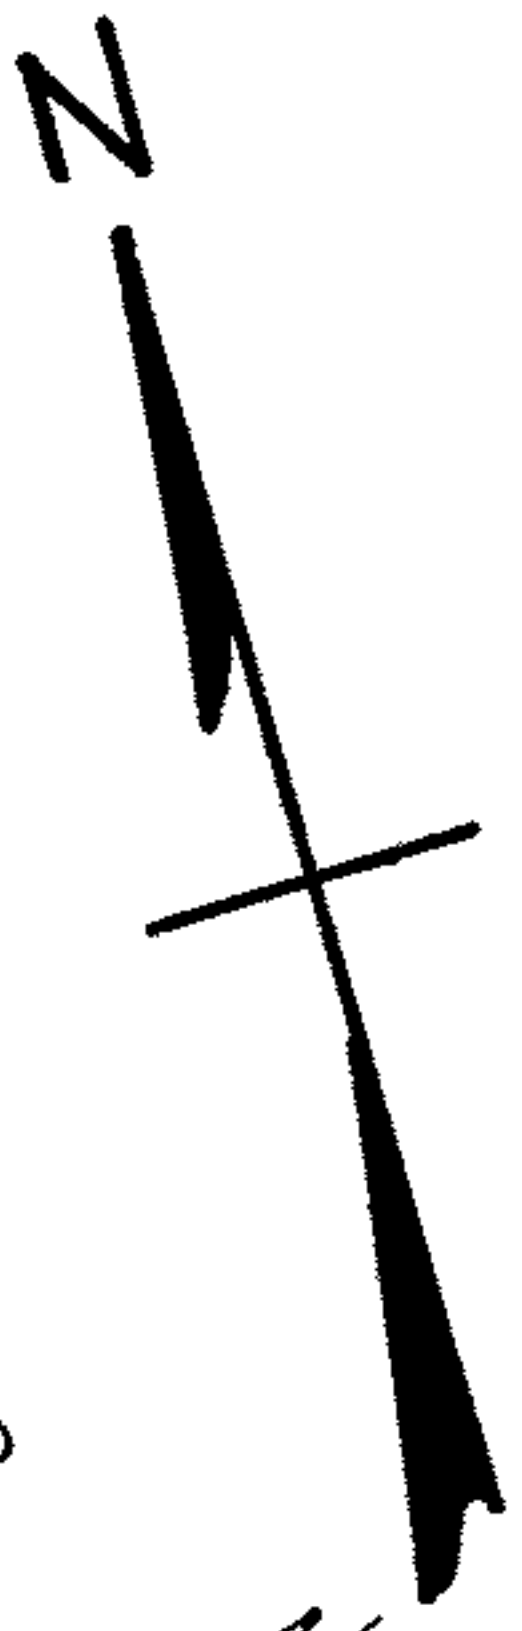

O.L. 91
O.L. 106

About
150.48'

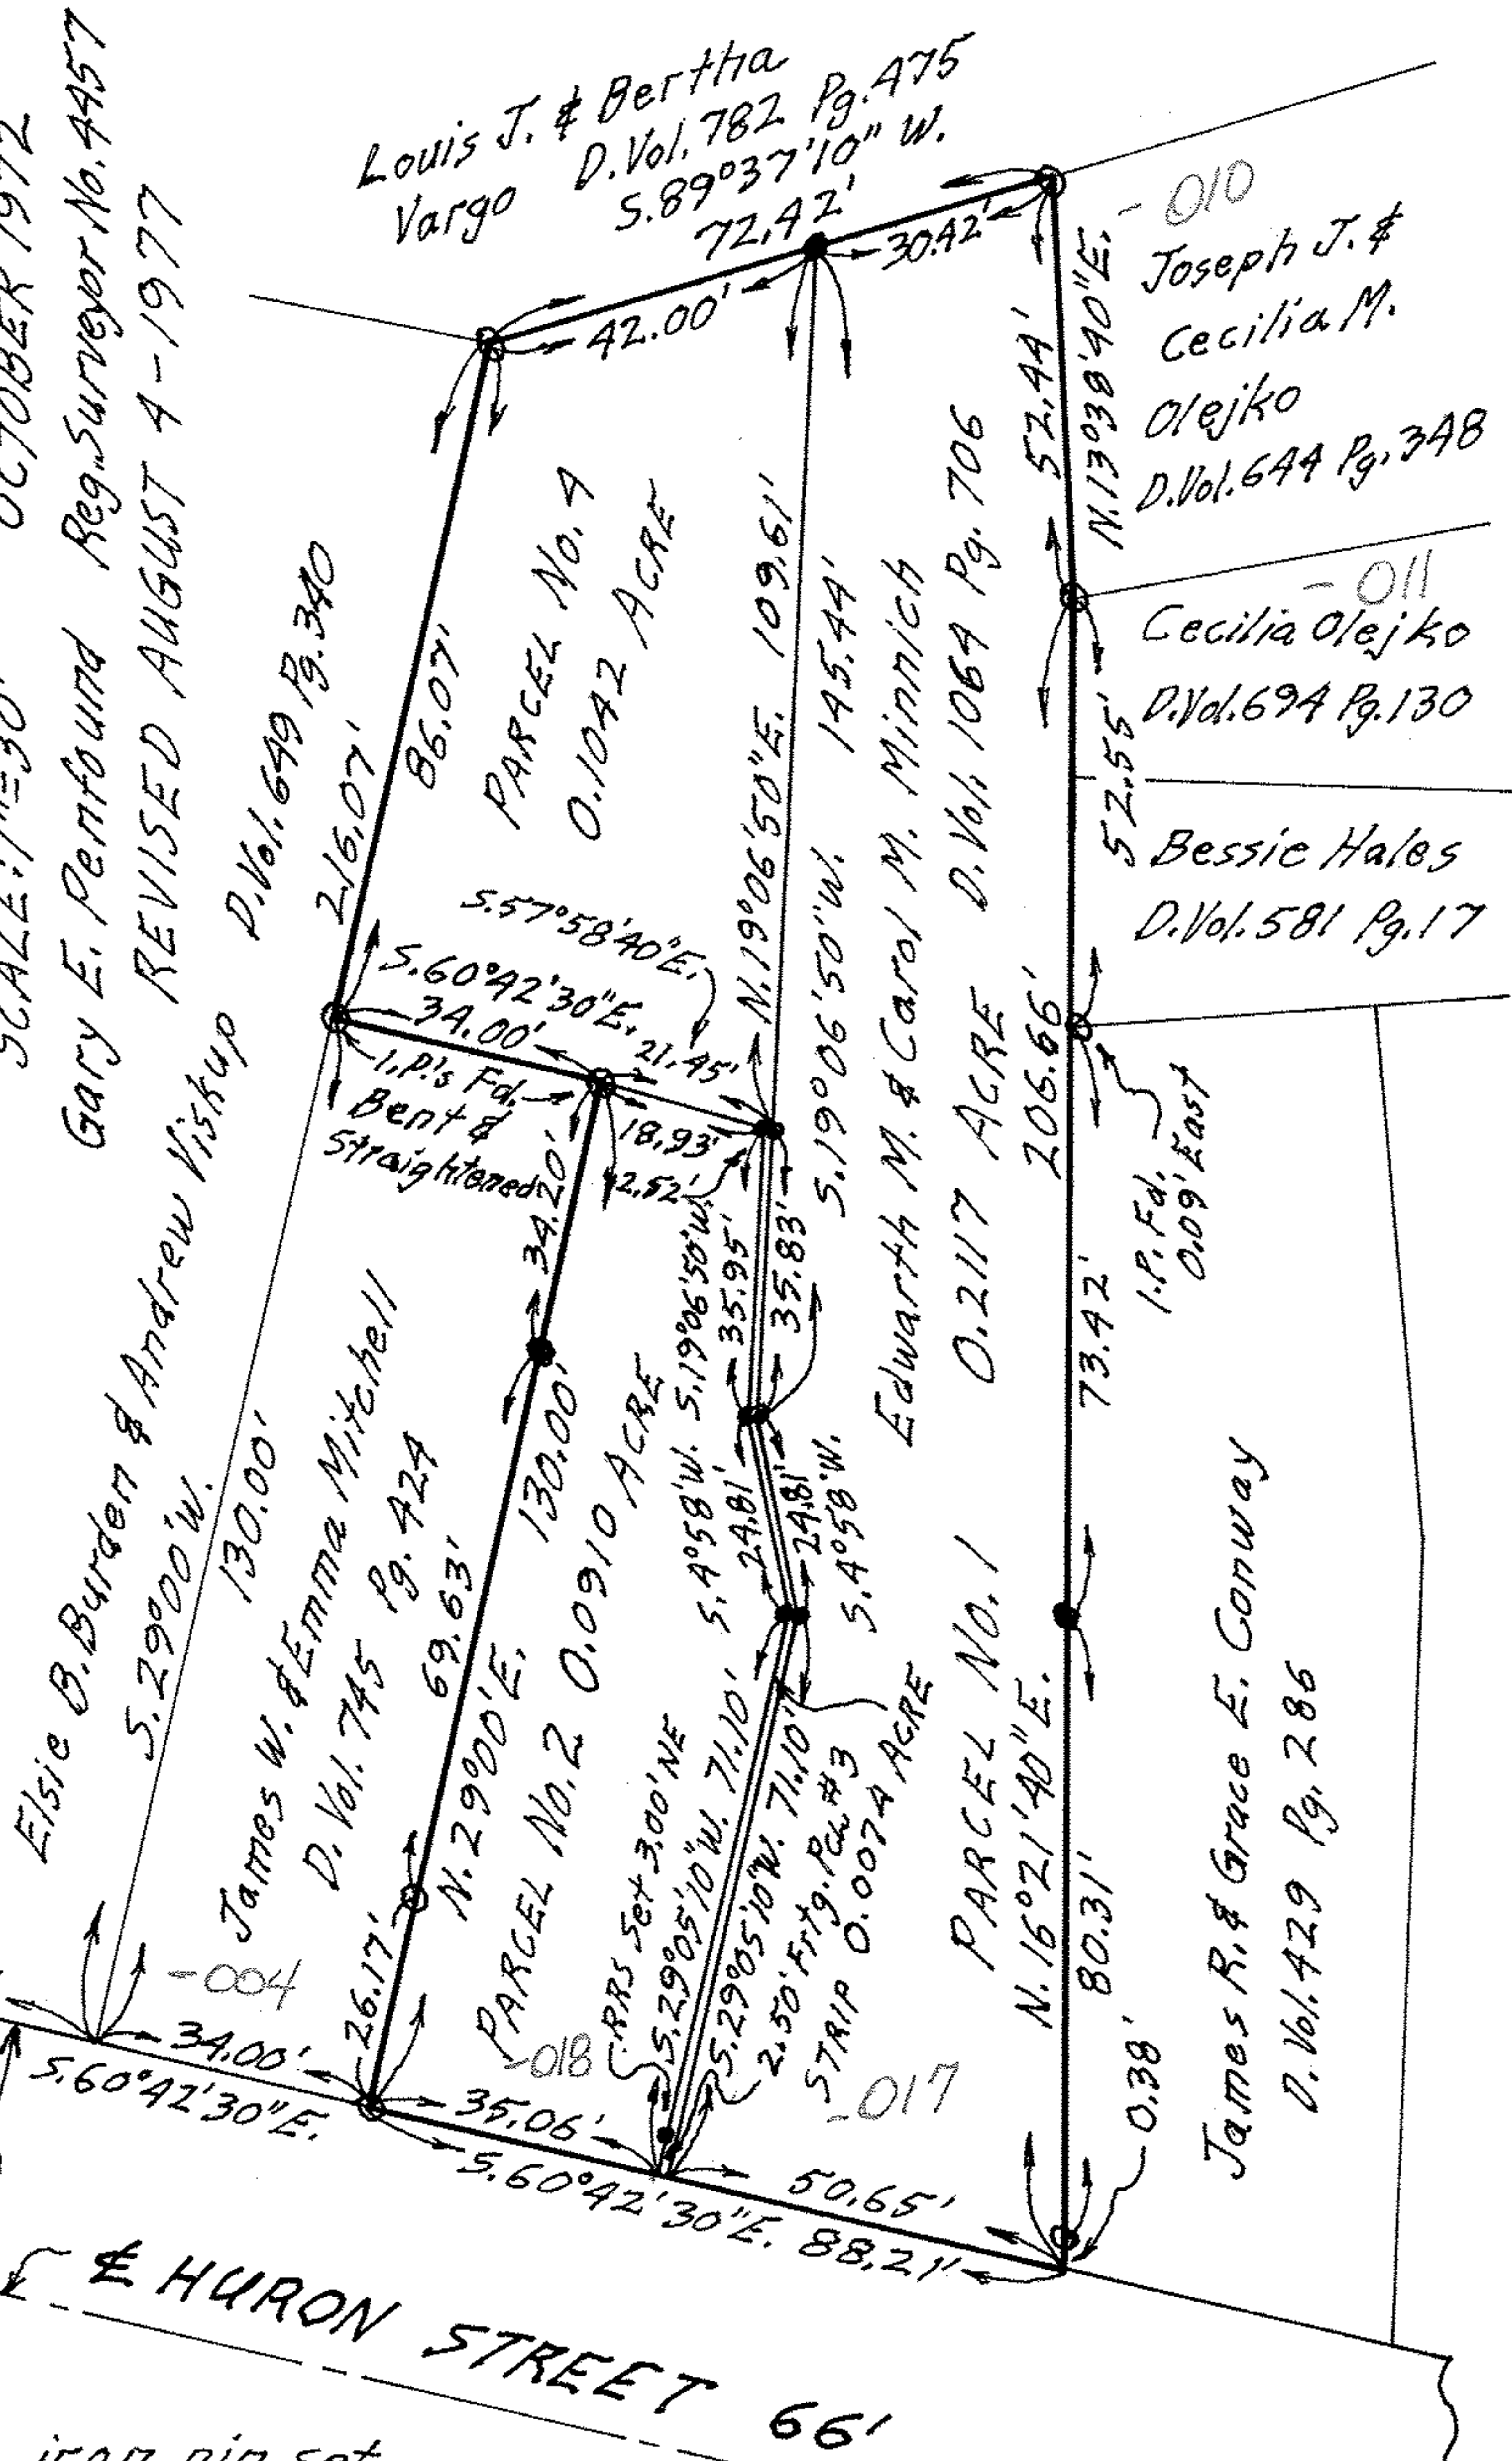

NOTES:

- indicates iron pin set.
- indicates iron pin found.