


06-24-126-000-005  
6-100  
SCAN #45790

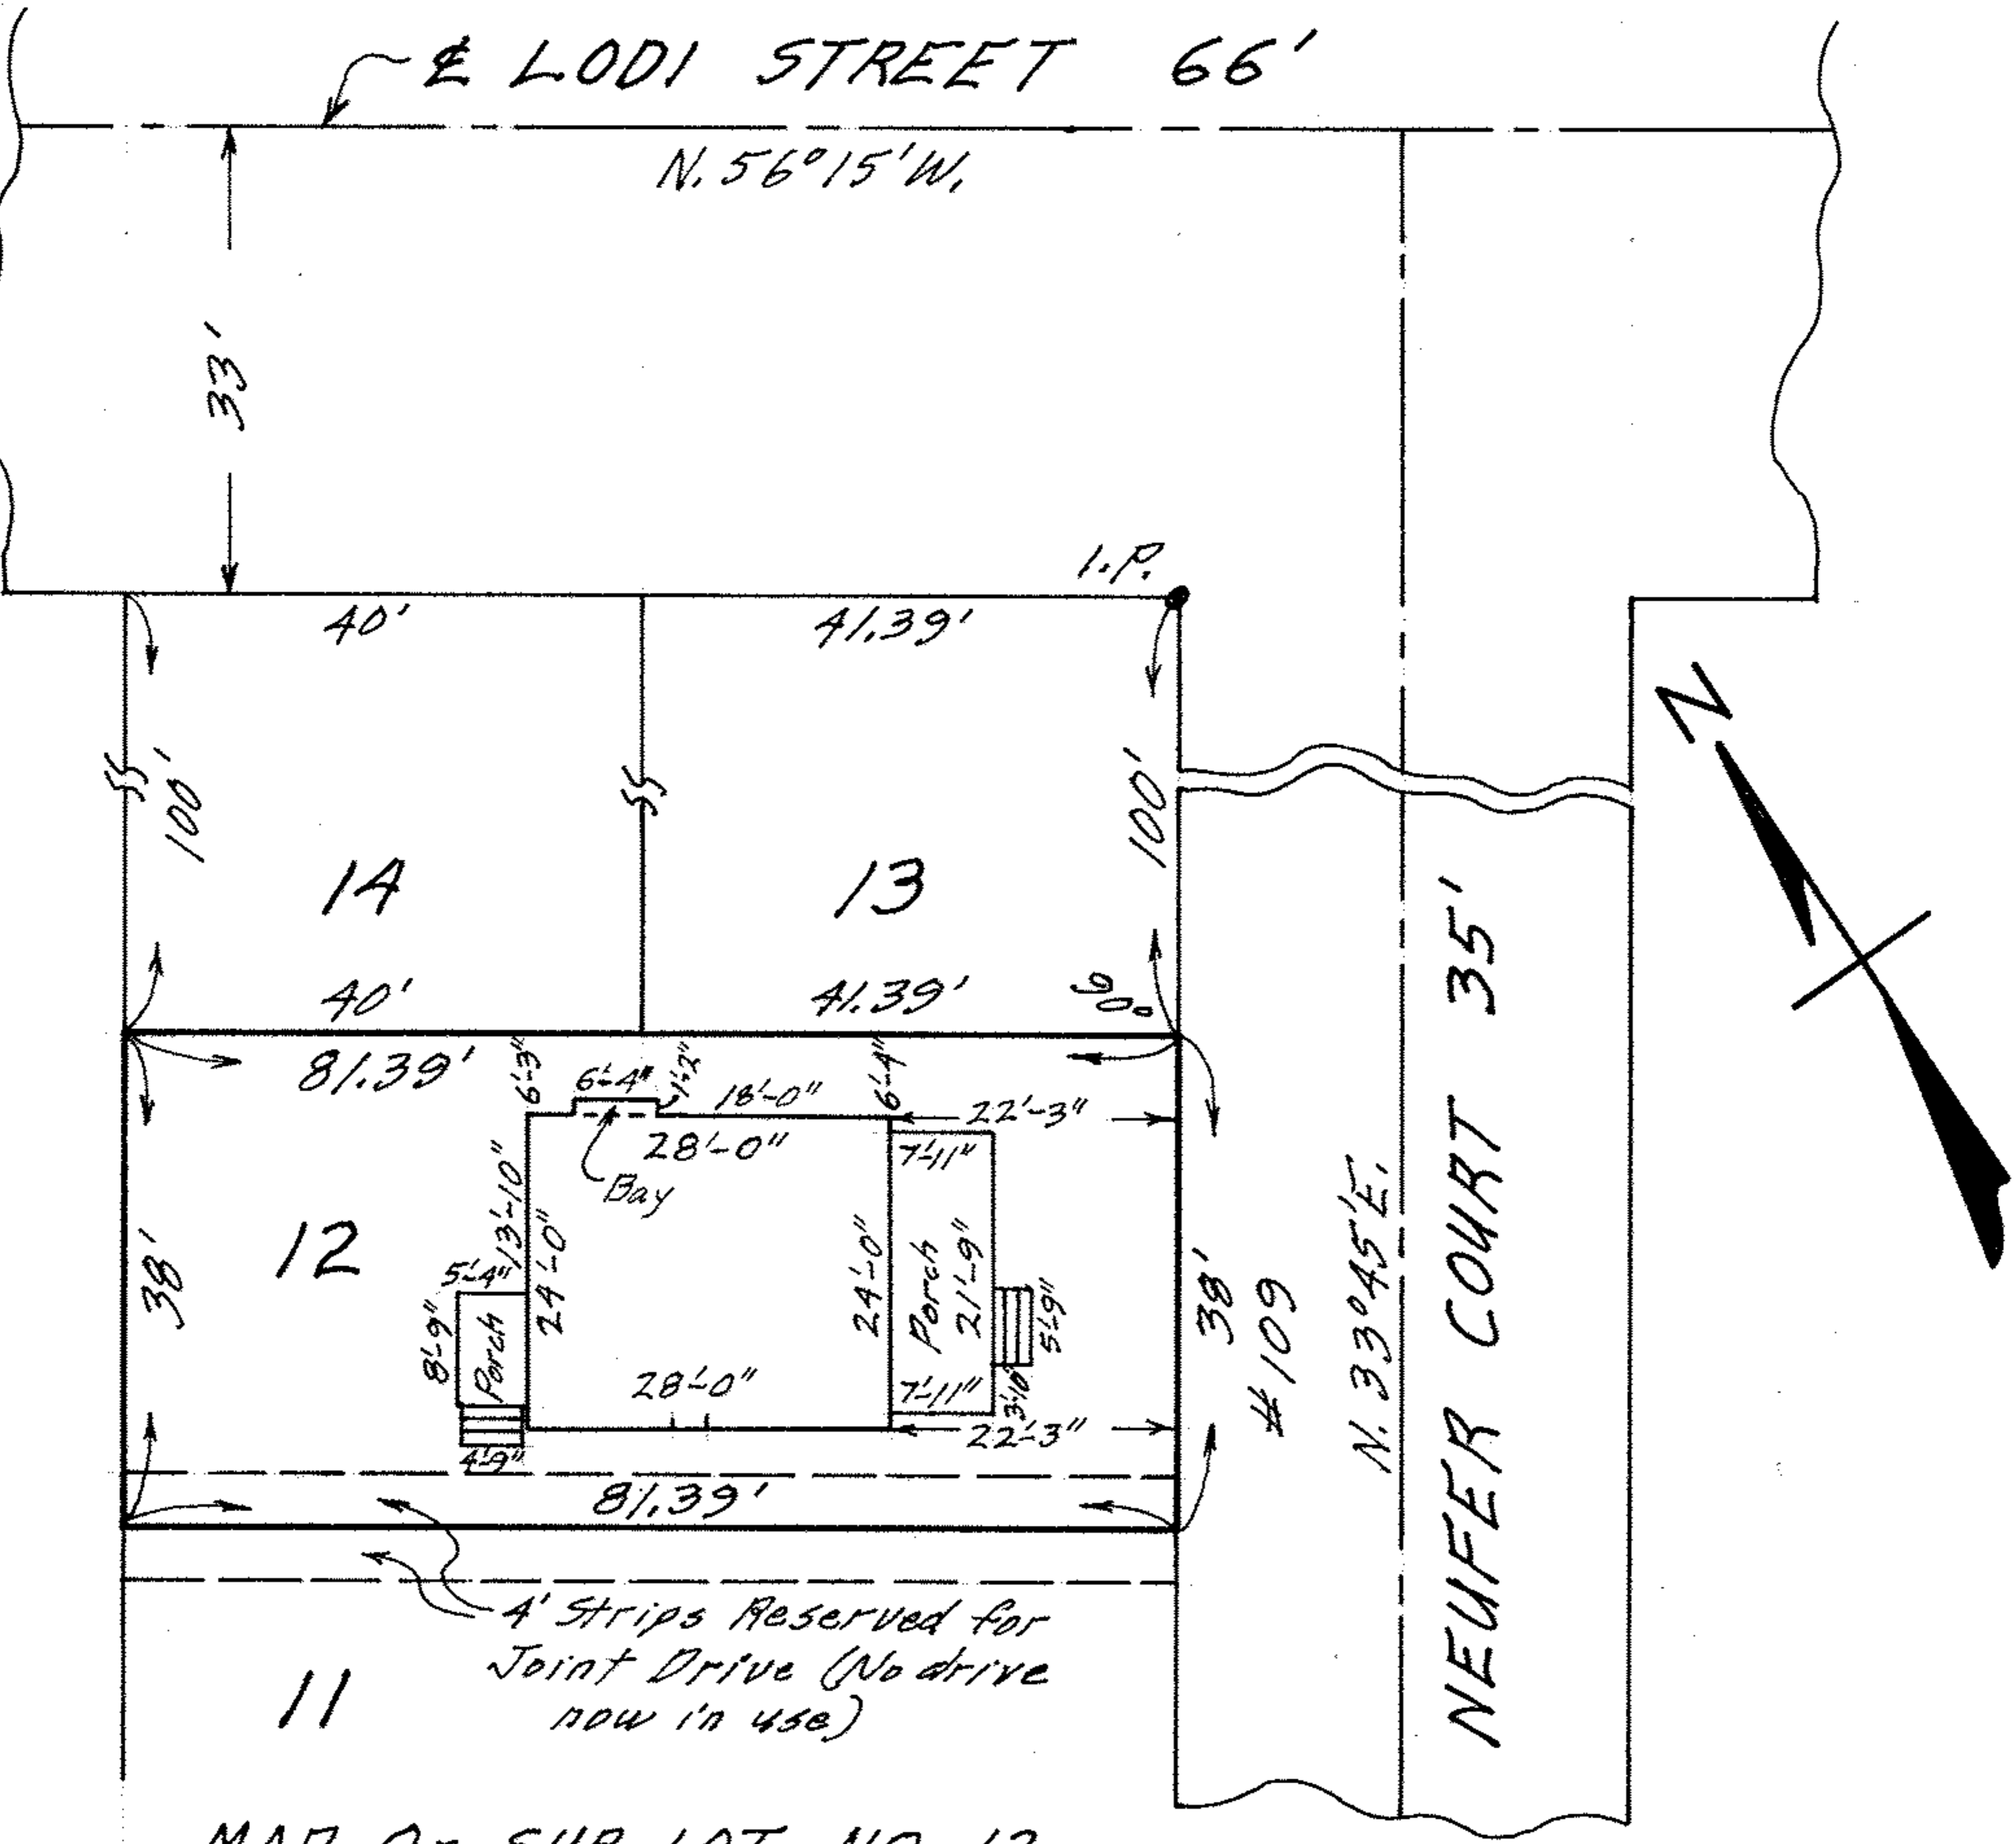

MAP OF SUB-LOT NO. 12

NEUFER BROTHERS' SUB'N. NO. 1 Vol. 7 Pg. 28

ORIG. LOT 126 - WEST OF BLACK RIVER - ELYRIA TWP.

ELYRIA CITY - LORAIN COUNTY - OHIO

SCALE: 1" = 20' DEC. 16 - 1969 12:15 P.M.

NOTE: There are no encroachments on this property.

Gary E. Penfound REG. SURVEYOR NO. 4457

CITY TITLE Co. Order No. E-976-7

Lena Becker to Johnny W. & Shirley E. Harrath