

06-25-002-103-044


L-141

I.P. Set

140' SCAM # 45798

98.0°

PROSPECT STREET 66'

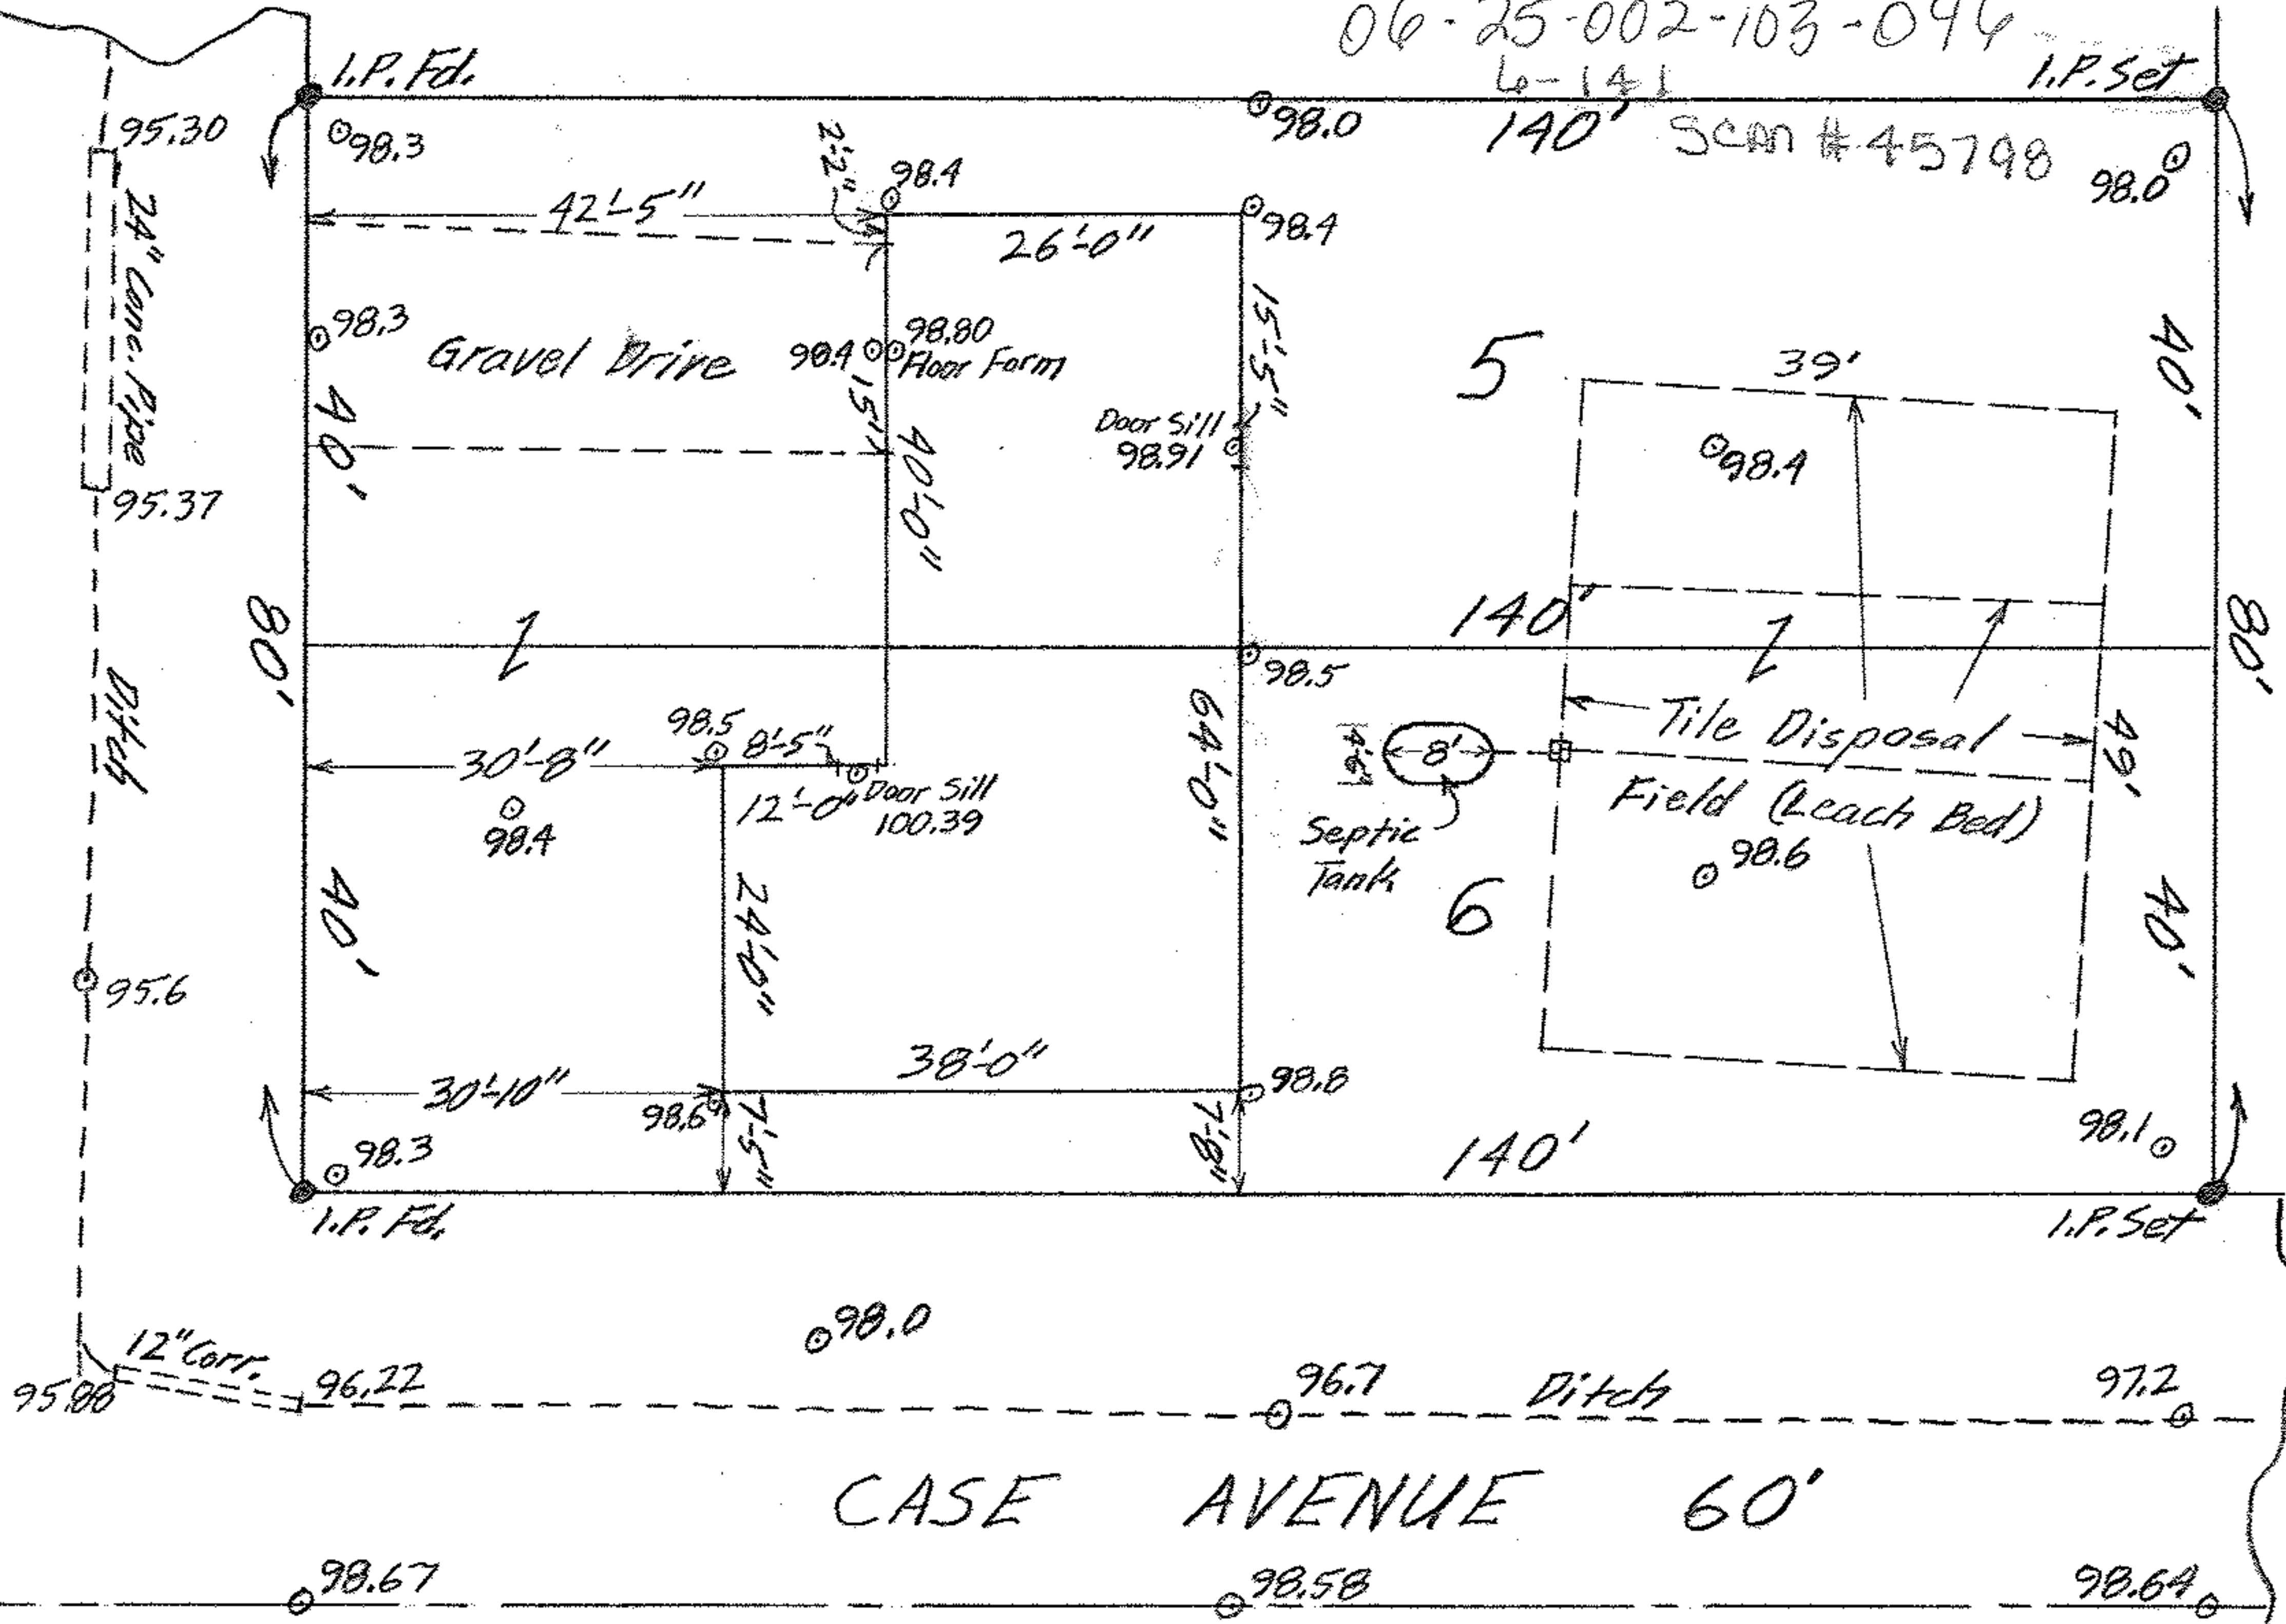

Bench Mark  
 "M" in MATHEWS  
 on Hydrant  
 Elev. 100.00 Assumed

I.P. Fd.

PLAT OF SURVEY FOR CHARLES L. DUNLAP  
 SUB-LOTS 5 & 6 ELMWOOD ALL'T. VOL. 7 PG. 31  
 ORIG. LOT 2 - EAST OF BLACK RIVER - ELYRIA TWP.  
 ELYRIA CITY LORAIN COUNTY OHIO

SCALE: 1" = 20' APRIL 11-1961

Gary E. Penfound Reg. Surveyor No. 4457

NOTE: ⊙ denotes point of observed elevation.