


06-25-002-105-001
6-141 scan# 45800

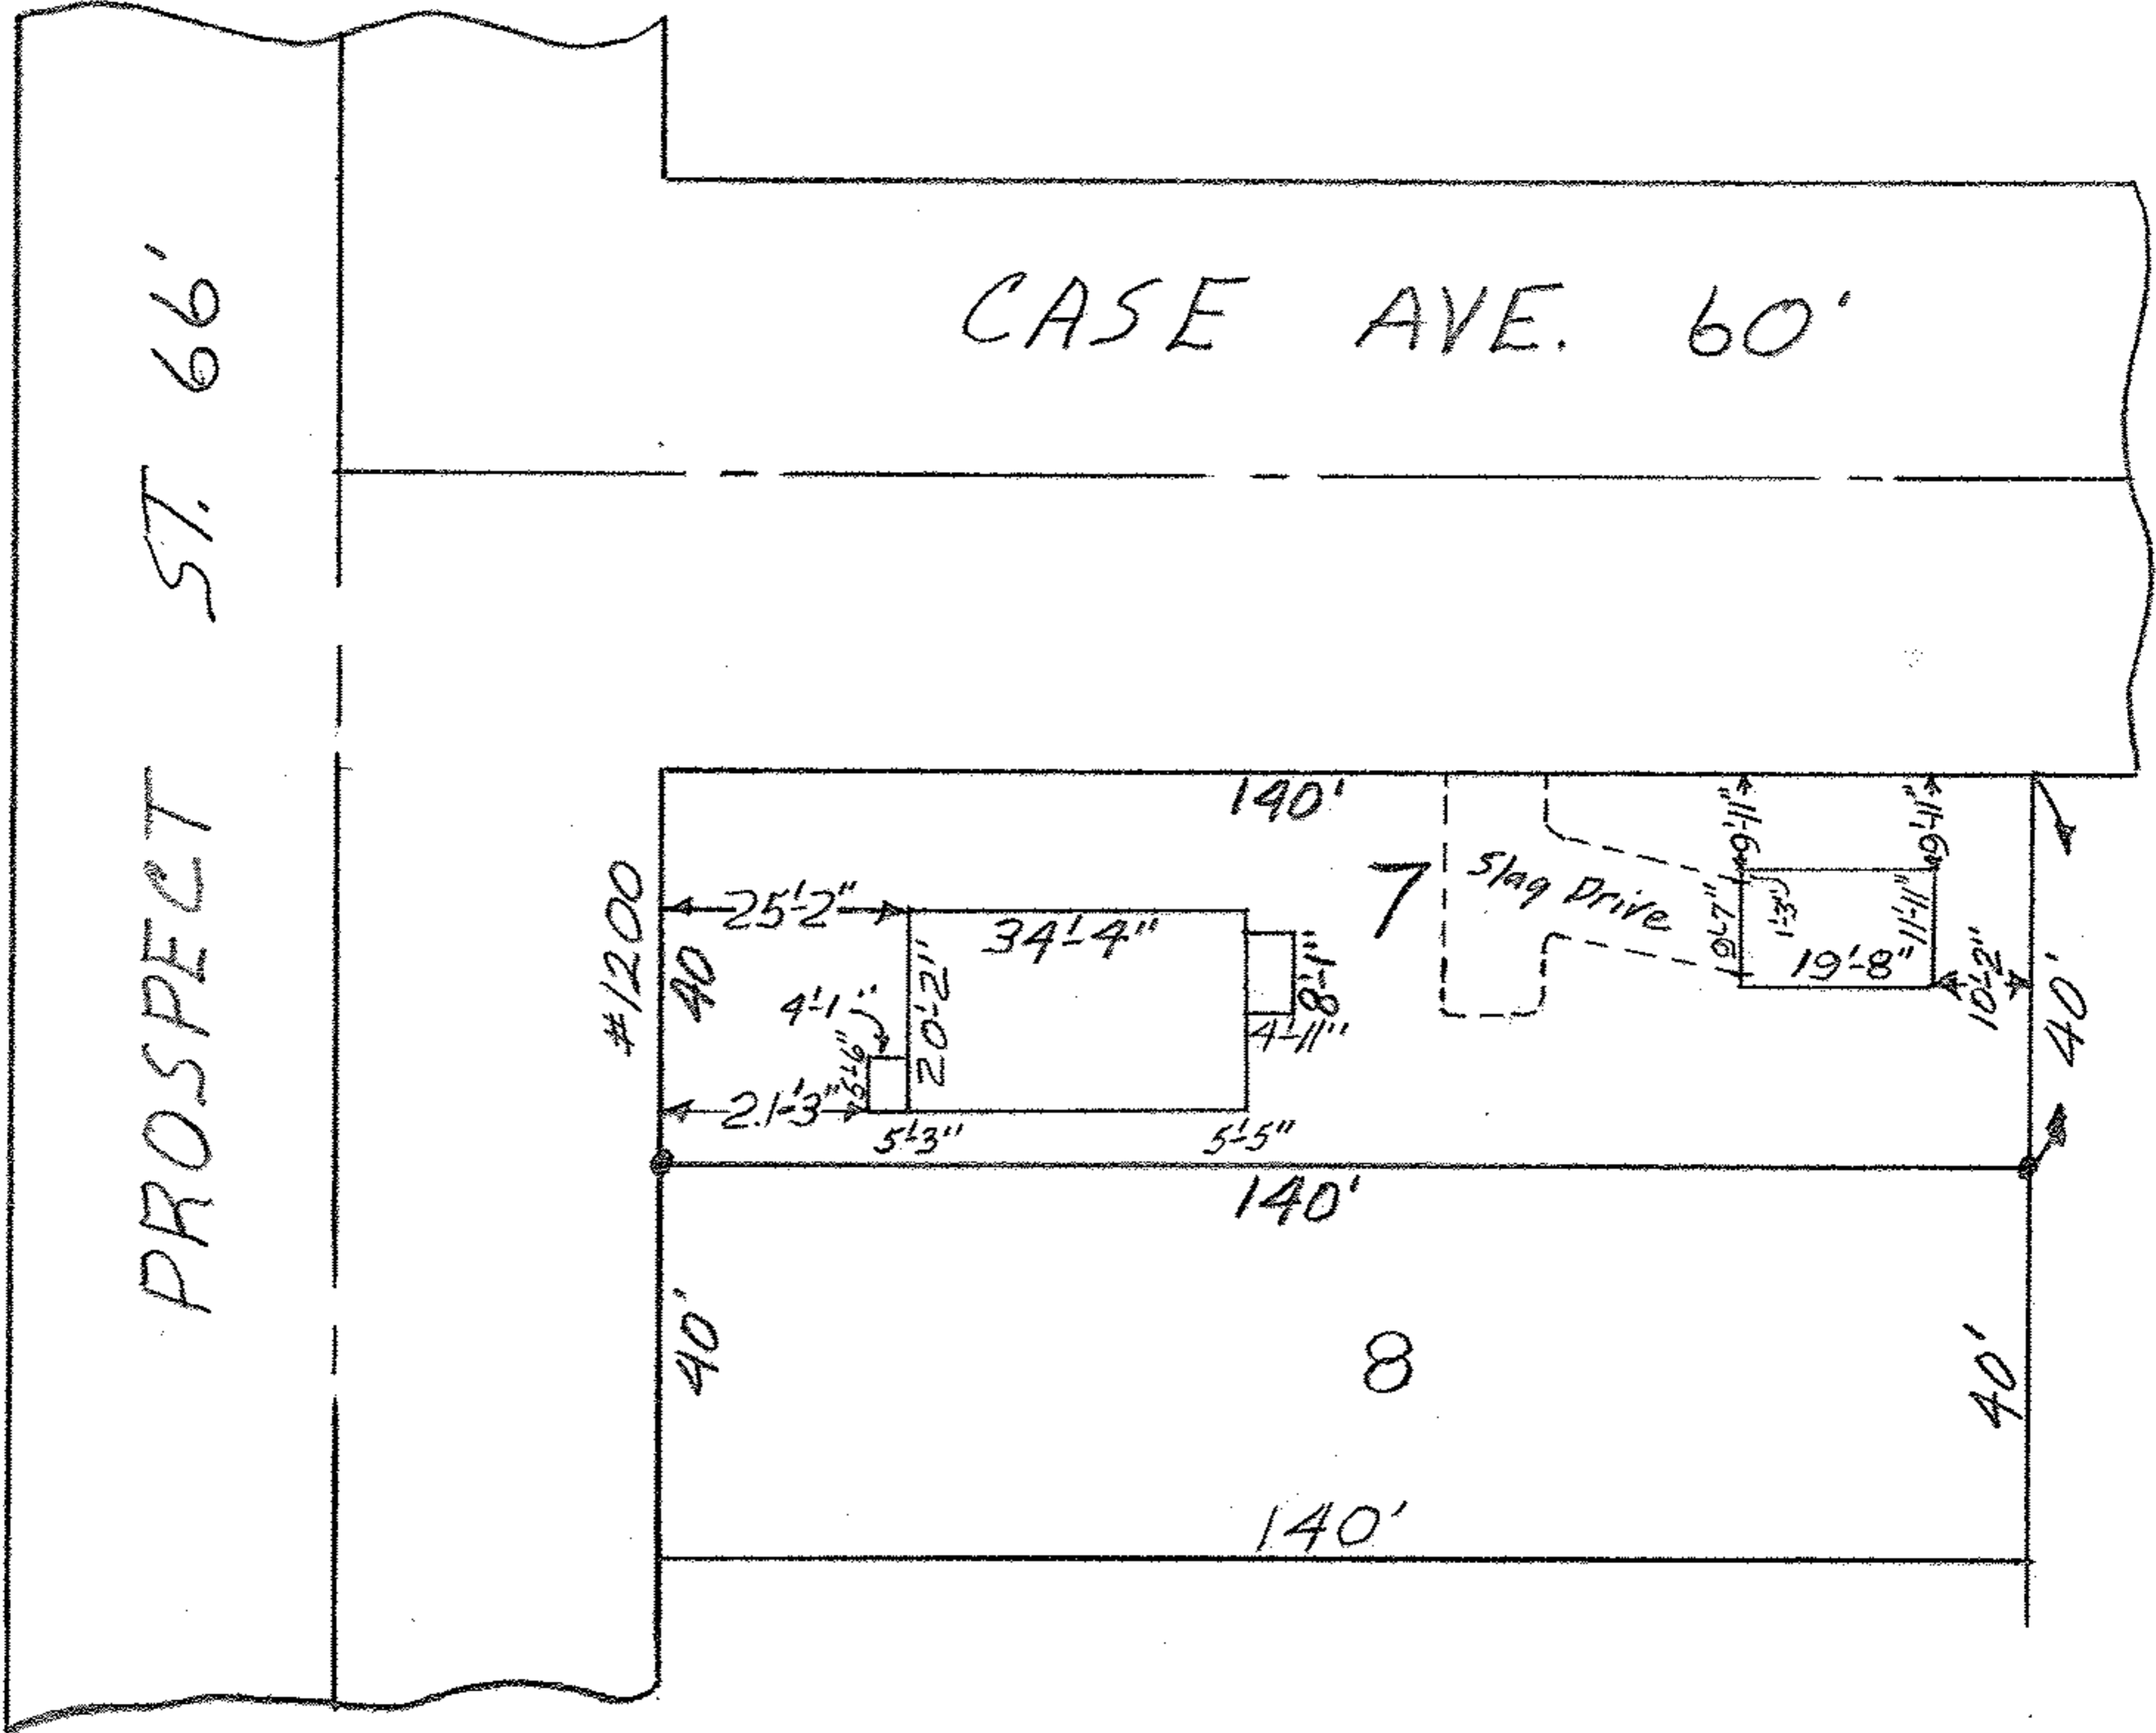

MAP of SUB-LOT 7
 ELMWOOD PLAT Vol. 7, Pg 31 PLATS
 EAST of BLACK RIVER ELYRIA CITY
 LORAIN COUNTY-OHIO

Scale: 1"=30' JAN. 23, 1963 1:30 P.M.

Mary E. Penfound Registered Surveyor

Robert C. & Sherry L. Terry W W