


BERKS TITLE INSURANCE CO.
Order No. 1166 James A. & Ann F. Farrell

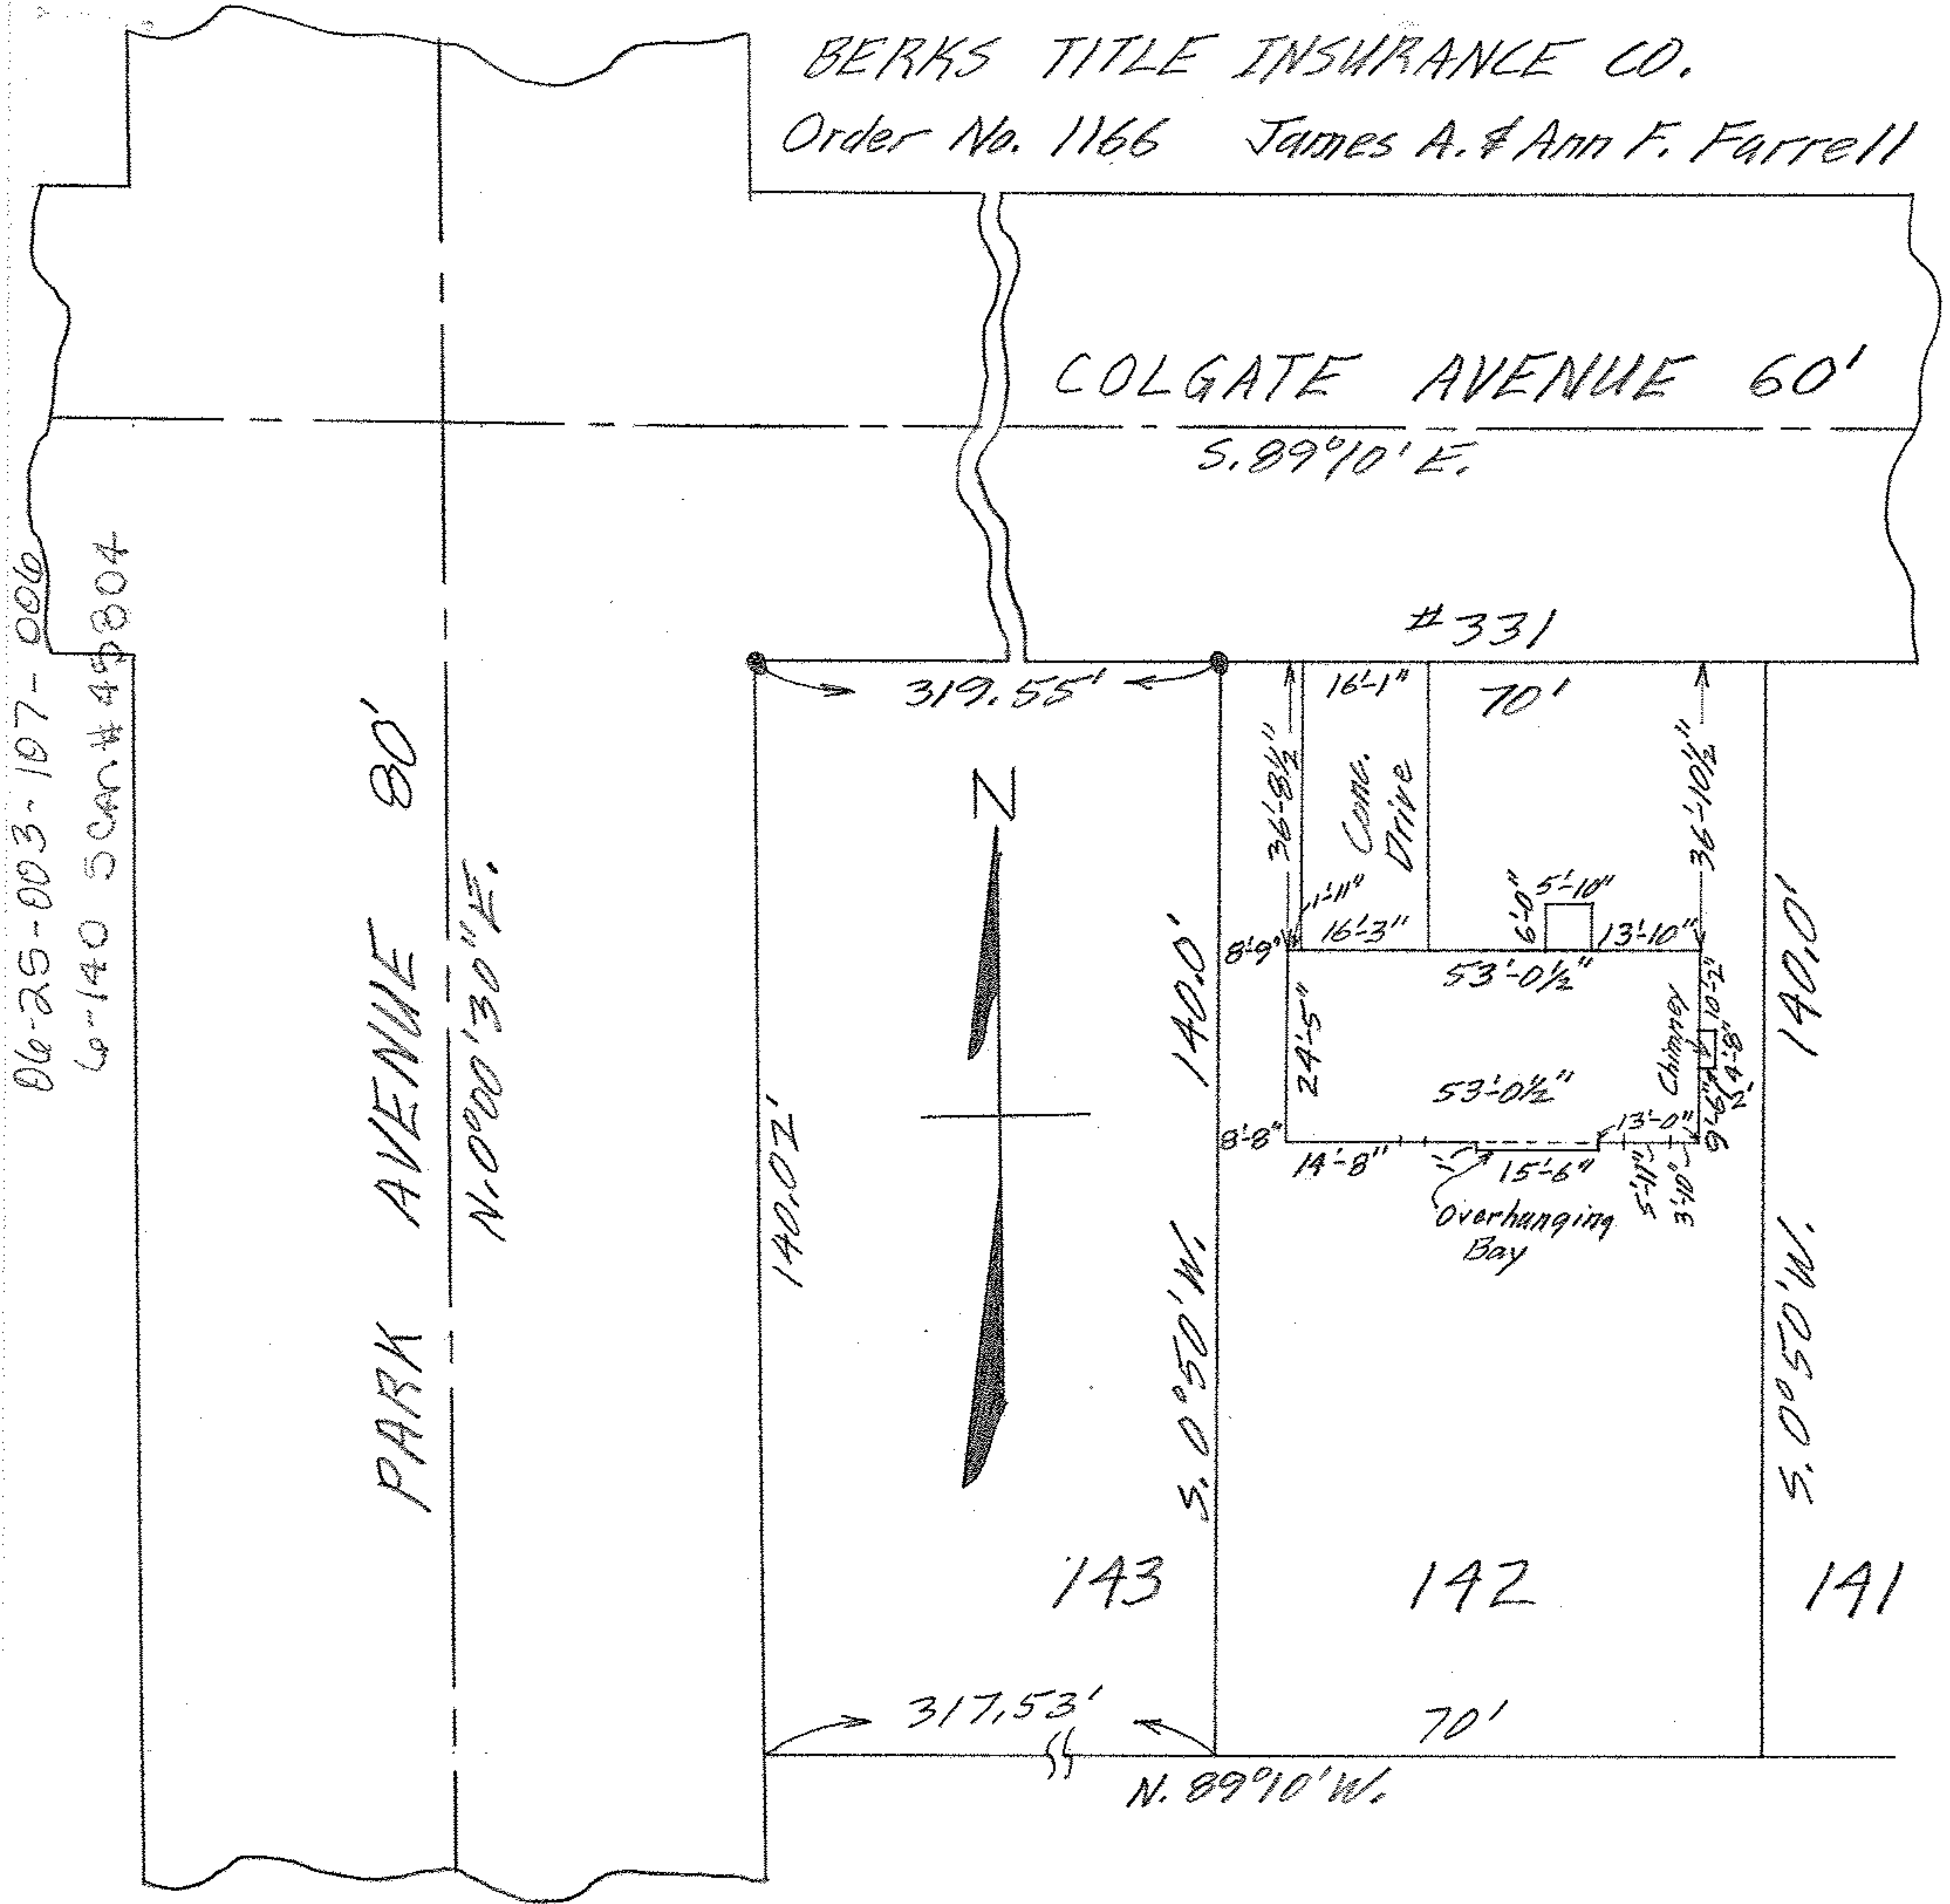

06-25-003-107-000
6-140 SCAN #49804

MAP OF SUB-LOT No. 142 OF REVISED PLAT
UNIVERSITY HEIGHTS SUB'N NO. 2
VOL. 23 PG. 31 PLATS
O.L. 3 EAST OF BLACK RIVER ELYRIA TWP.
ELYRIA CITY - LORAIN COUNTY - OHIO
SCALE: 1"=30' APRIL 17, 1963 12:30 P.M.
Gary E. Penfound REG. SURVEYOR