
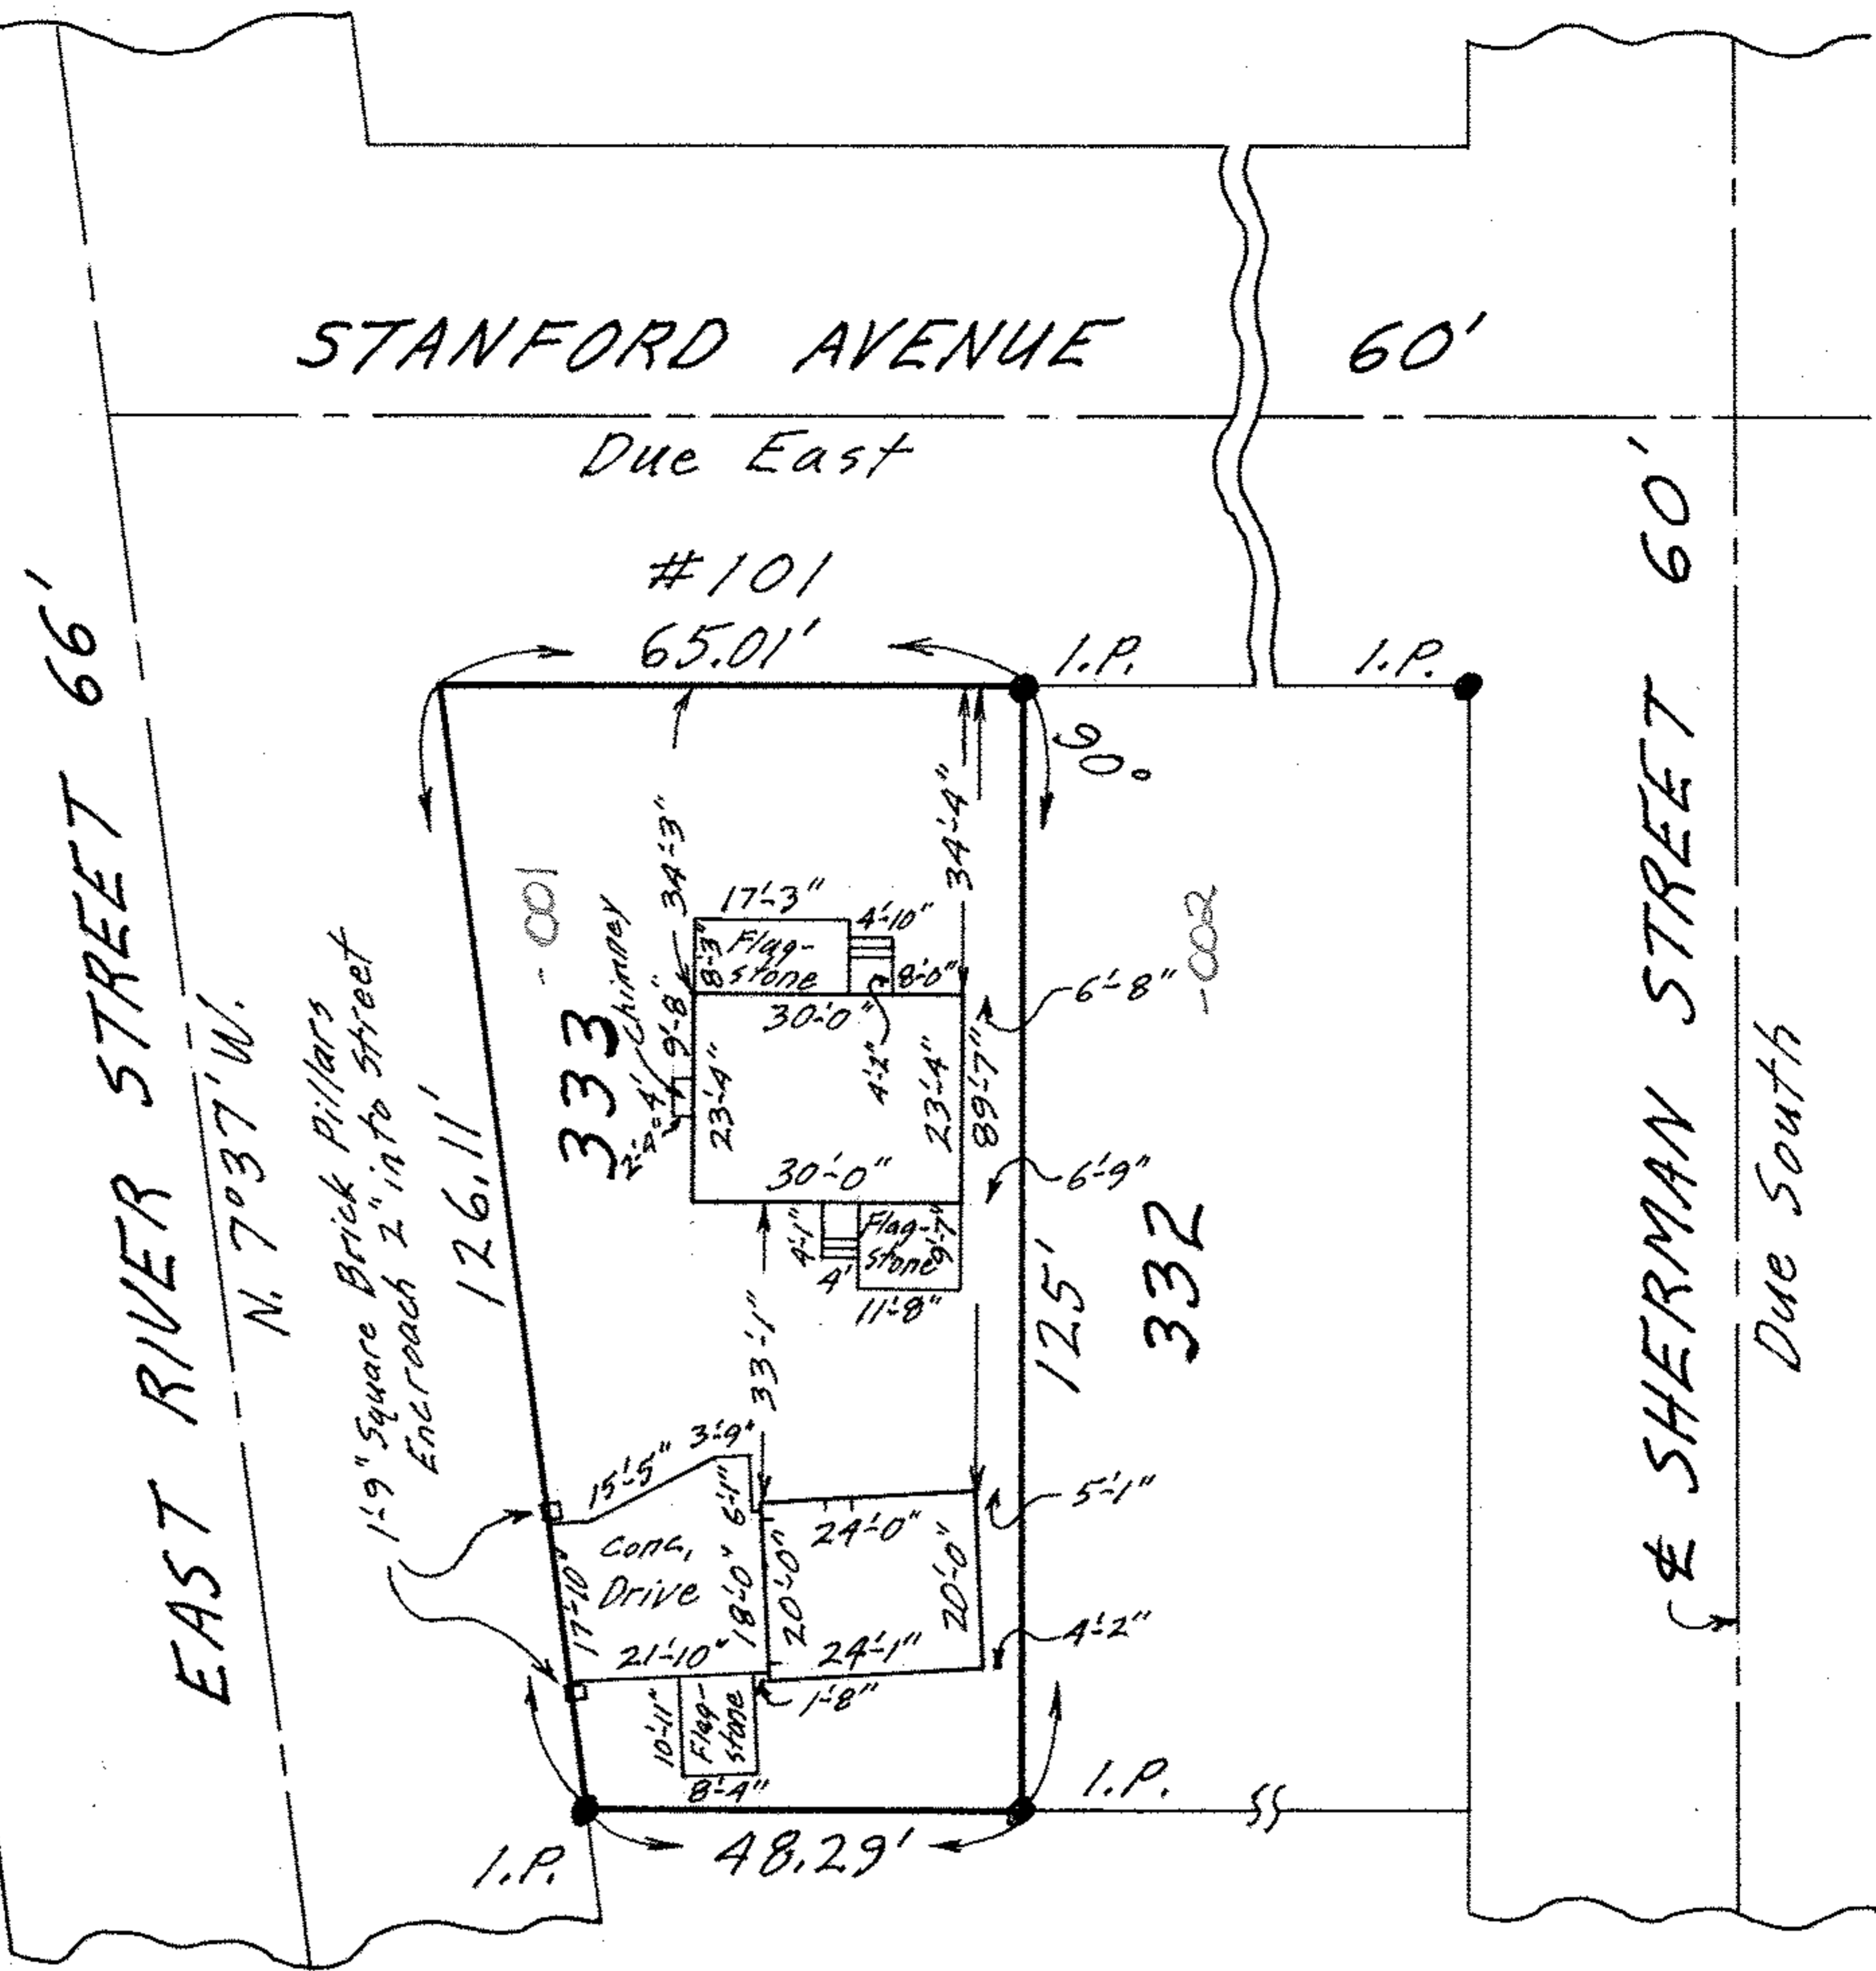


06-25-004-101-001, 002
6-139 SCAN # 45007

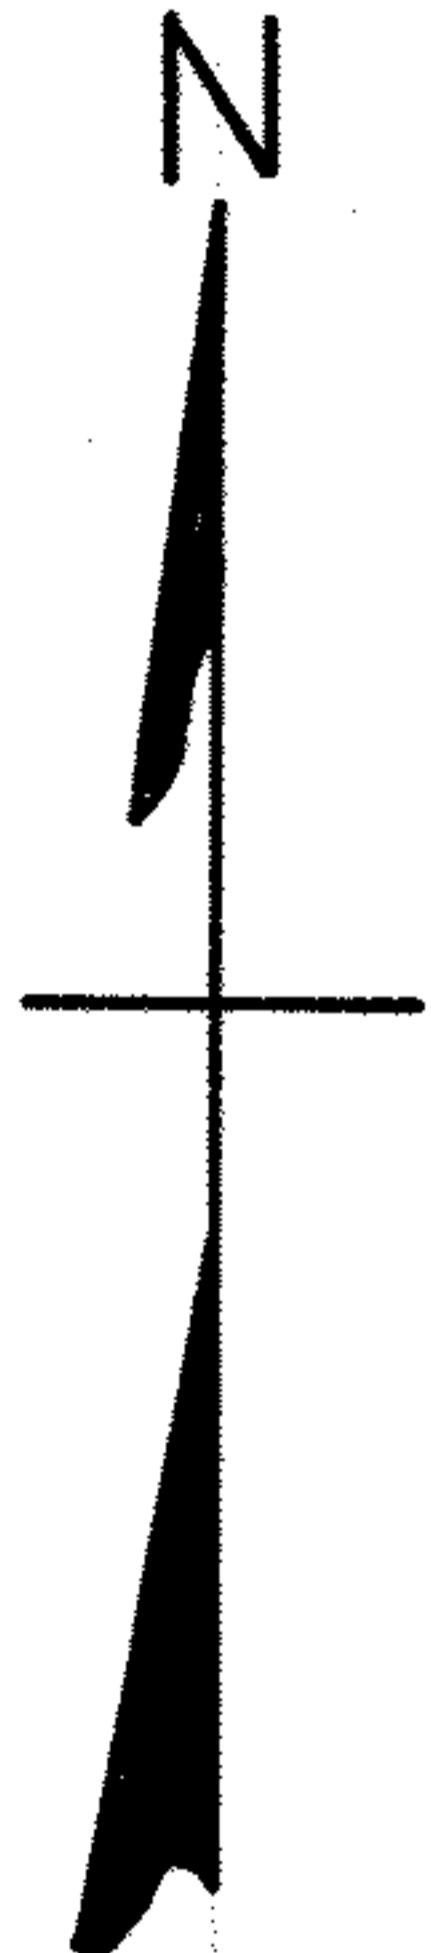

MAP OF SUB-LOT NO. 333
 THE EASTERN HEIGHTS LAND CO.'S SUB'N. NO. 7
 VOL. 9 PG. 29 PLAT RECORDS
 ORIG. LOTS 4 & 5, EAST OF RIVER, ELYRIA TWP.
 ELYRIA CITY - LORAIN COUNTY - OHIO
 SCALE: 1" = 30' MAY 26-1971 7:00 P.M.
 NOTE: There are no encroachments onto this
 property.

Gary E. Penfound
 Reg. Surveyor No. 4957

THE TITLE INSURANCE
 COMPANY OF MINNESOTA

06-25-004-101-001, 002
 6-139 SCAN # 45007