

06-25-004-173-014

6-140

SEAN # 45812

PARK AVE. 80'

N-0° 0' 30" E.

VASSAR AVE. 60'

S-89° 59' 30" E.

323


243.0'

16'-5"

75'

35'-2"
conc. Drive

37'-1 1/2"

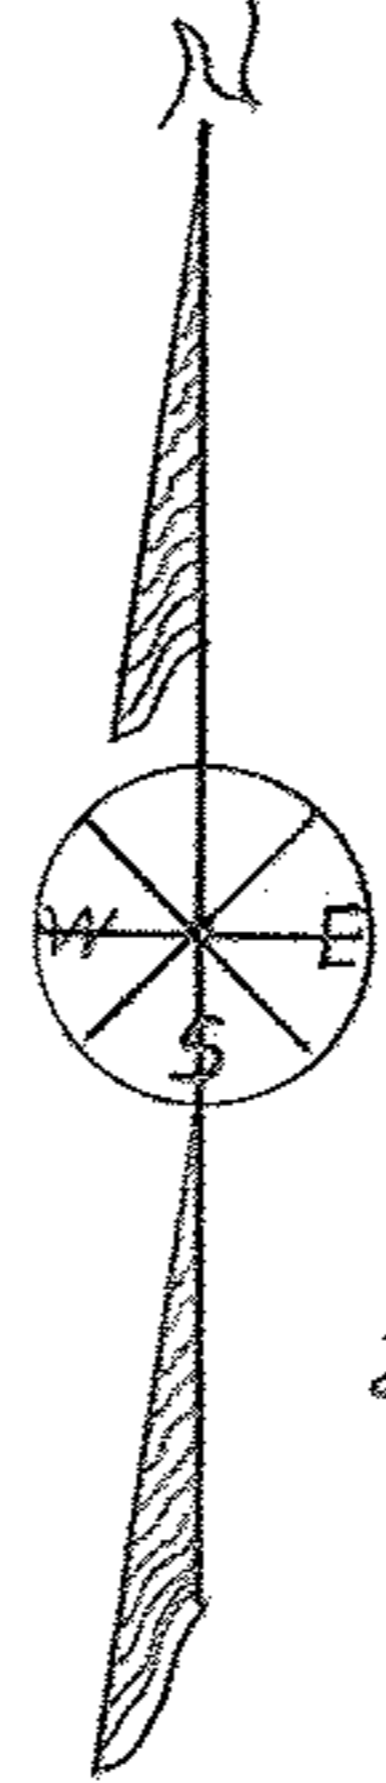

138.65'

13'-10"

36'-0"

19'-6 1/2"

16'-4"

19'-6"

6'-0"

18'-0"

6'-0"

6'-0"

34'-2"

63'-0"

12'-0"

16'-0"

14'-6"

6'-1"

139.73'

22

21

20

75.01'

S-89° 10' E.

MAP of SUB-LOT 21
 PLAS-MEYER ALL'T N^o 2 Vol. 22, P. 65
 PART of Orig LOT. 4 EAST of E. BRANCH of
 BLACK RIVER ELYRIA TOWNSHIP
 ELYRIA CITY LORAIN COUNTY-OHIO
 Scale: 1" = 30' APRIL 23, 1962 at 1:30 P.M.

Gary E. Penfound Reg. Surveyor