
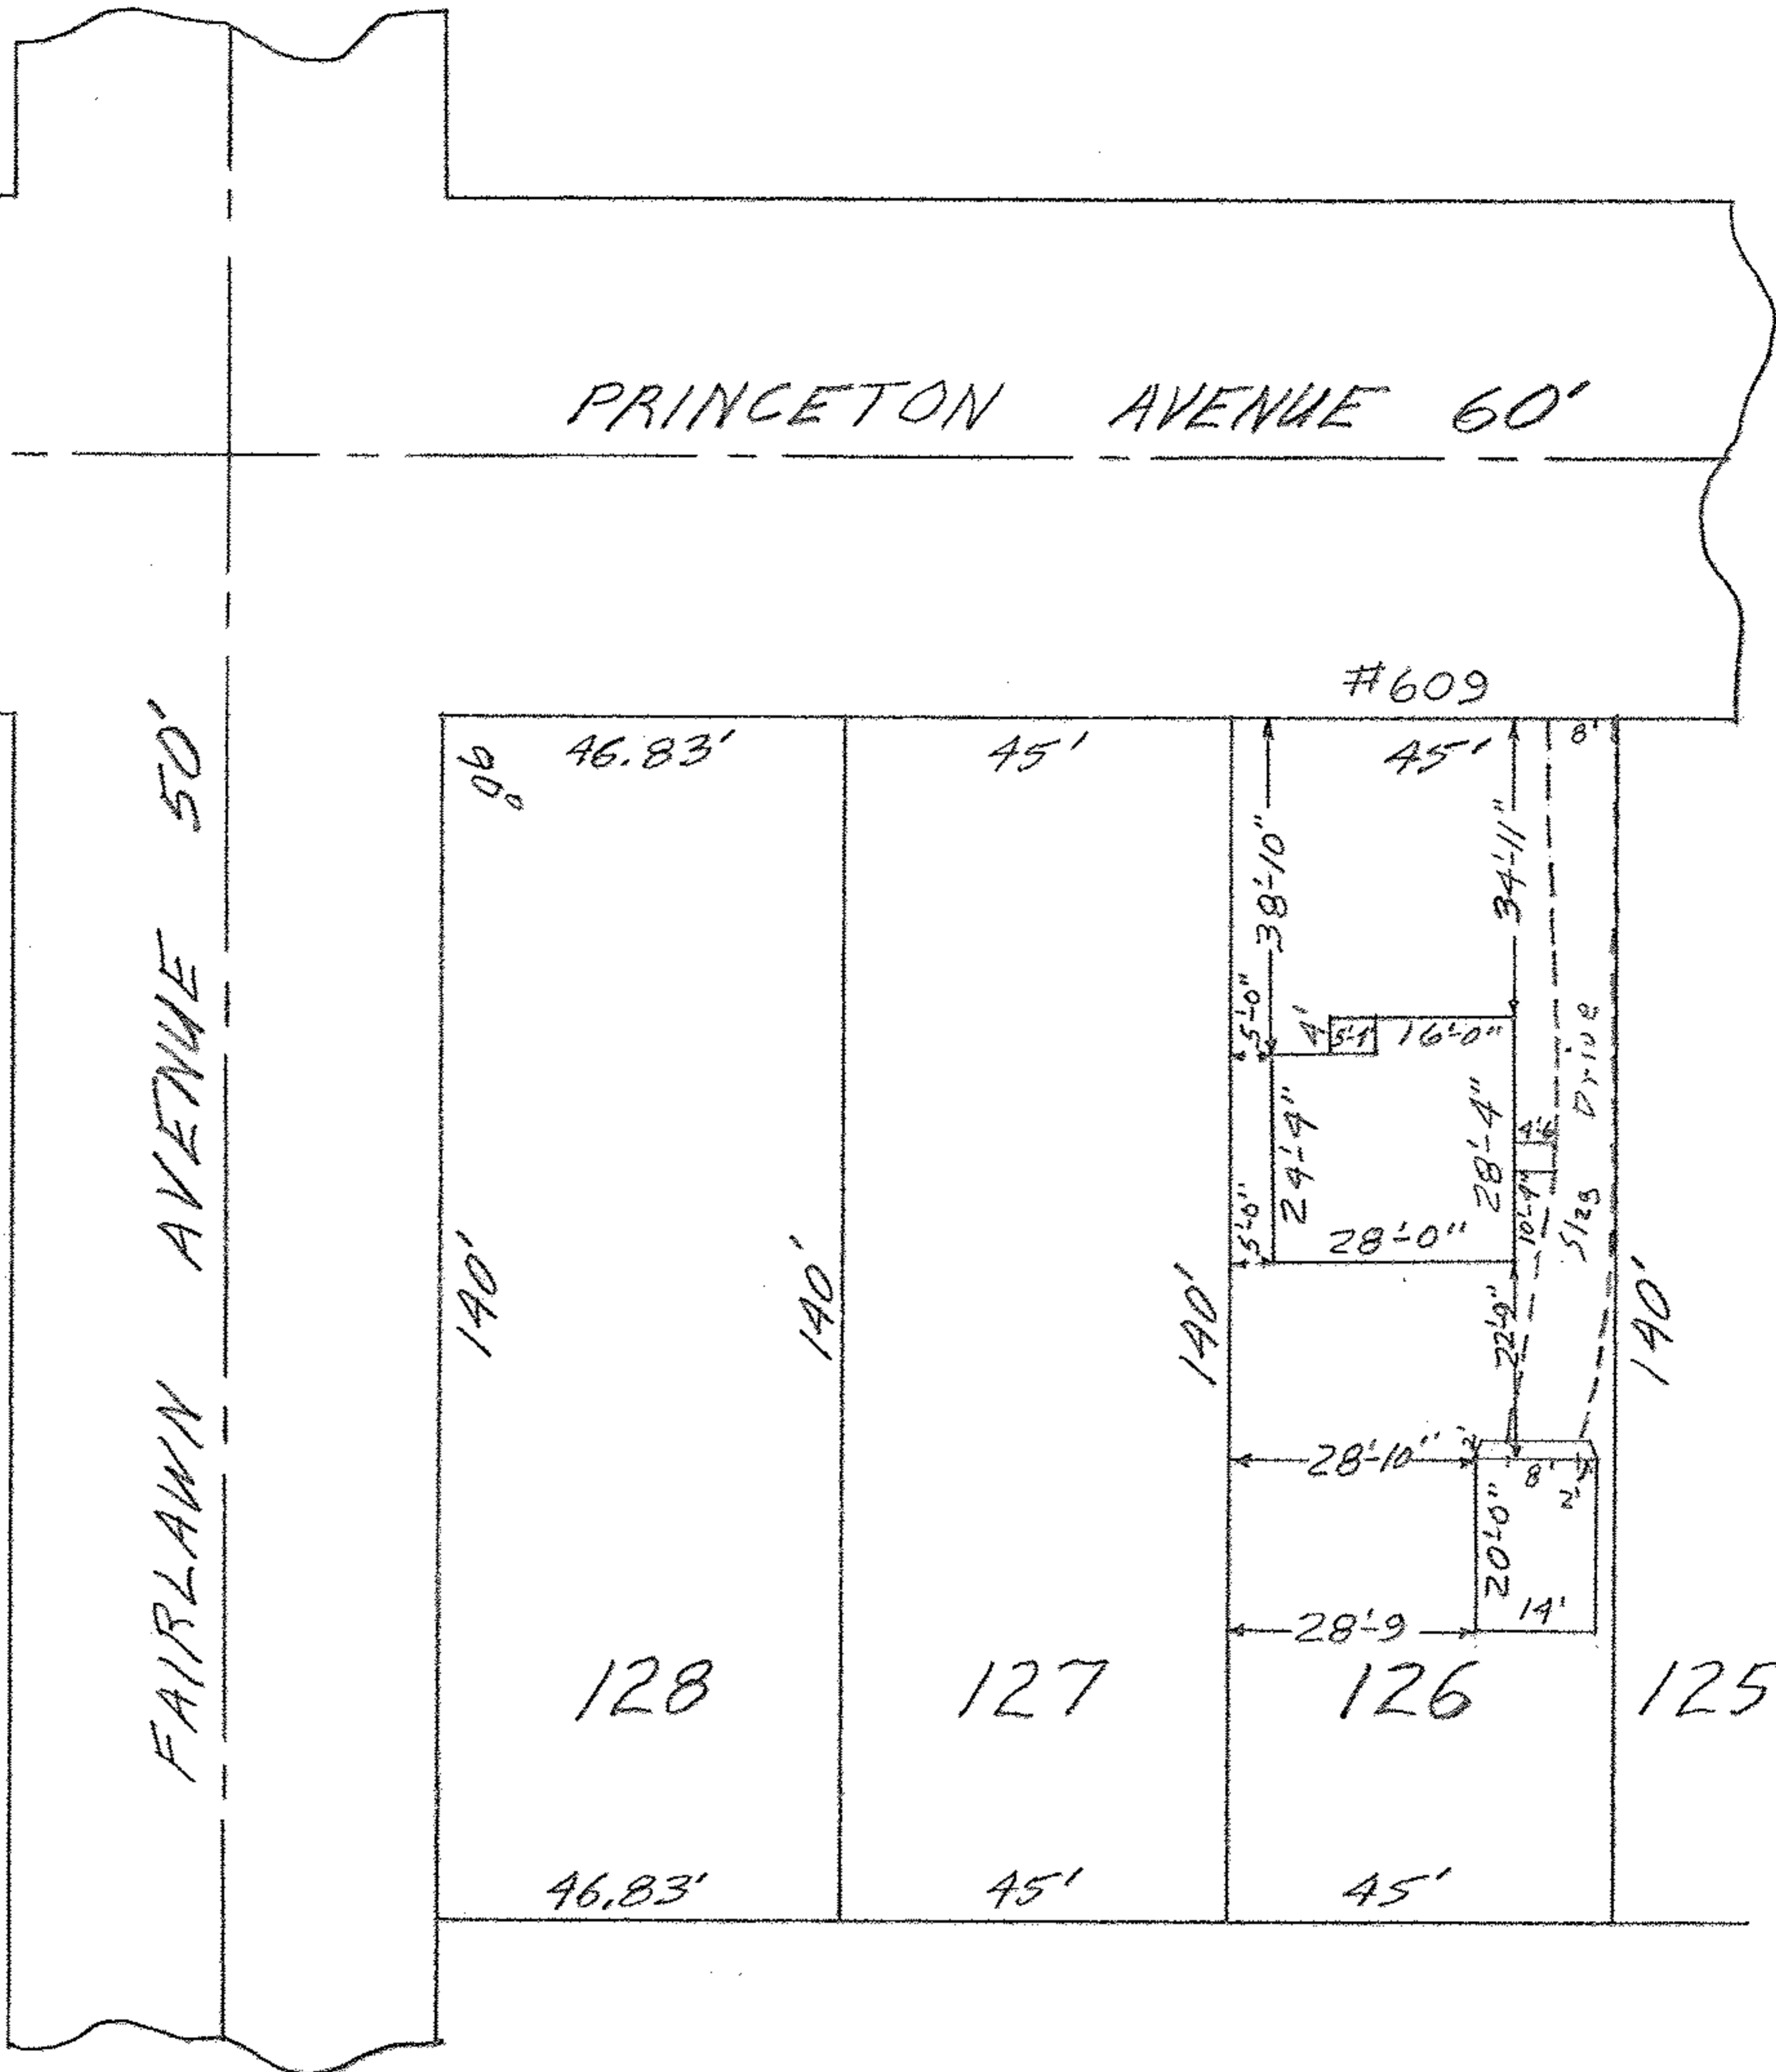


06-25-006-107-003, 002, 001

SCAN # 45819

U-123

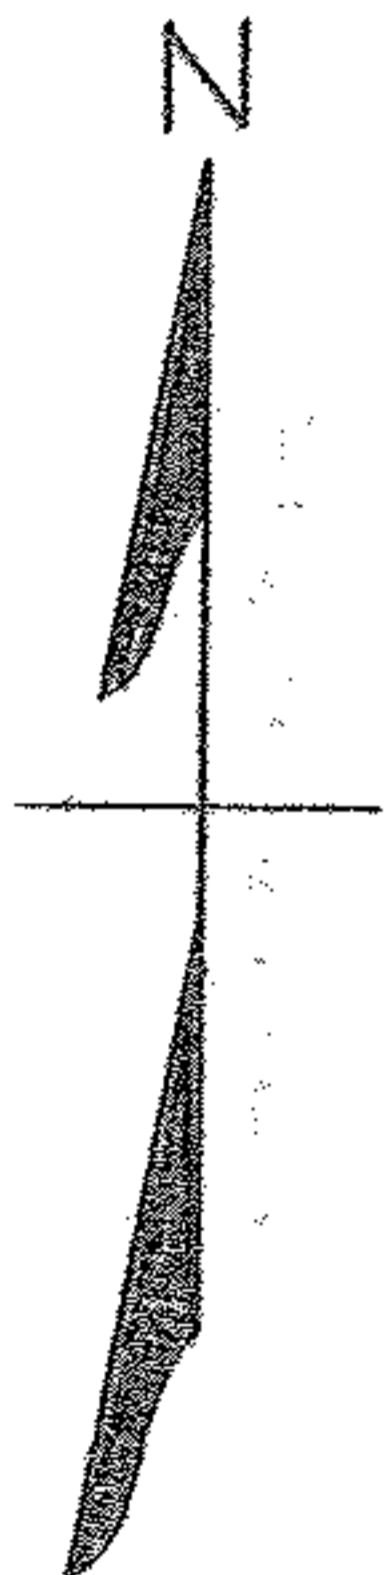

MAP OF SUB-LOT 126
 EAST BROAD STREET HEIGHTS ALL'T.
 VOL. 10 PG. 9 PLAT RECORDS
 ORIG. LOTS 6, 14, 15 & 16, EAST OF BLACK RIVER
 ELYRIA TWP. ELYRIA CITY
 LORAIN COUNTY OHIO
 SCALE: 1" = 30' JAN. 10-1961 11:30 A.M.

BERKS TITLE CO. Gary E. Perfound REG. SURVEYOR
 Rene A. & Joan E. Gonzalez