


06-25-000-115-005
SCAN # 45828

6'12.3

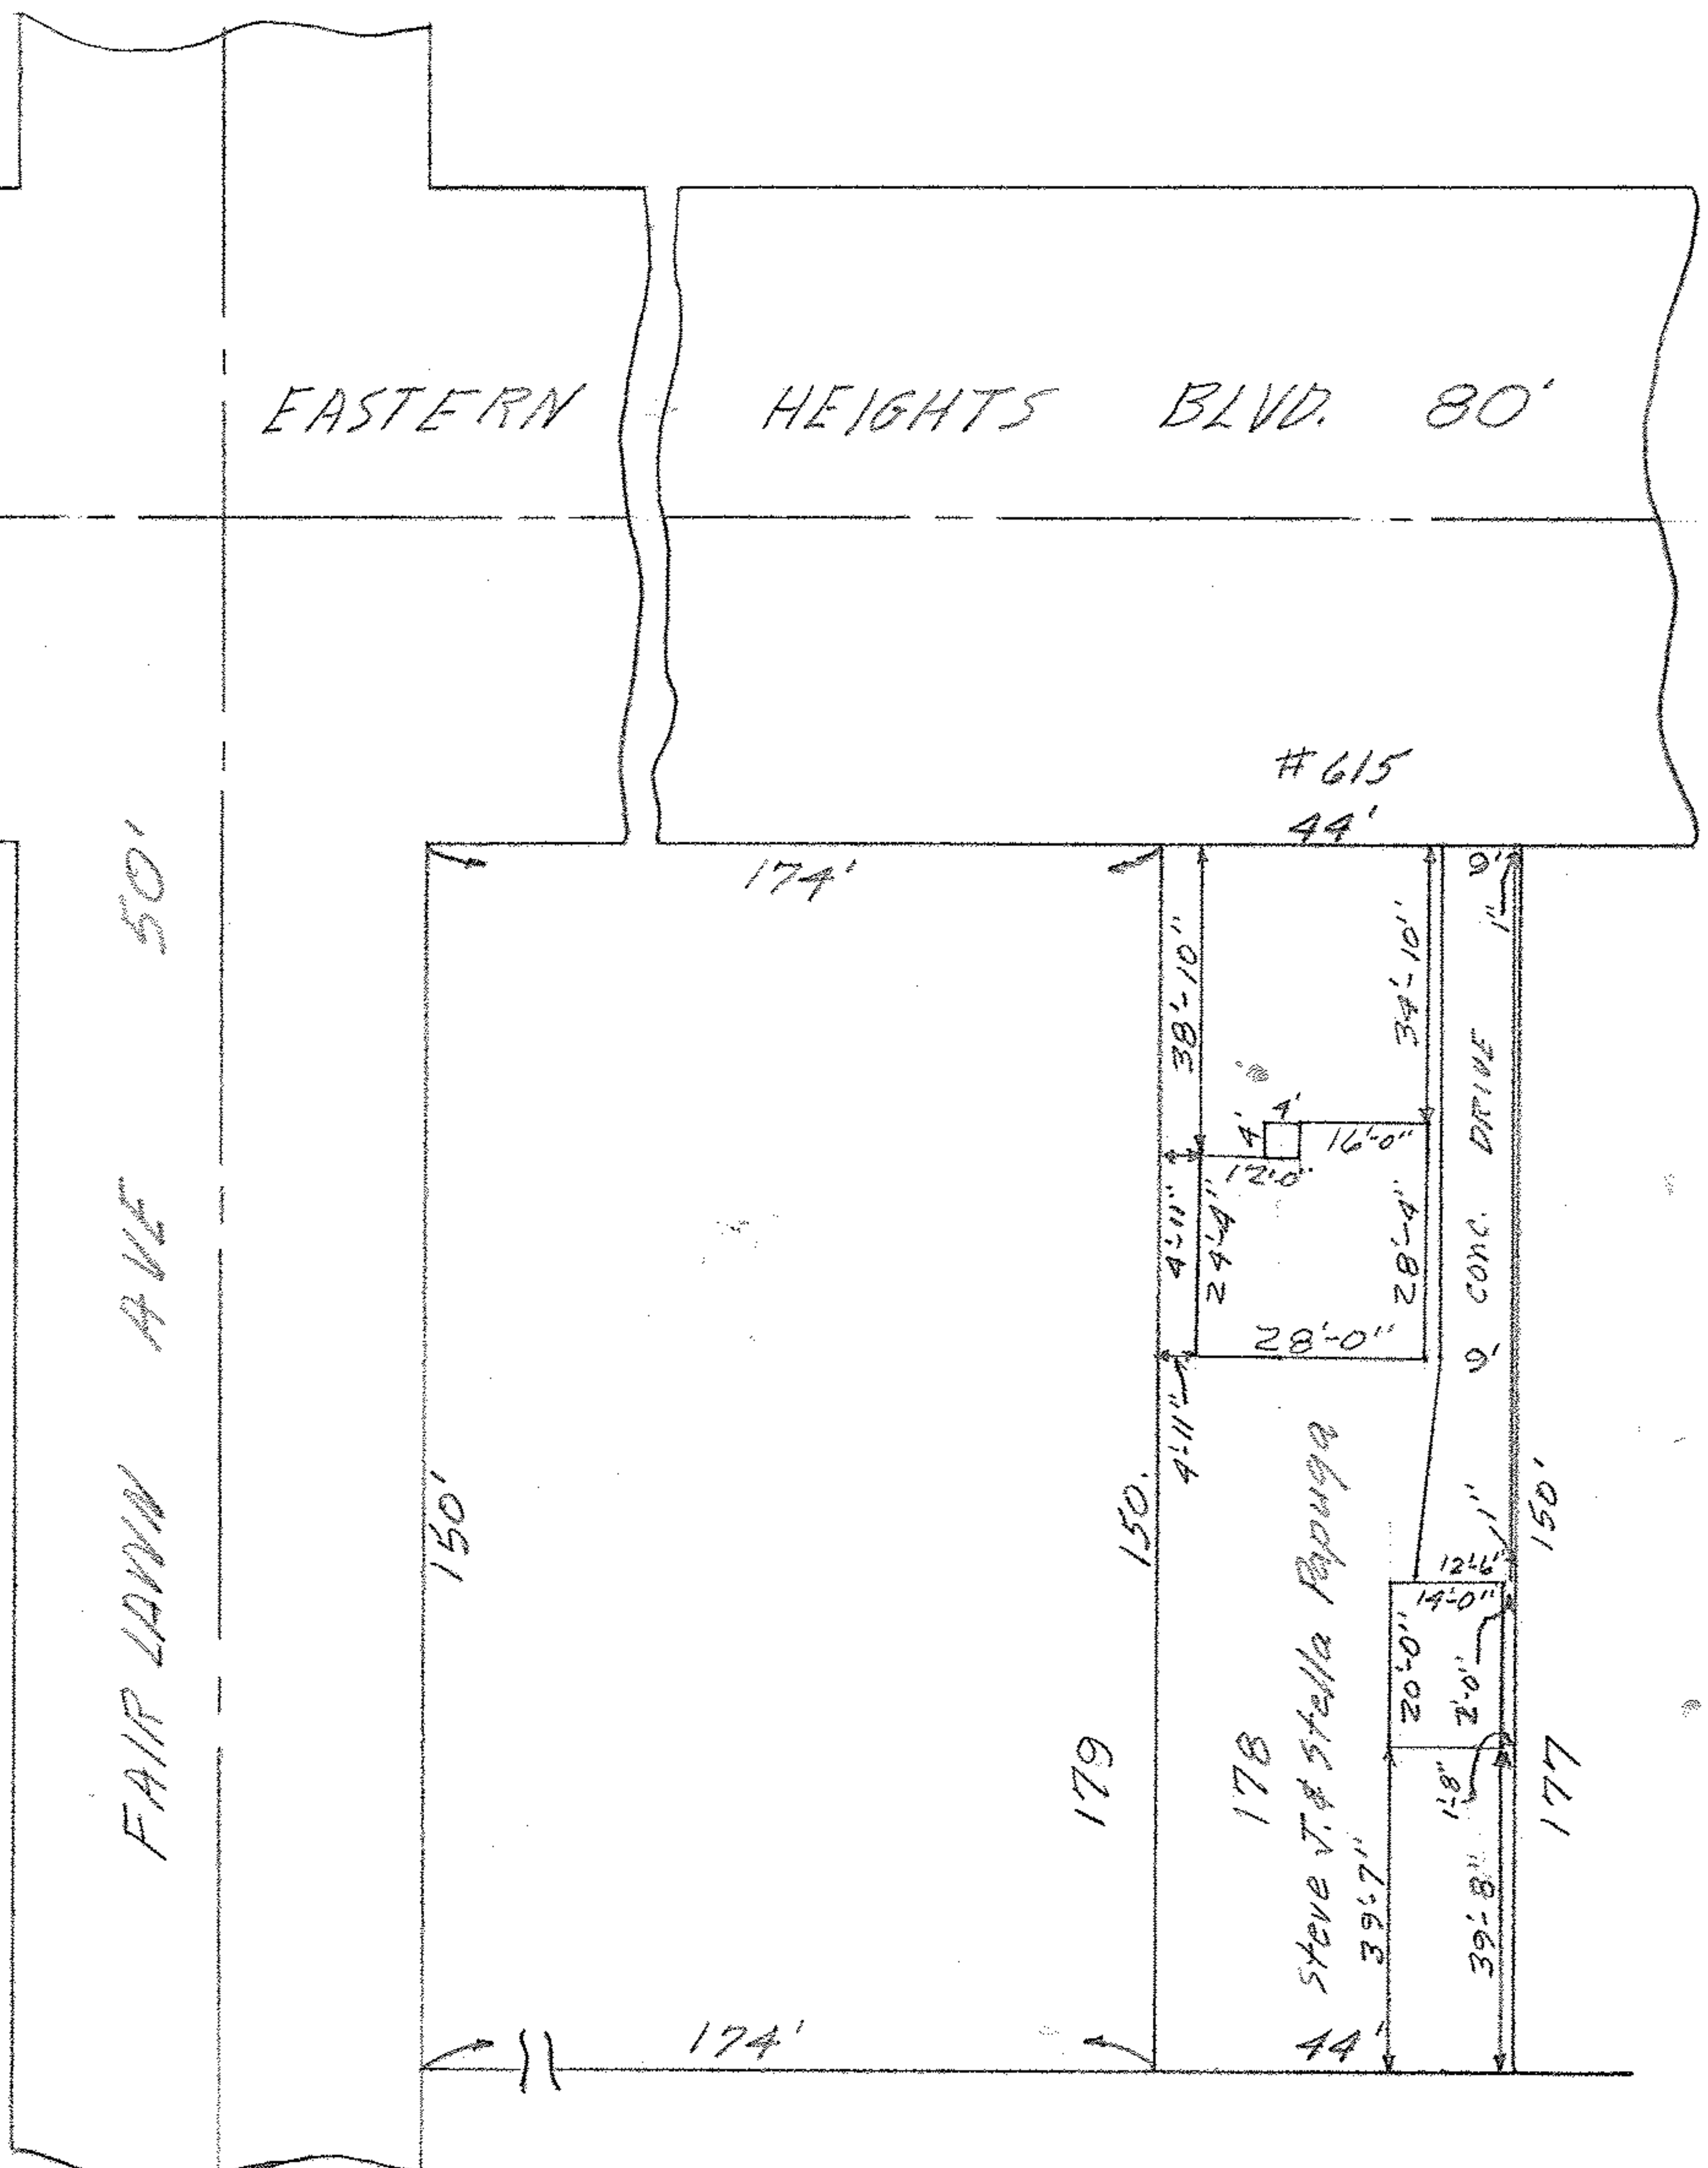

Made for and at the
 instance of the Ohio Bar
 Title Insurance Company
 and the Lorain County
 Savings & Trust Company.

MAP of SUB-LOT 178
 EAST BROAD ST HEIGHTS VOL. 10, P. 9
 ORIG. LOTS. 6, 14, 15, 16 EAST of RIVER
 ELYRIA TOWNSHIP ELYRIA CITY
 LORAIN COUNTY - OHIO
 Scale: 1" = 30' MARCH 23, 1959 10:30 AM

Mary E. Penfound REG. SURVEYOR WW