


06-25-006-118-013
6-124
Scan # 45831

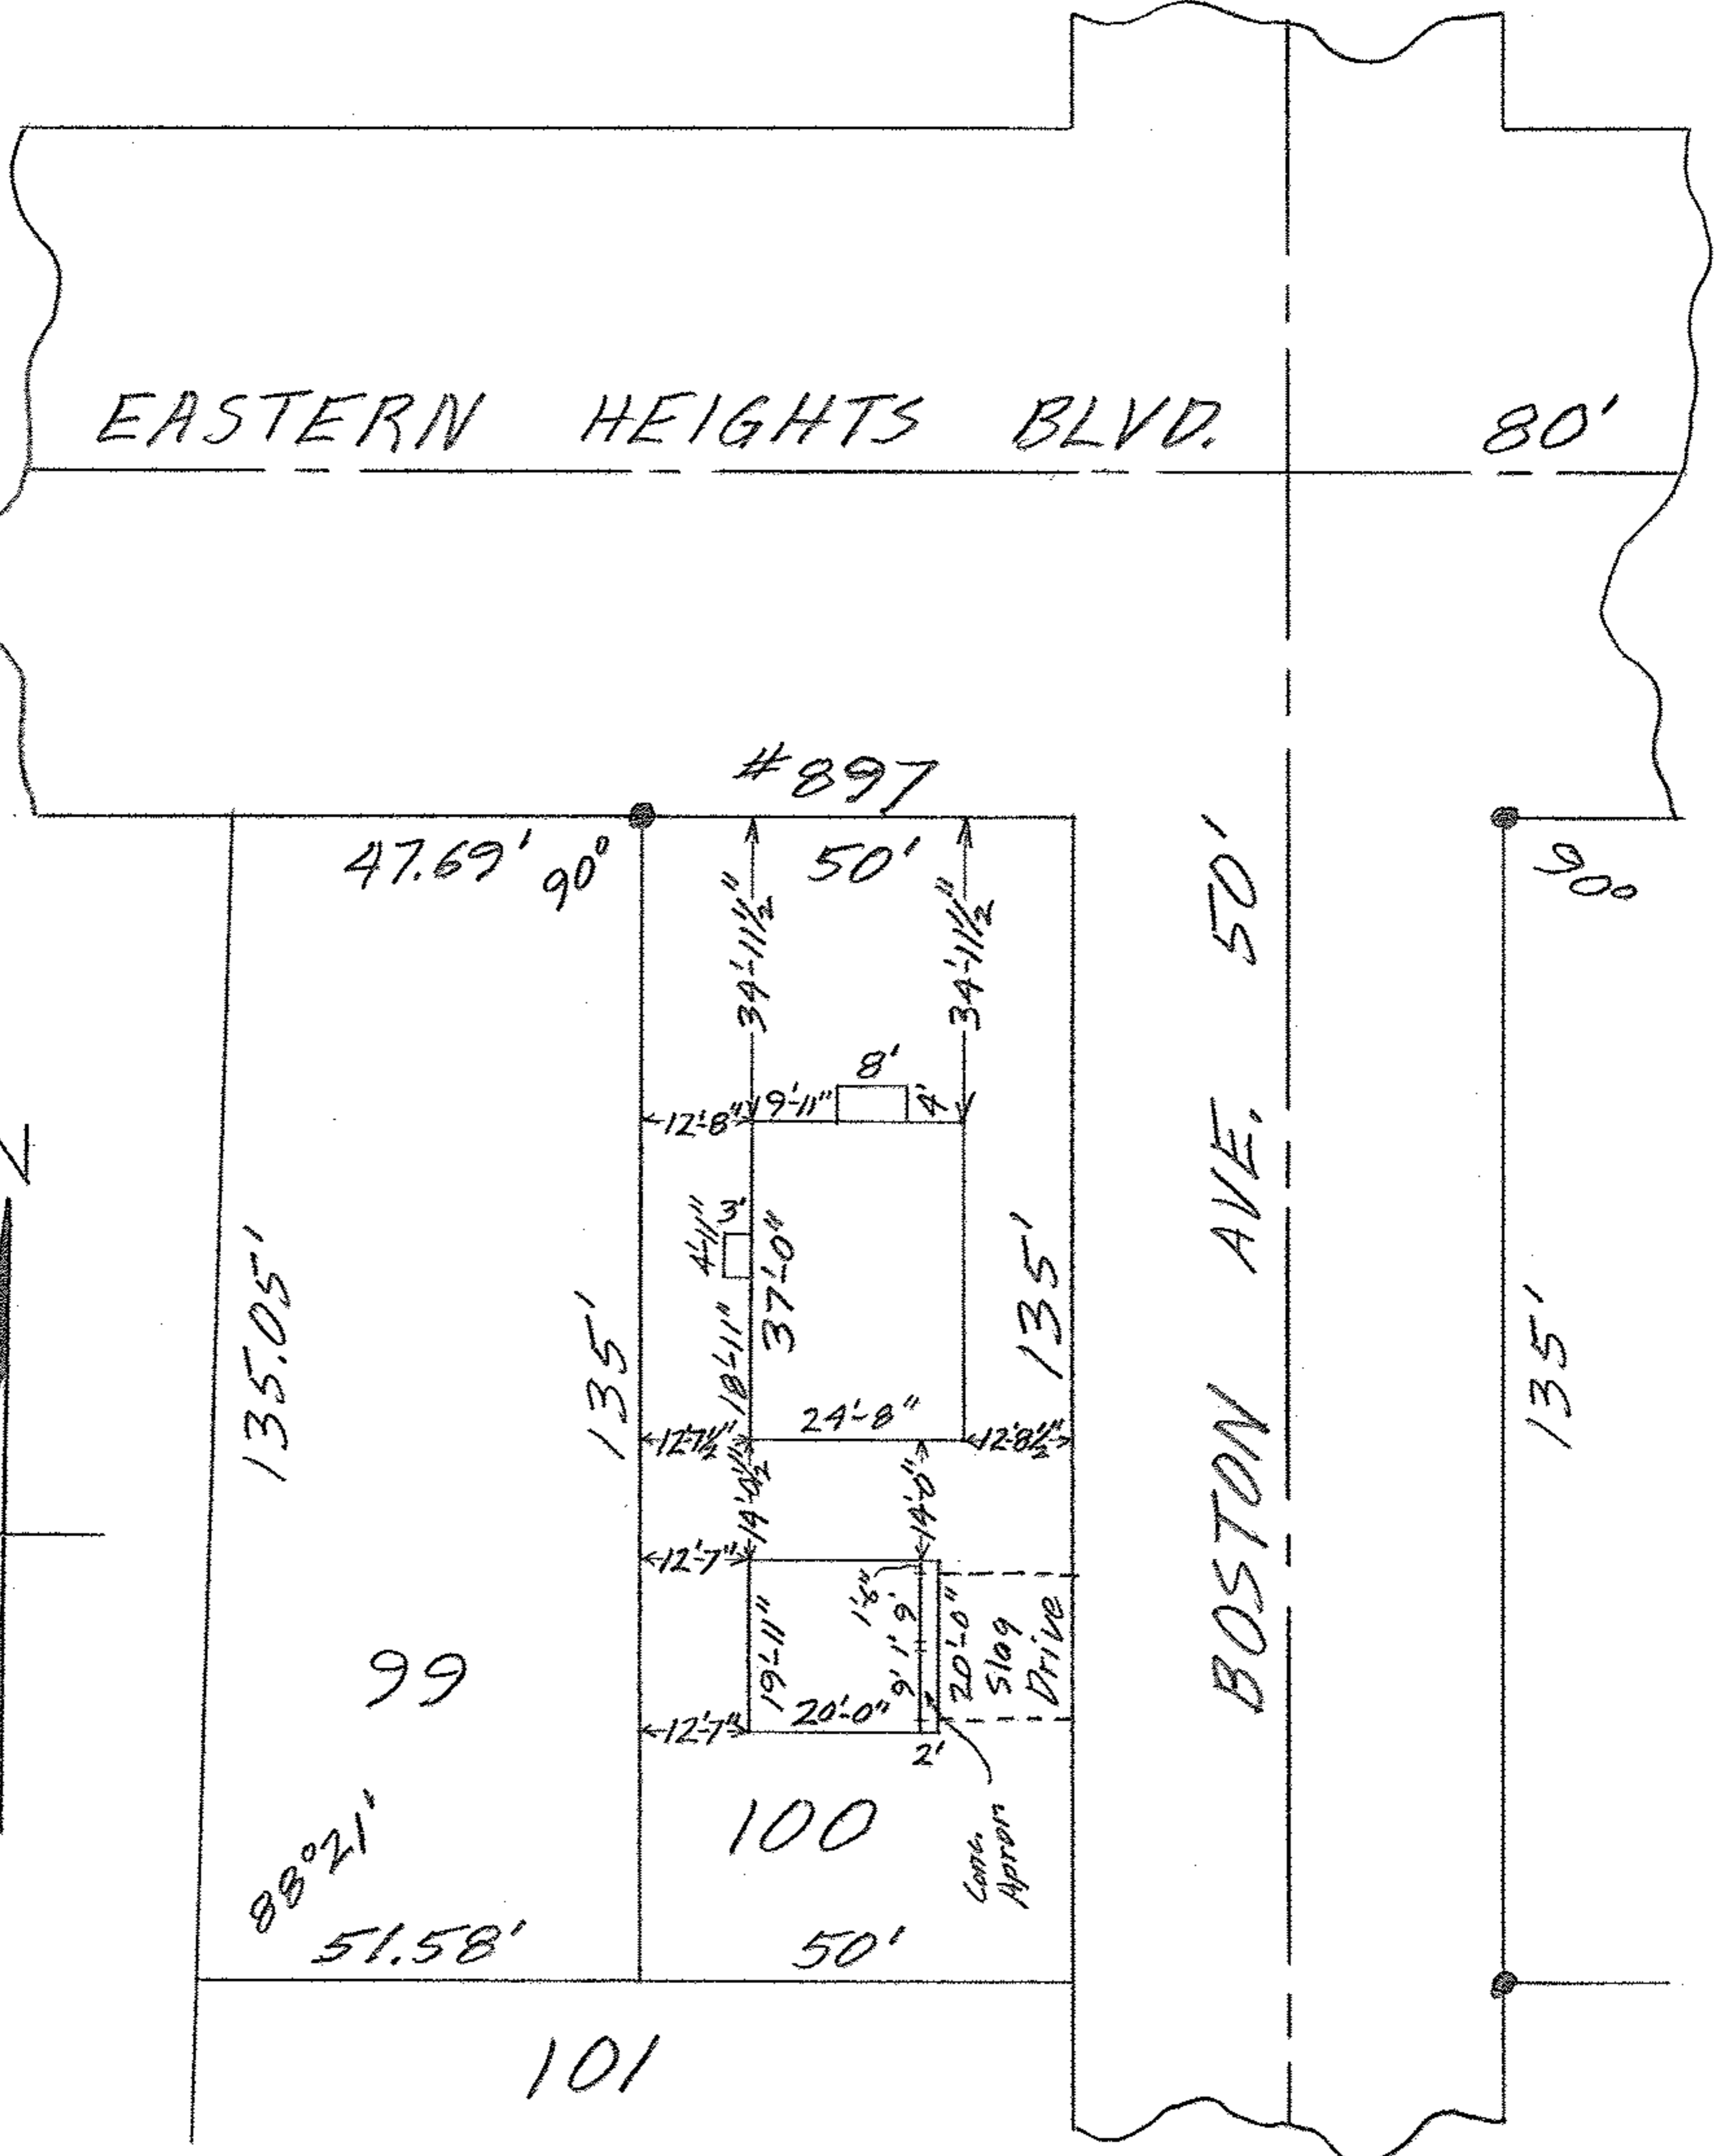

MAP OF SUB-LOT NO. 100

OVERLAND GARDENS ALL'T. Vol. 9 Pg. 32

ELYRIA TWP. - ELYRIA CITY

LORAIN COUNTY - OHIO

SCALE: 1" = 30' SEPT. 14 - 1963 5:15 P.M.

Gary E. Penfound REG. SURVEYOR