
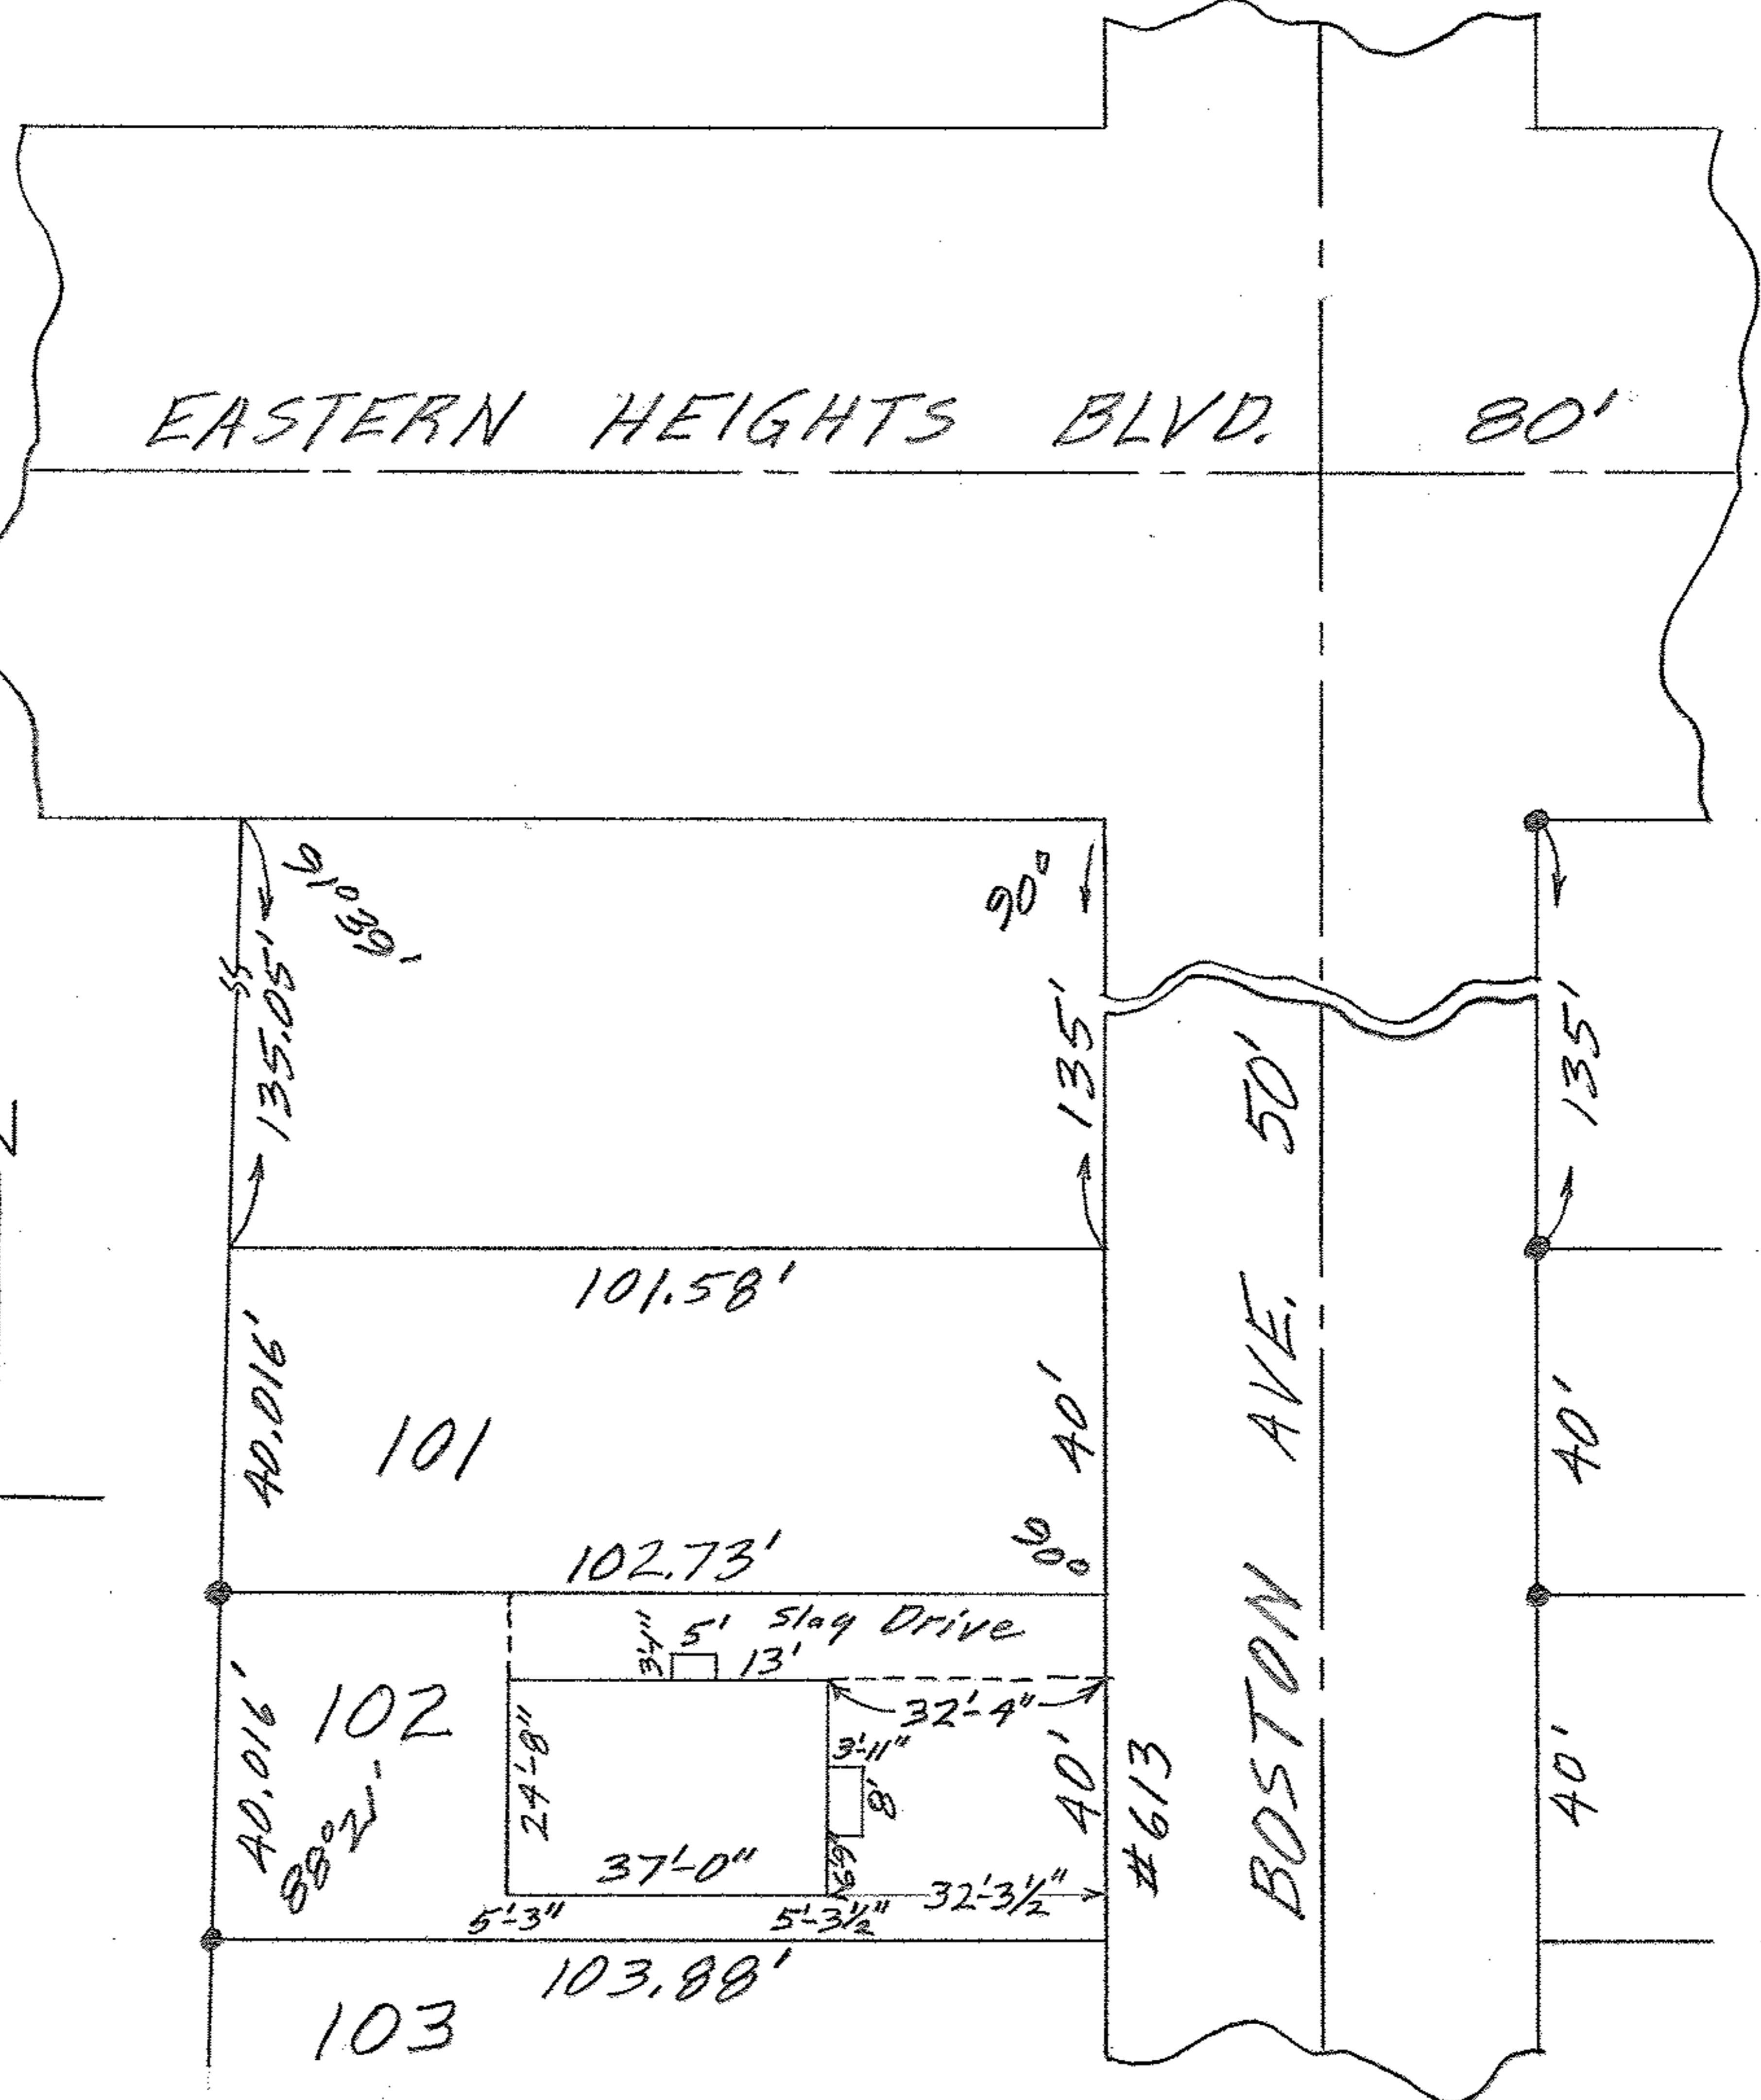


06-25-006-118-015
6-124
SCAN #458832

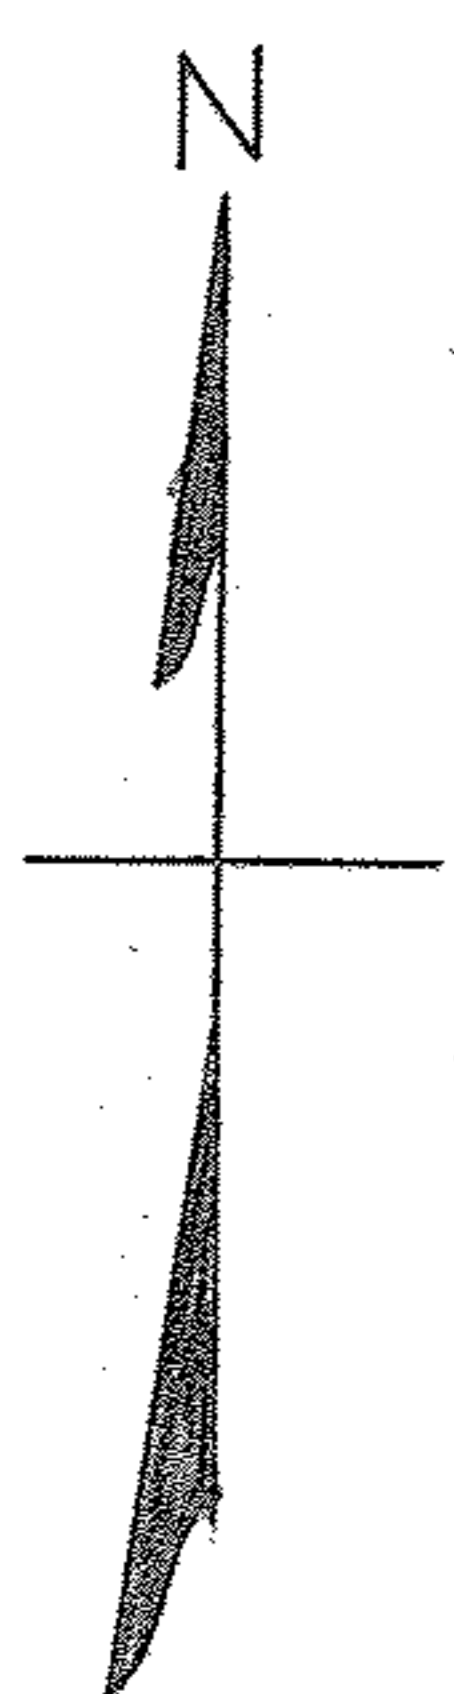

MAP OF SUB-LOT NO. 102
OVERLAND GARDENS ALL'T. Vol. 9 Pg. 32
ELYRIA TWP. - ELYRIA CITY
LORAIN COUNTY - OHIO
SCALE: 1" = 30' SEPT. 13-1963 5:00 P.M.
Gary E. Perford REG. SURVEYOR