

06-25-006-119-010

6-124  
SCAN# 45033

EASTERN HEIGHTS BLVD. 80'


BOSTON AVE. 50'

#612

154

153

152

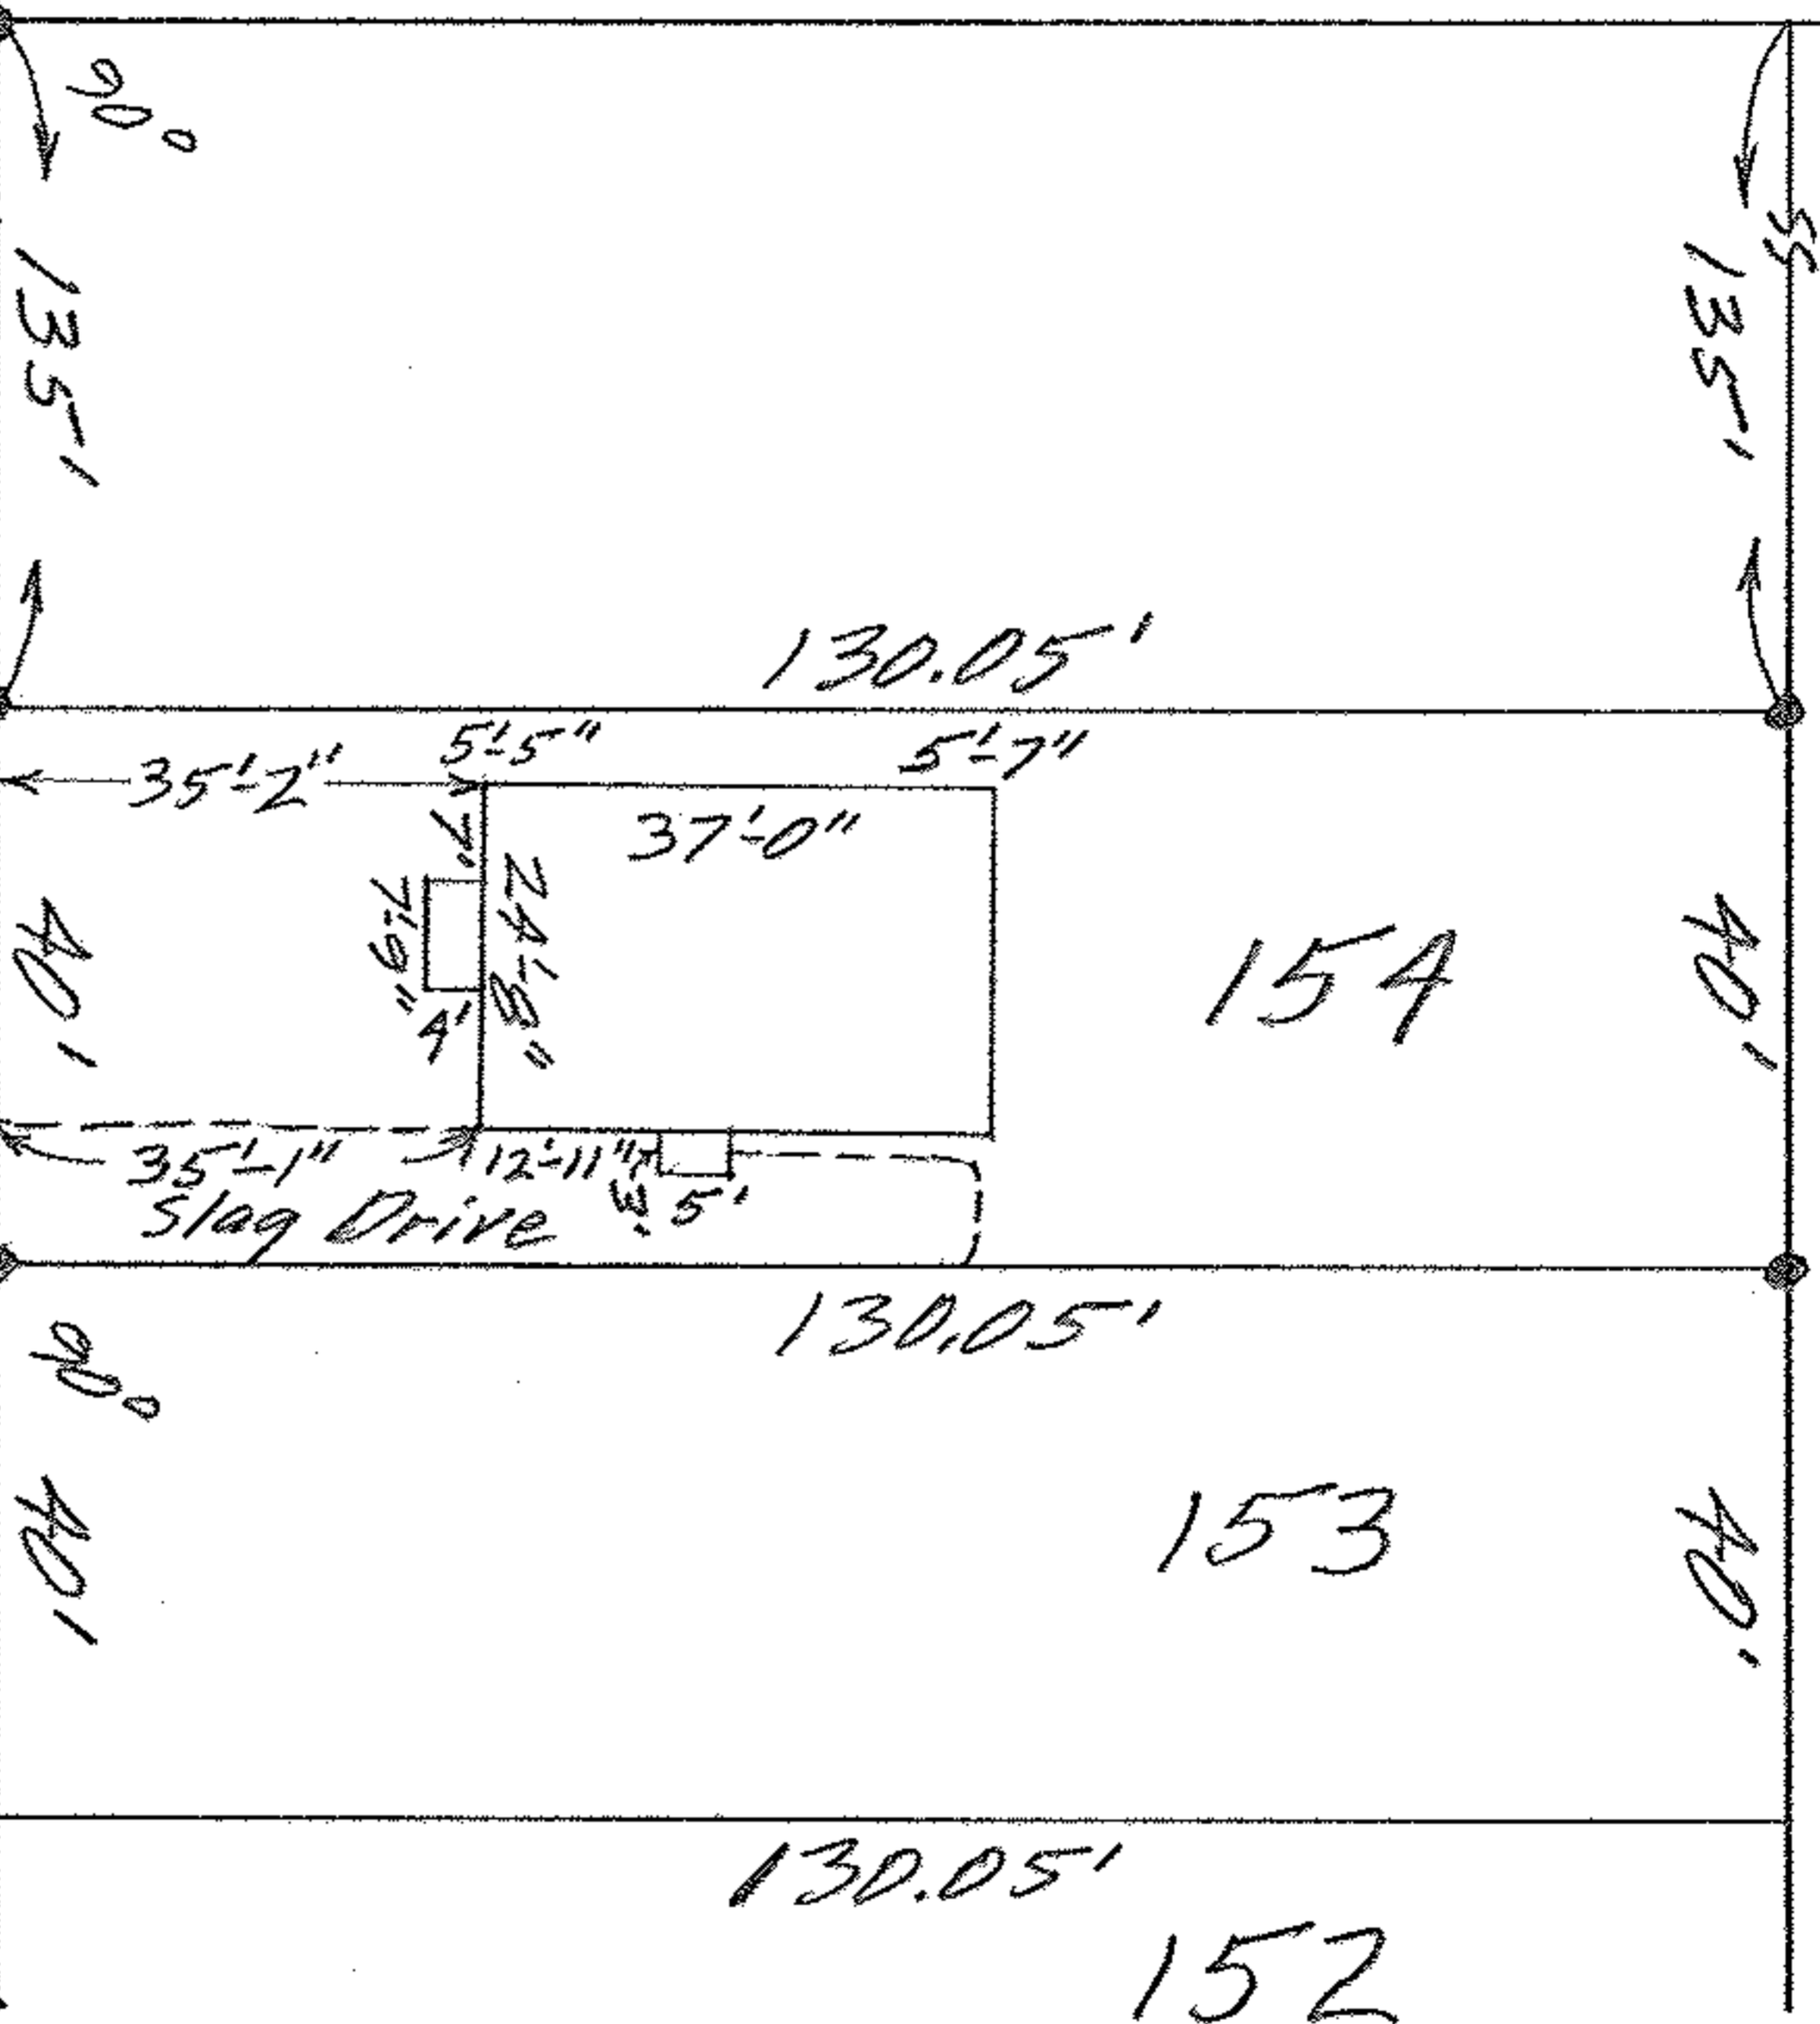

MAP OF SUB-LOT NO. 154

OVERLAND GARDENS ALL'T. VOL. 9 Pg. 32

ELYRIA TWP. ELYRIA CITY

LORAIN COUNTY OHIO

SCALE: 1" = 30' SEPT. 11-1963 5:30 P.M.

Gary E. Penfound REG. SURVEYOR