


06-25-013-007-045 → 047
 6-106
 SCAN# 45843

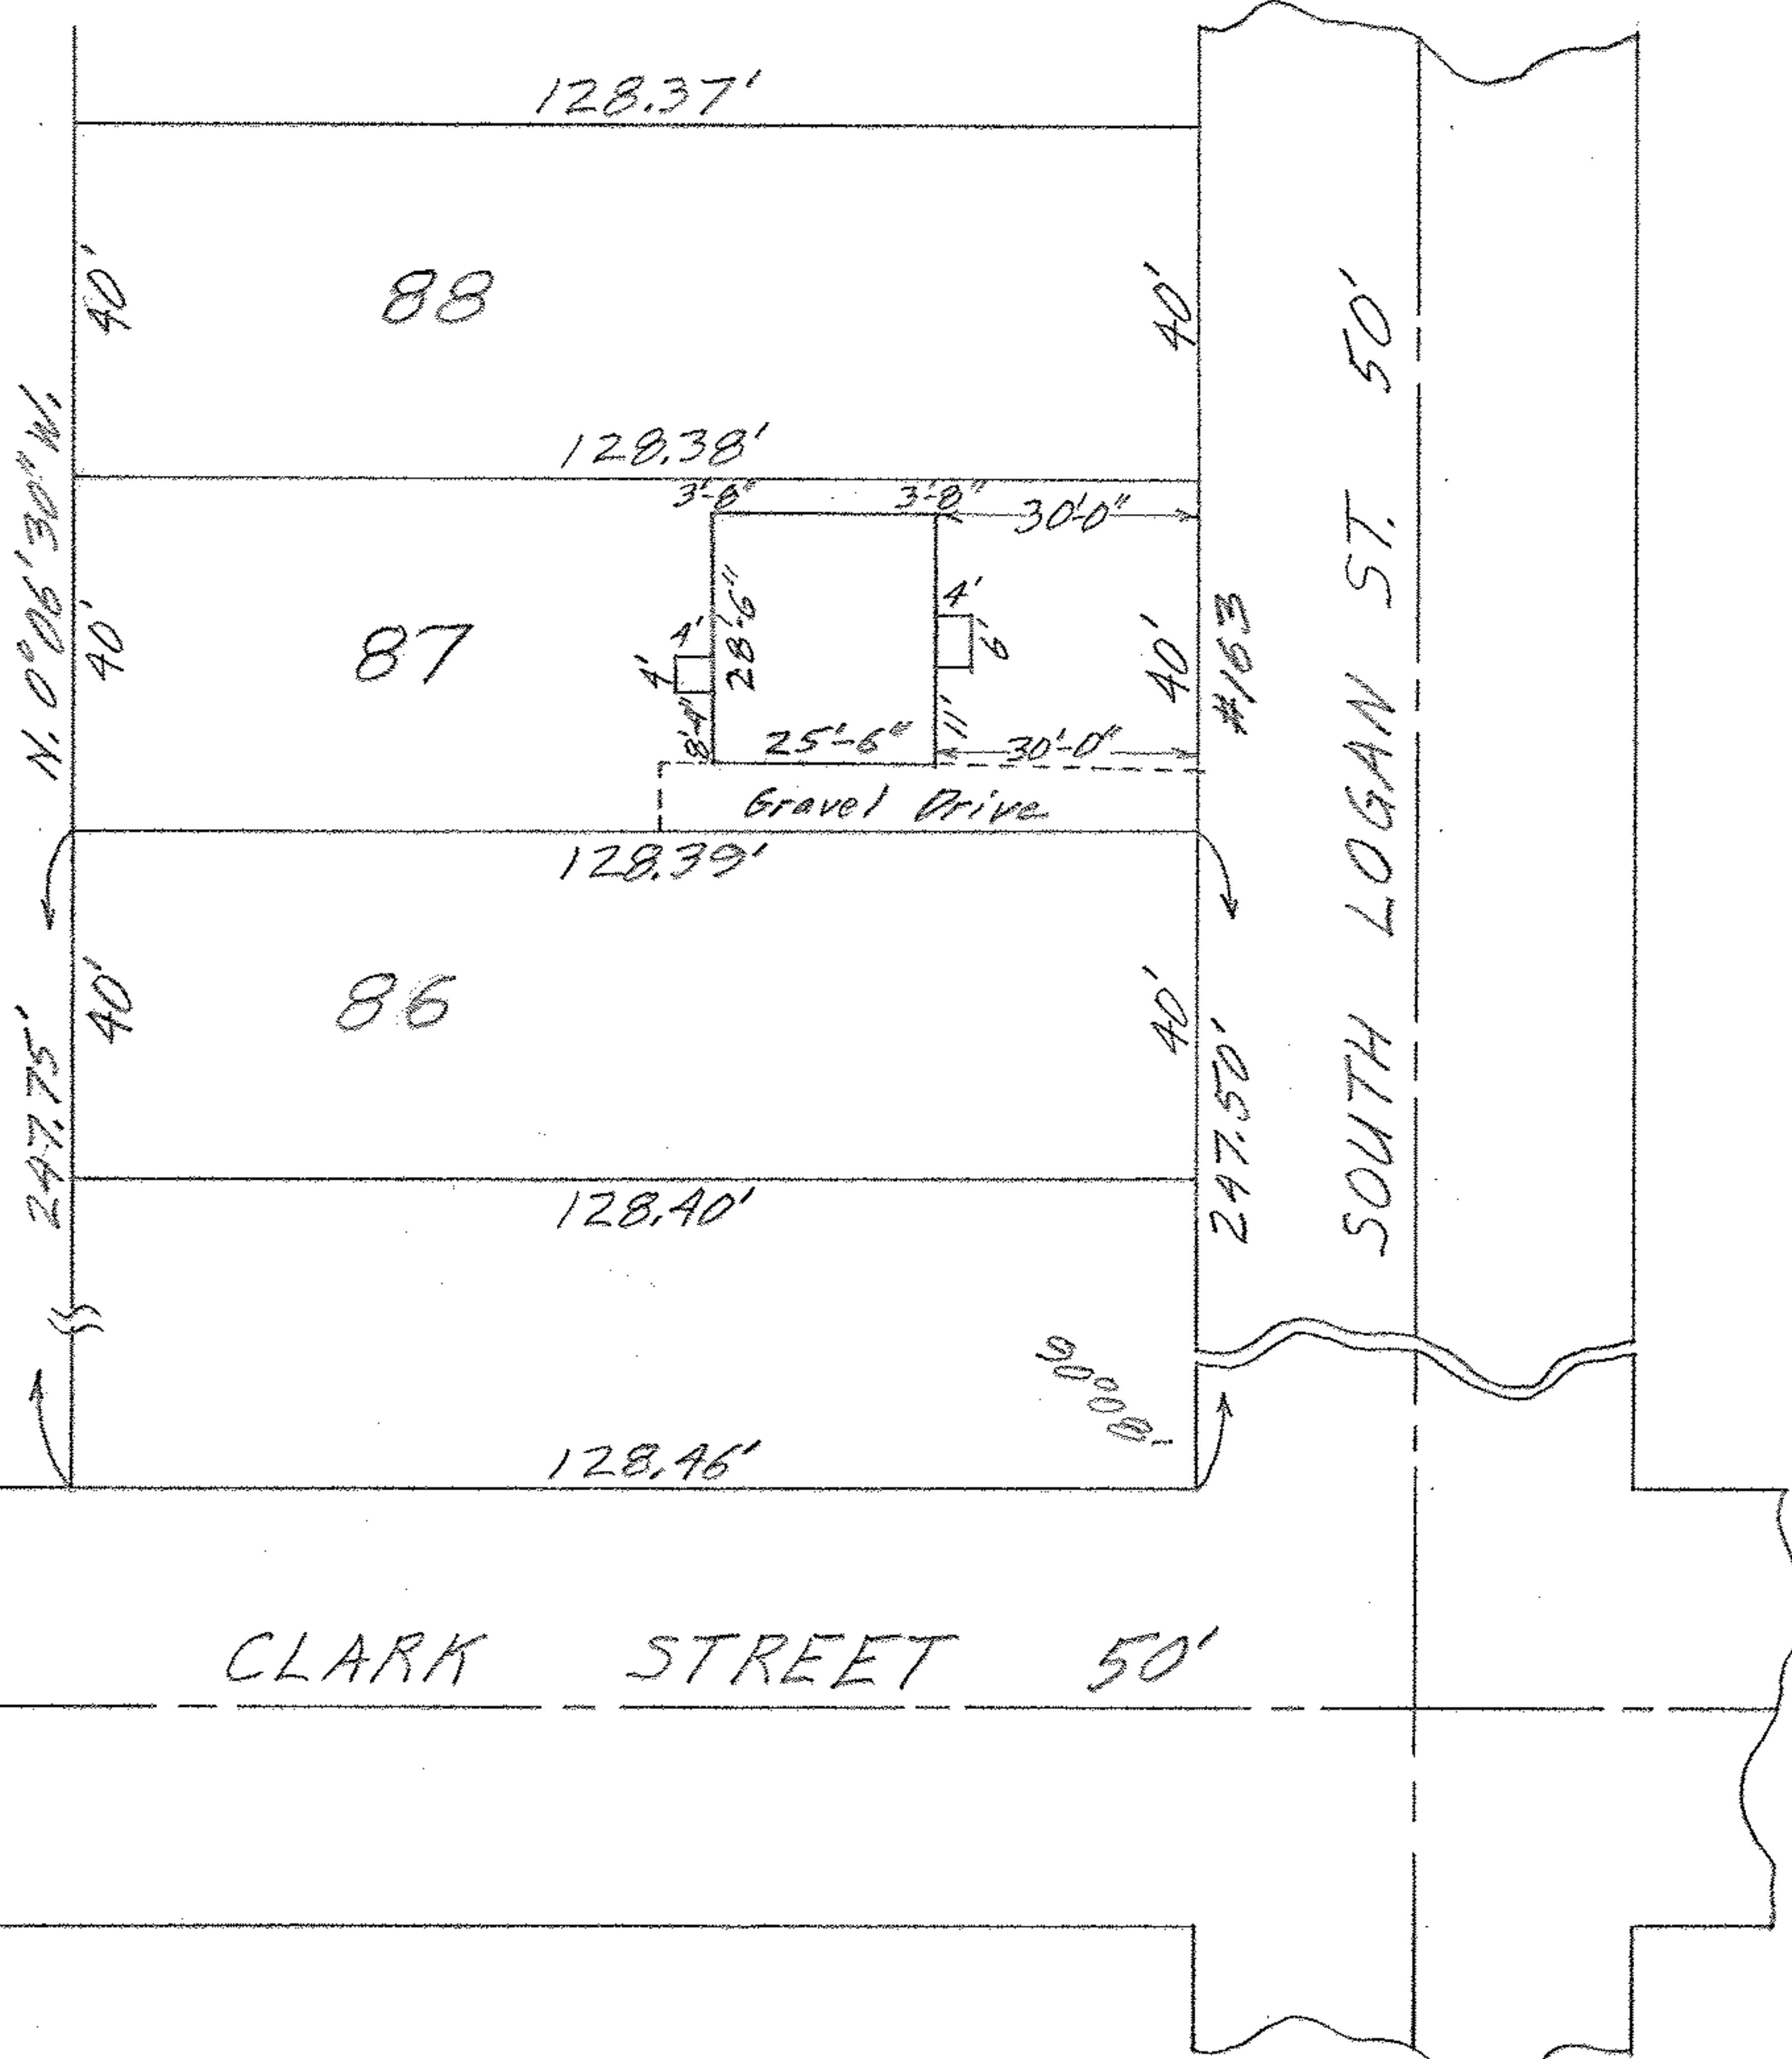

MAP OF SUB-LOT 87
 THE ELYRIA CHAMBER OF COMMERCE ALL'T.
 ORIG. LOT 13 - EAST OF RIVER - ELYRIA TWP.
 ELYRIA CITY - LORAIN COUNTY - OHIO
 SCALE: 1" = 30' SEPTEMBER 19-1961 9:30 A.M.
 Mary E. Penfound REG. SURVEYOR

WW