


6-106

06-25-013-106-001
SCAN # 45845

LACE STREET 50'

50'

BOSTON AVENUE

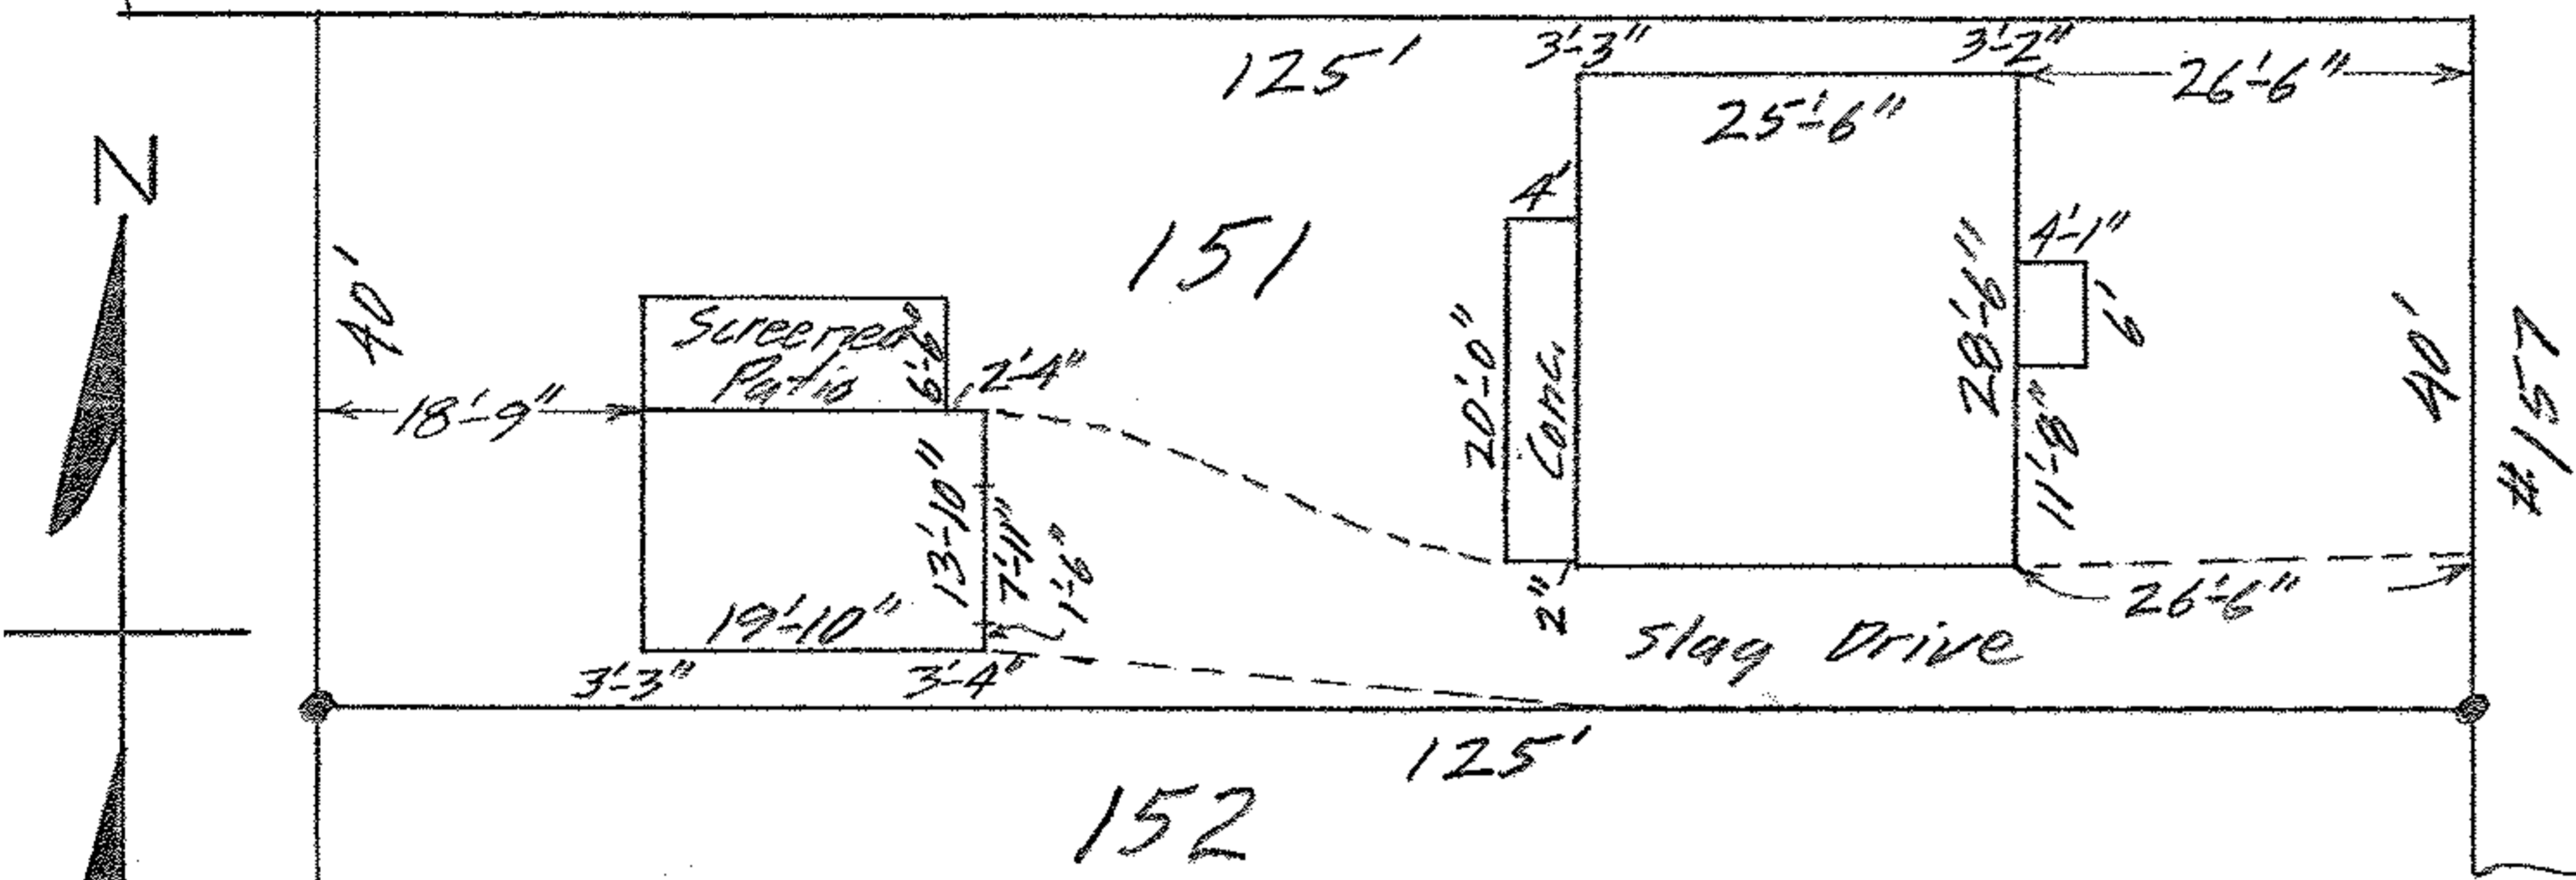

MAP OF SUB-LOT 151 BROADVIEW ALL'T. Vol. 9 Pg. 19

ELYRIA CITY LORAIN COUNTY OHIO

SCALE: 1" = 20' APRIL 26-1961 2:45 P.M.

Gary E. Penfound REG. SURVEYOR NO. 4457

Made for and at the instance of The Elyria Savings & Trust Co. and The Ohio Bar Title Insurance Co.

Rudolph Pasenow WW