
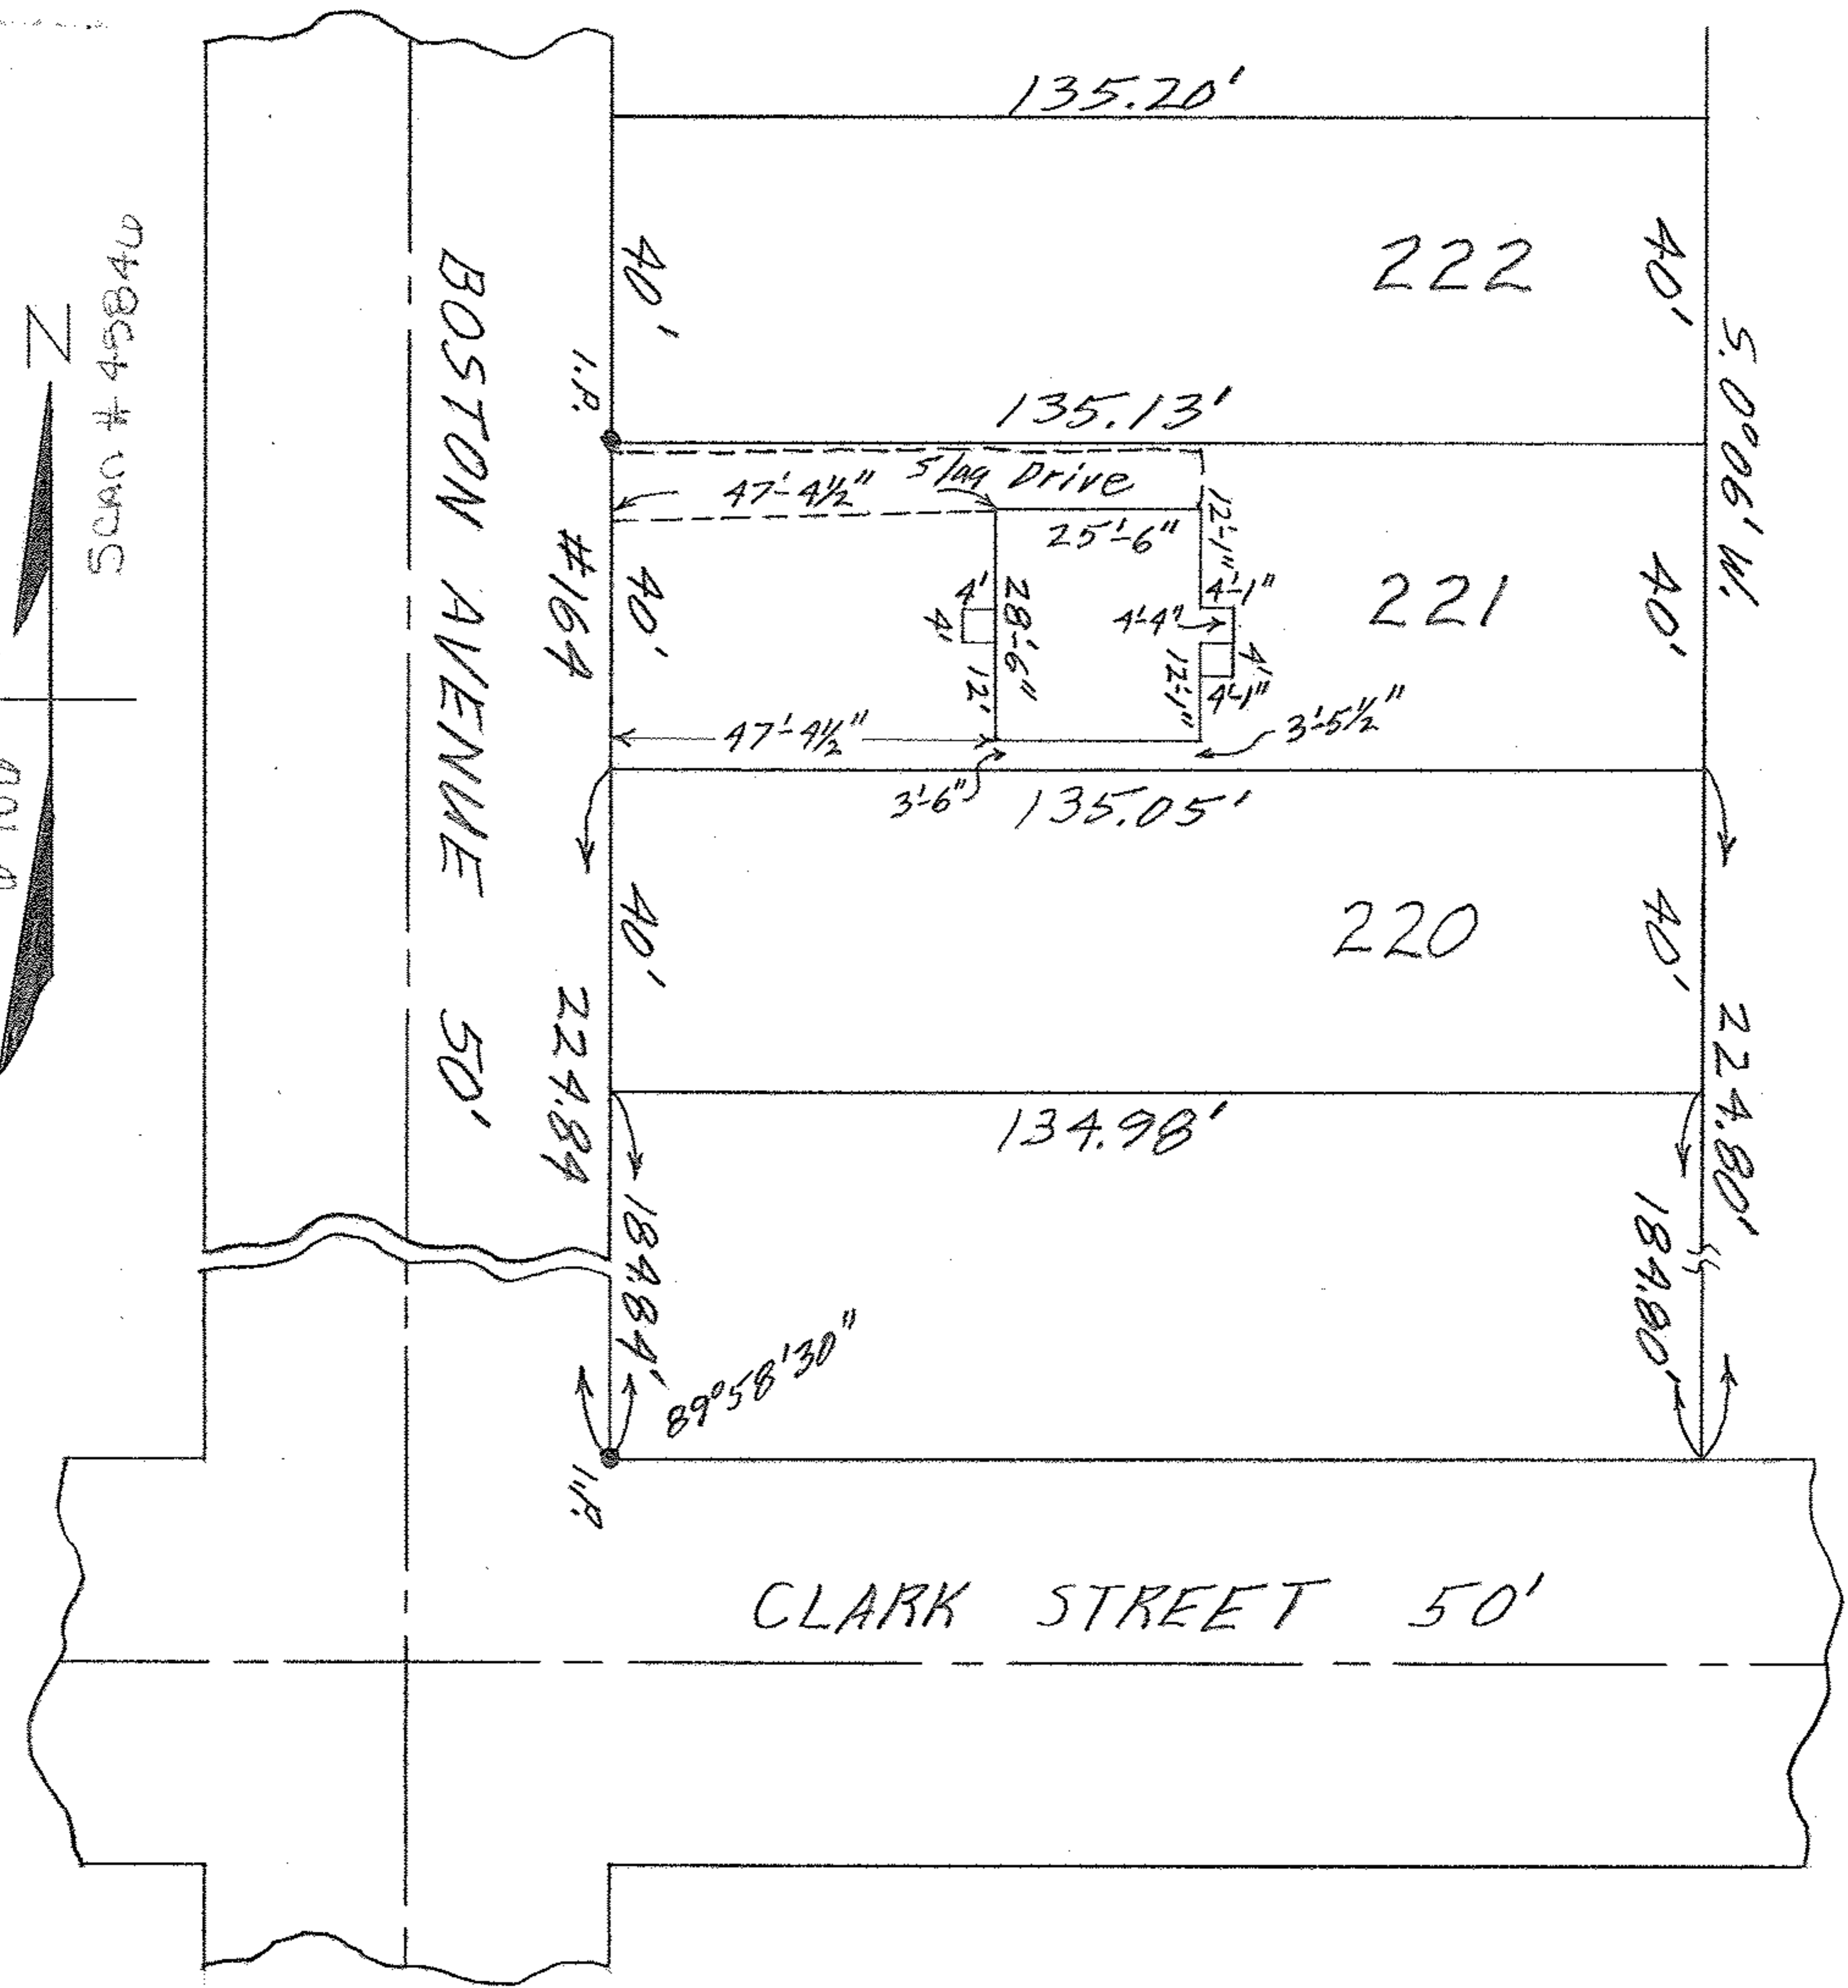


06-25-013-107-020,021,055
 500 # 45840
 701-9

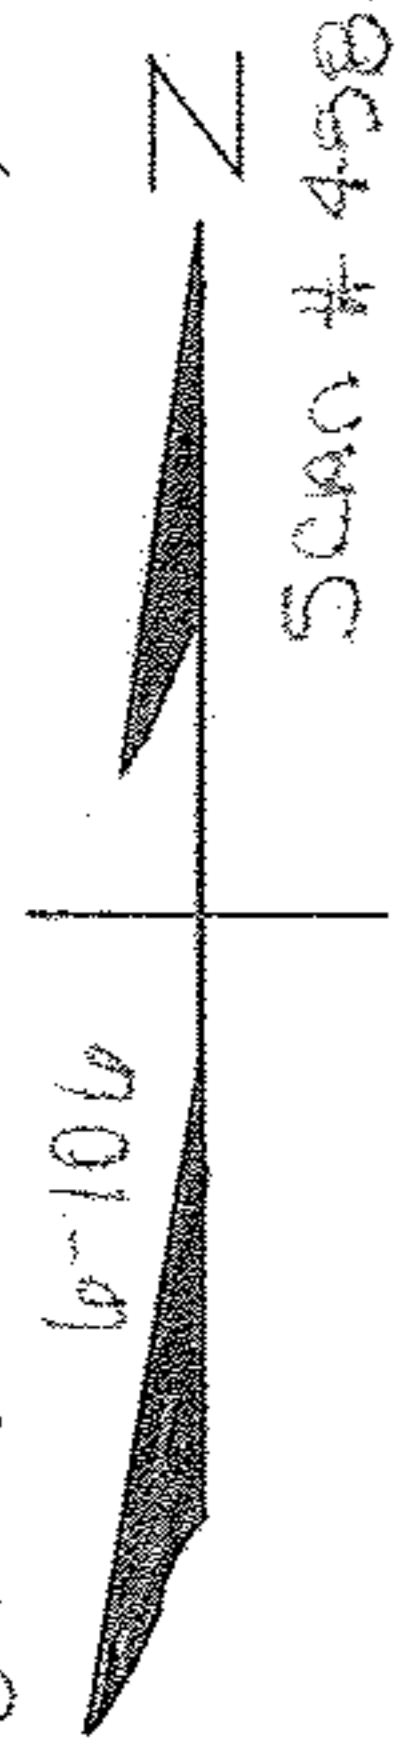

MAP OF SUB-LOT NO. 221
 THE BROADVIEW ALL'T. VOL. 9 Pg. 19
 ELYRIA TOWNSHIP ELYRIA CITY
 LORAIN COUNTY OHIO
 SCALE: 1" = 30' FEB. 13-1964 5:30 P.M.
 Gary E. Penfound REG. SURVEYOR

Alda E. Sturtevant W W