


06-25-013-109-010-012

SCAN# 45852

6-124

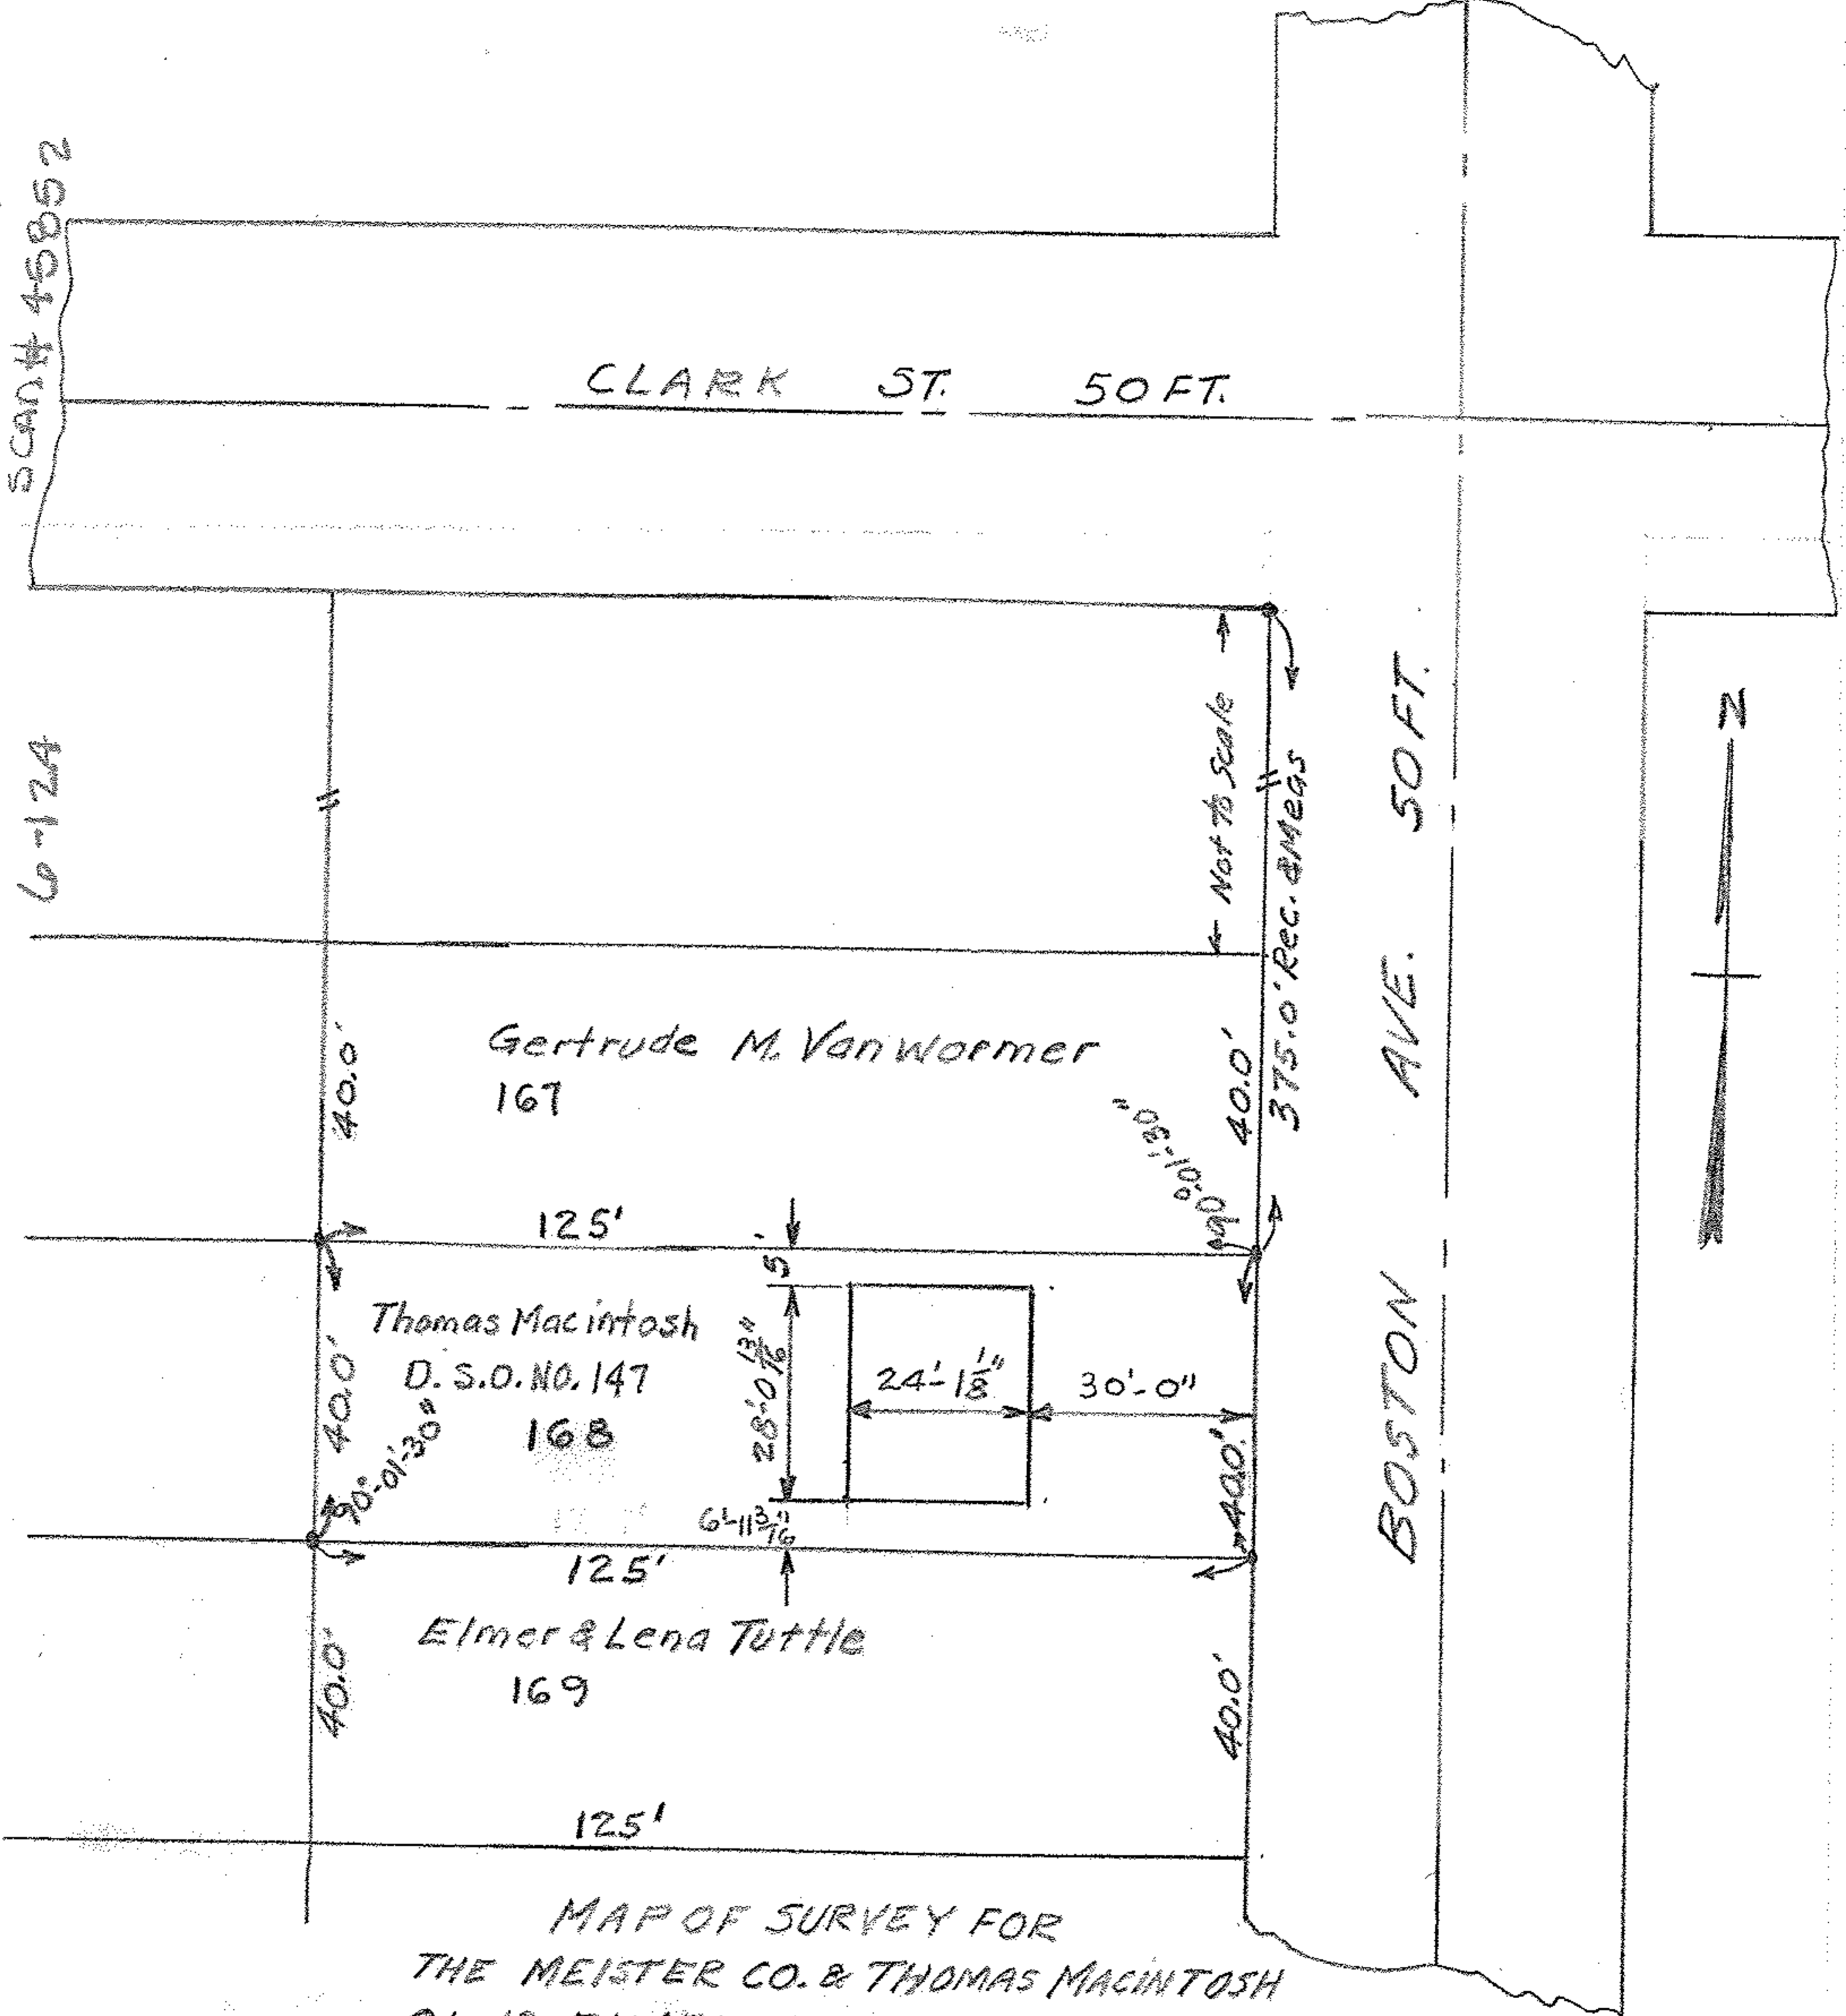

MAP OF SURVEY FOR
 THE MEISTER CO. & THOMAS MACINTOSH
 O.L. 13 ELYRIA TWP. EAST OF BLACK RIVER.
 SUB-LOT 168 BROADVIEW ALLOT. VOL. 9 PG 19
 LORAIN COUNTY OHIO
 Scale 1" = 30 FT. JULY 11-1950
 C.E. Penfound Registered Surveyor.