


06-25-013-109-025-7028
6-124
SCAN # 45853

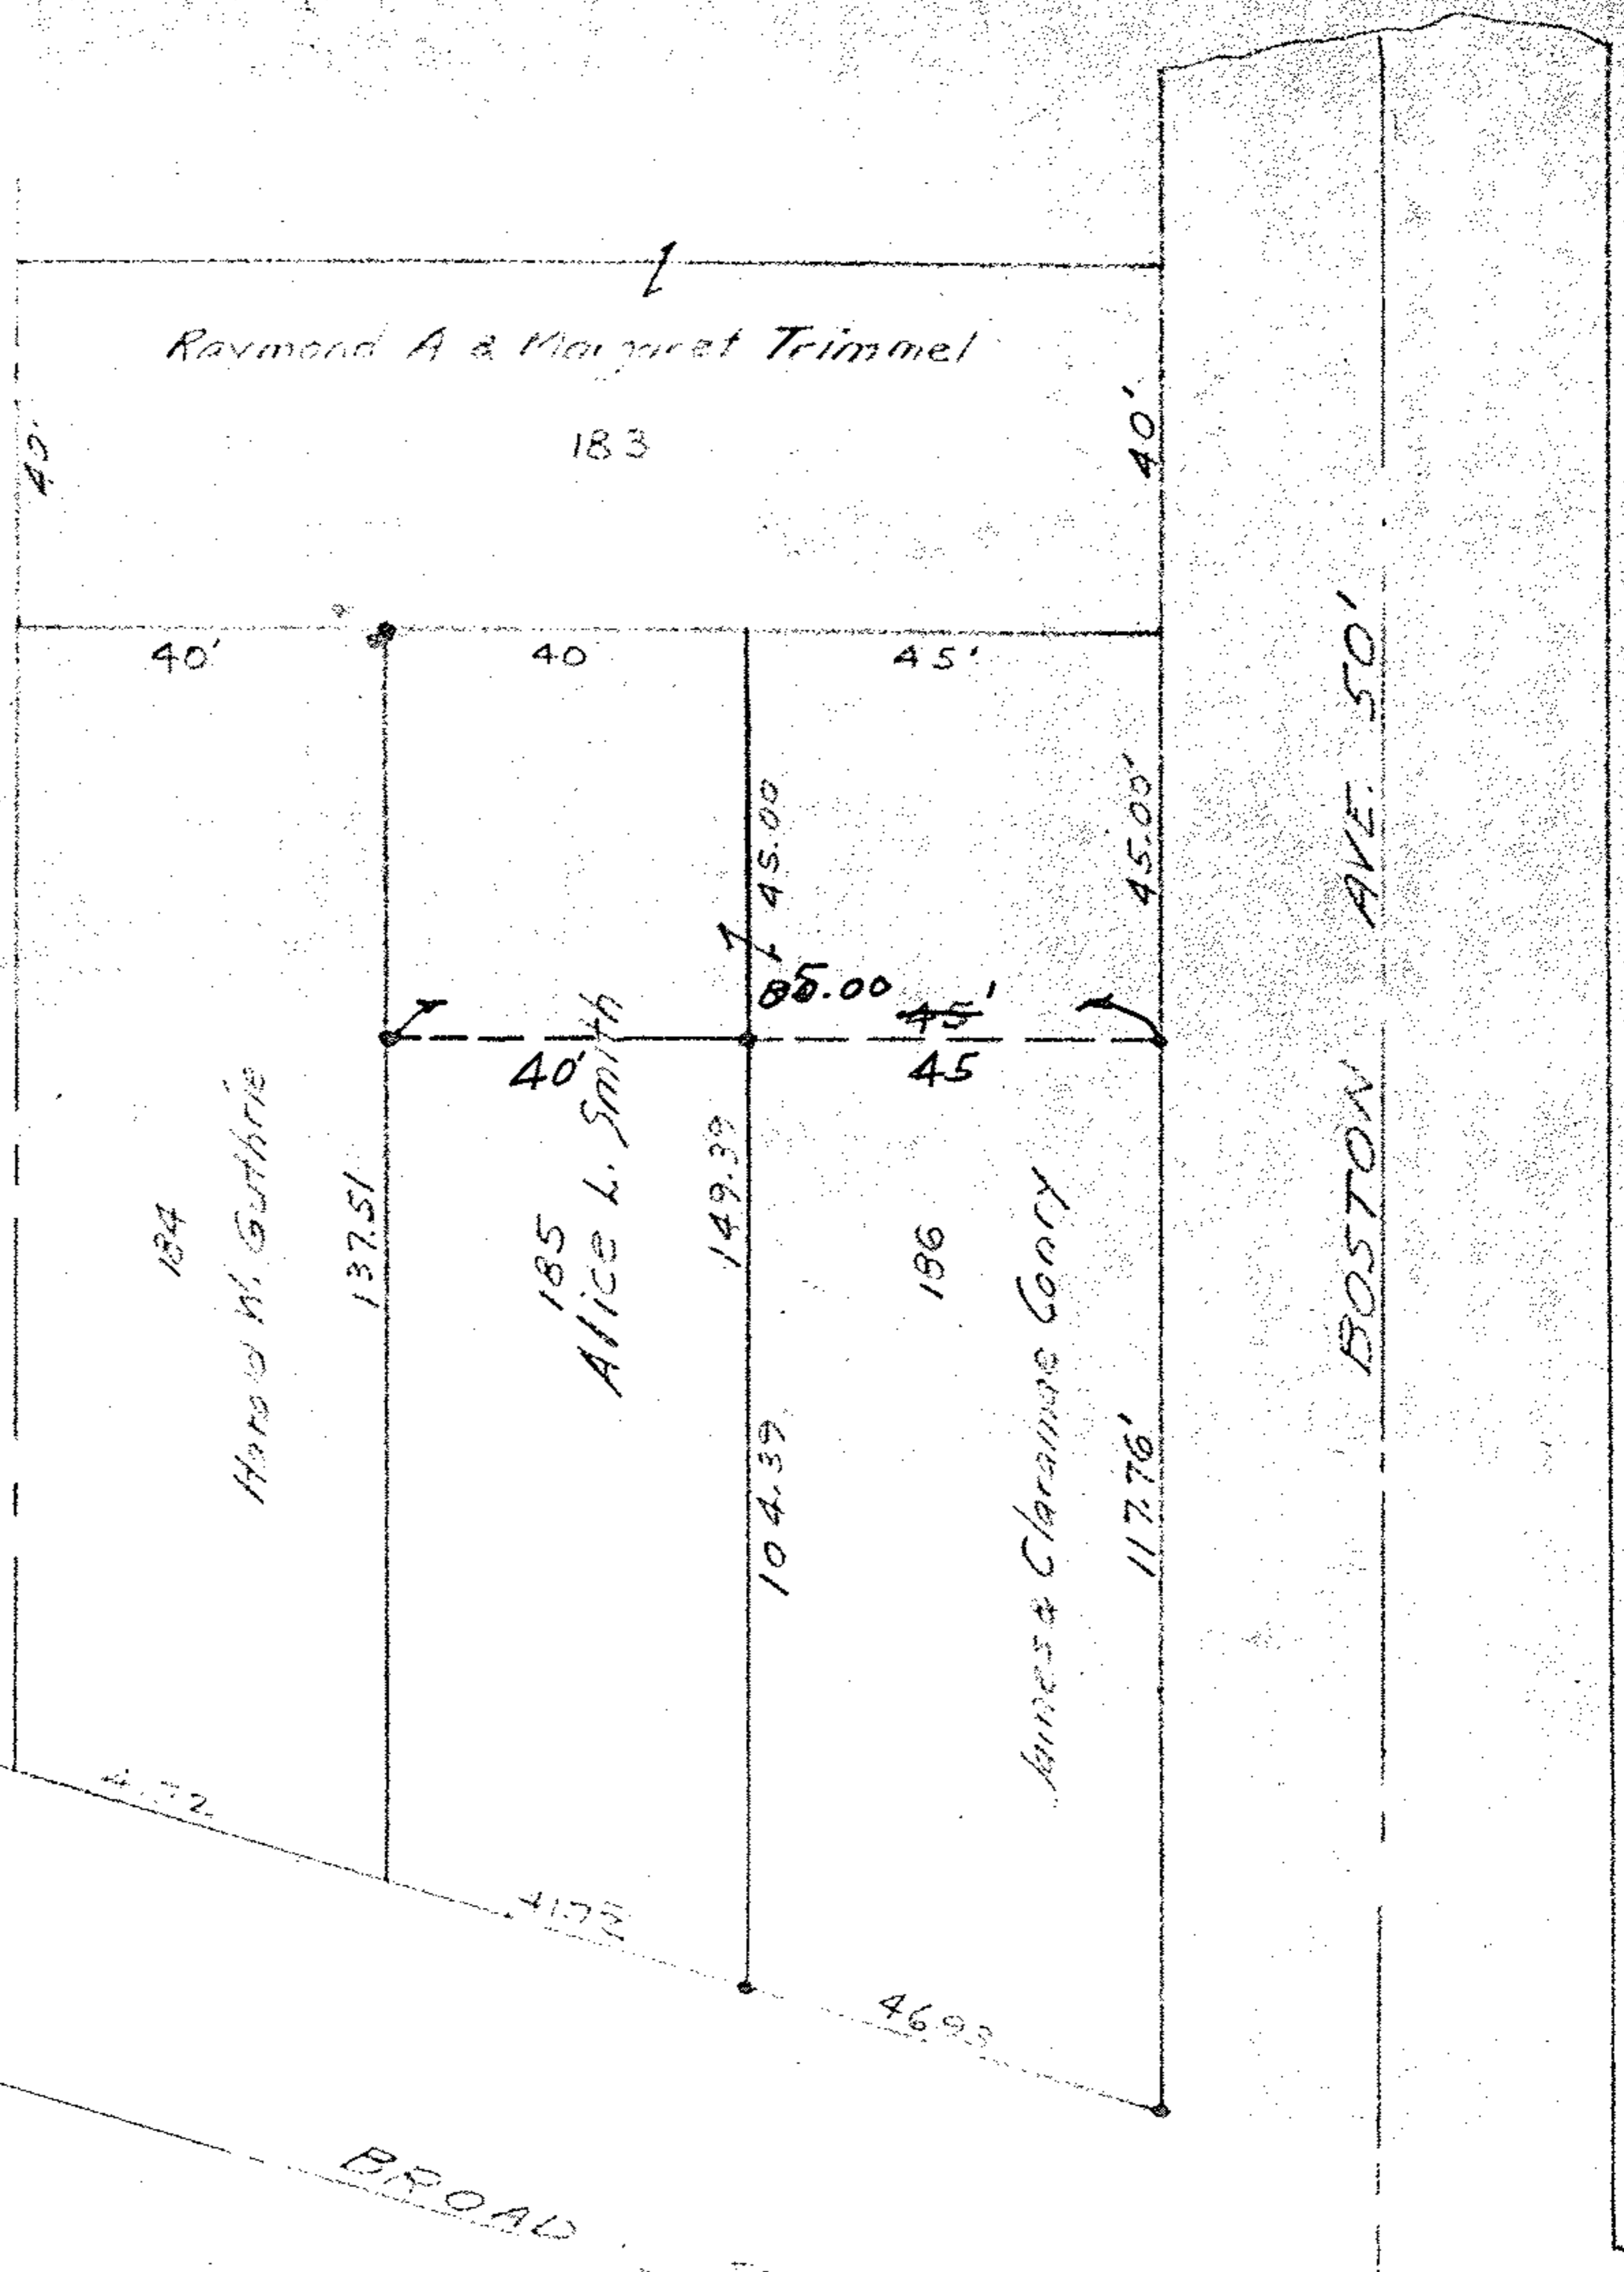

MAP OF SURVEY FOR
 James & Clarence Conry
 PT OF SUB-LOT 186 BROADVIEW ALLT.
 VOLUME 3 PG 17 L.S. R. ELYRIA TWP LOT 12 EAST OF RIVER
 ELYRIA CITY LORAIN COUNTY - OHIO
 SCALE 1" = 30'
 C.E. [unclear] found
 FEB - 22 - 1934
 Registered Surveyor.

Note Iron pins found or set
 shown thus. •