


06-25-013-111-001  
4-124 SCAN # 45854

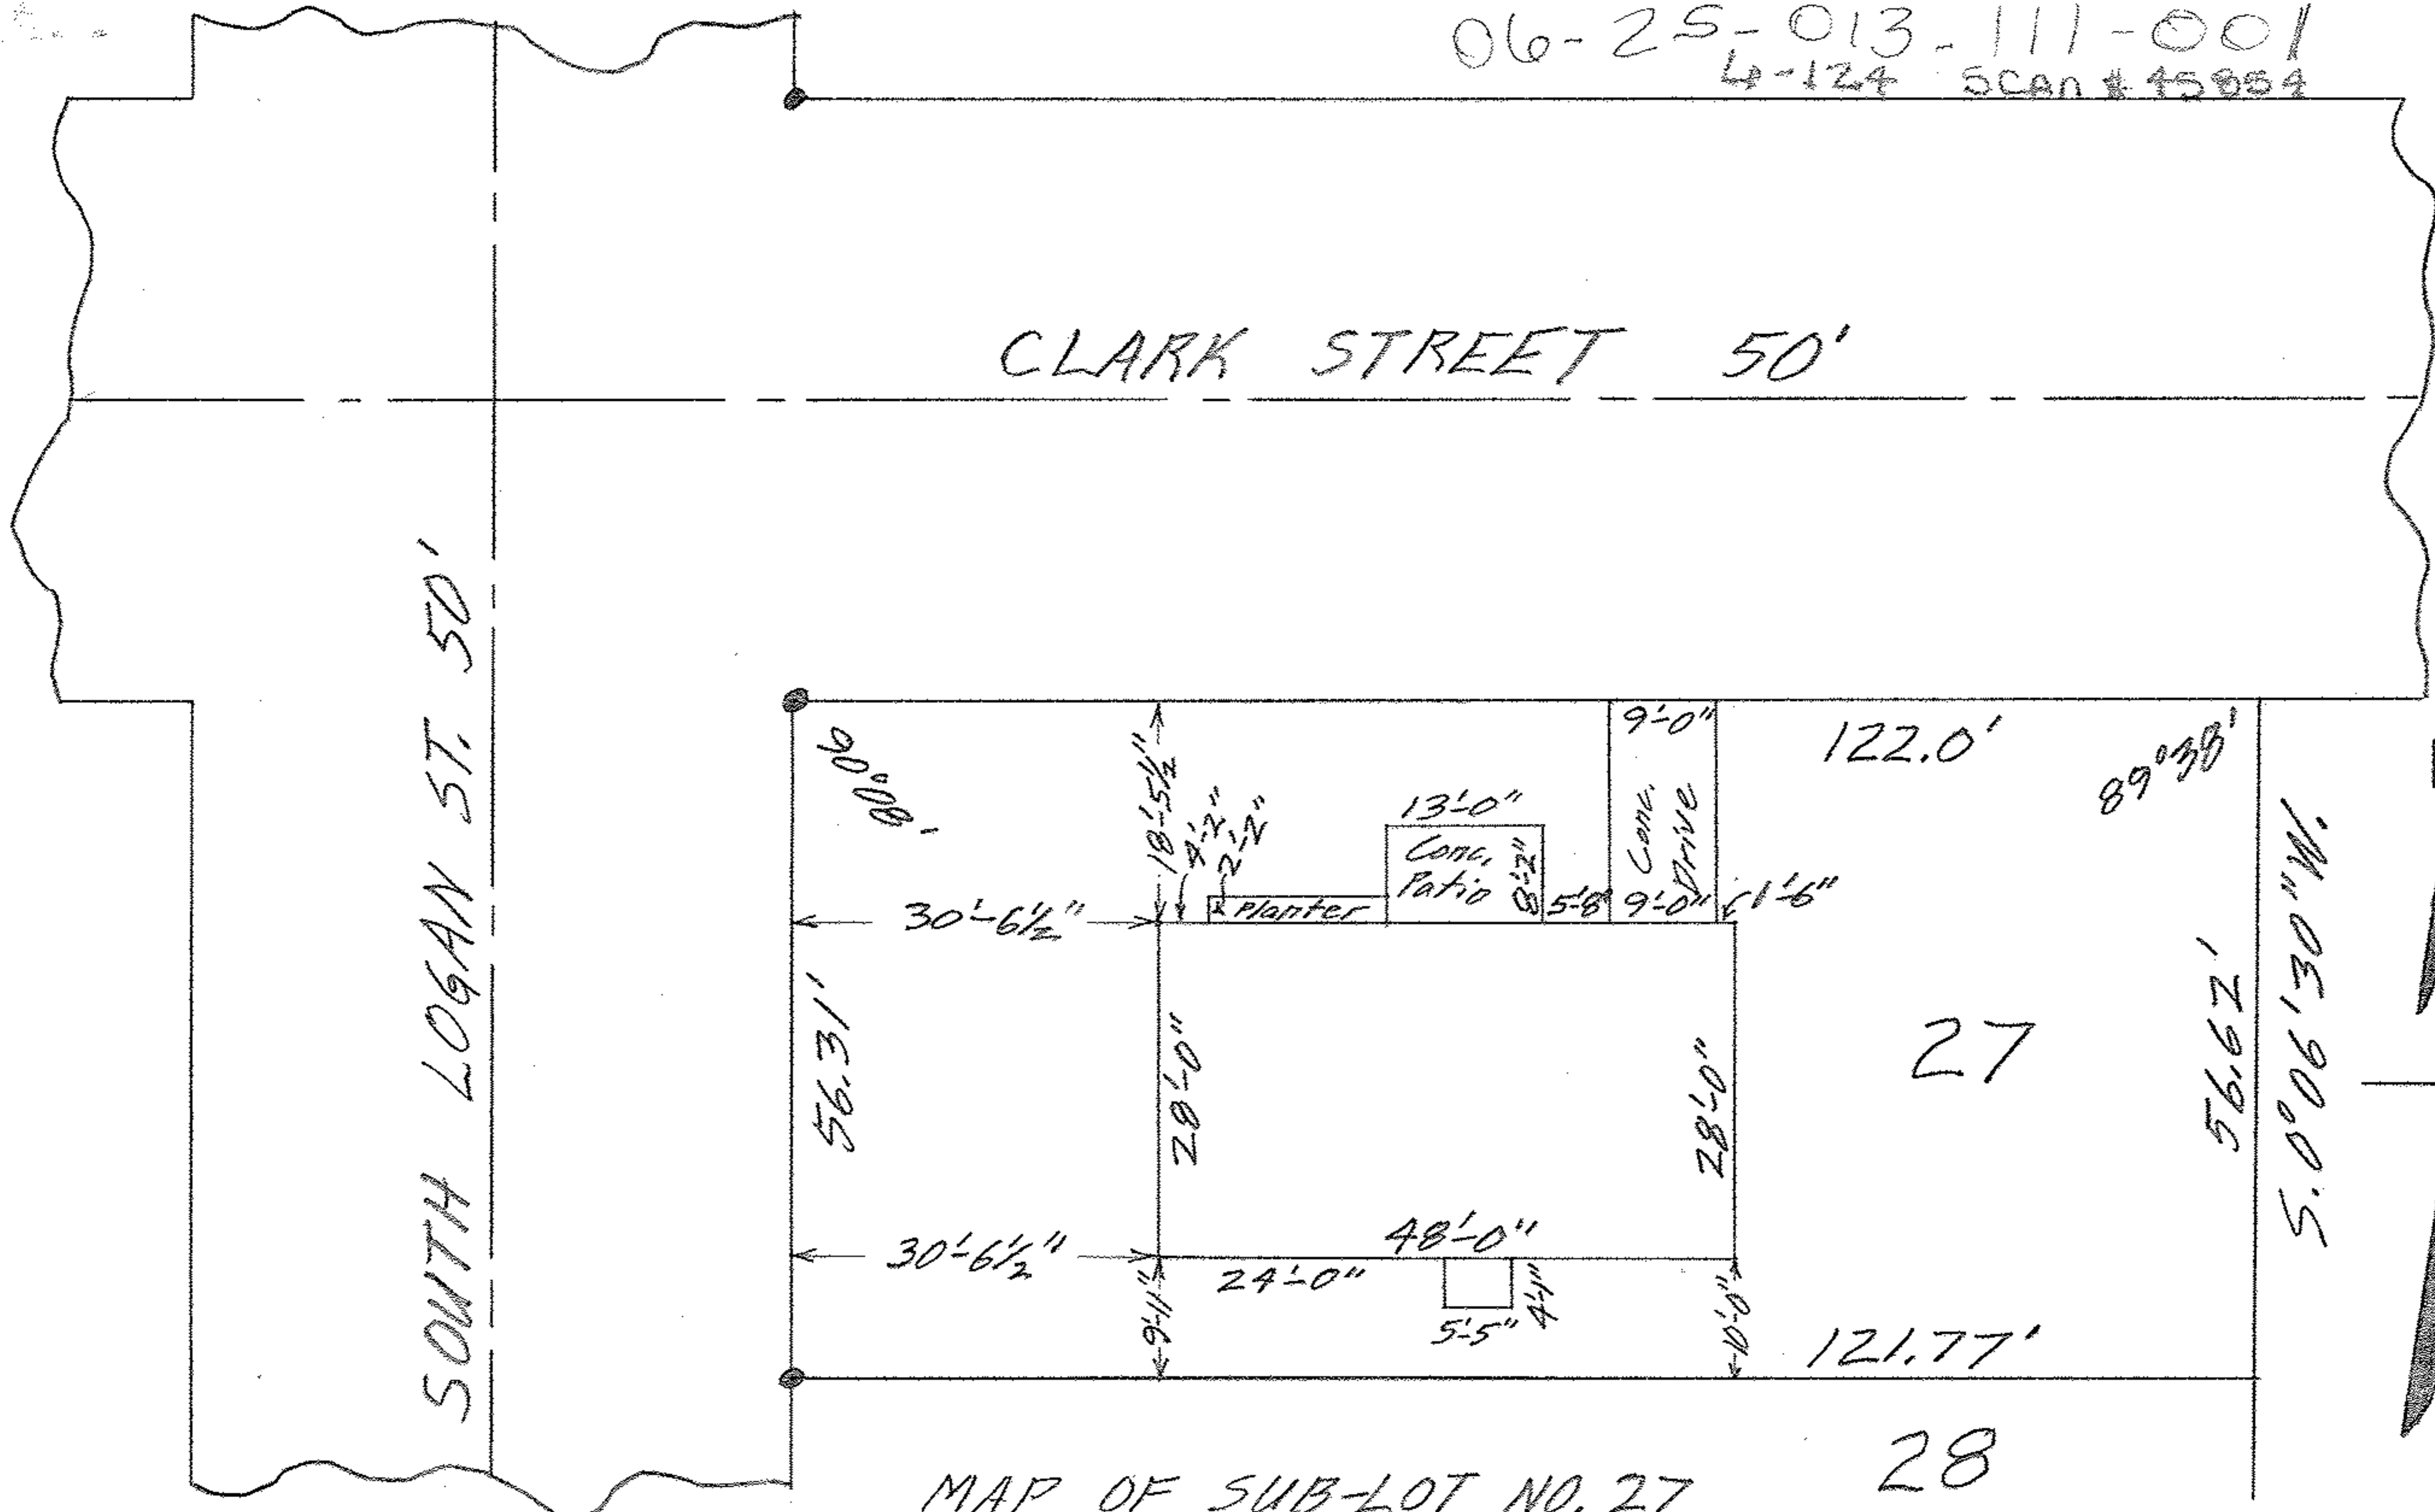

MAP OF SUB-LOT NO. 27

28

THE ELYRIA CHAMBER OF COMMERCE ALL'T. - Vol. 7 Pg. 27  
ELYRIA TWP. - ELYRIA CITY - LORAIN COUNTY - OHIO

SCALE: 1" = 20' AUG. 20-1963 11:00 A.M.

Gary E. Penfound REG. SURVEYOR

Henry Barney, Jr. & Wanda L. Barney WW