
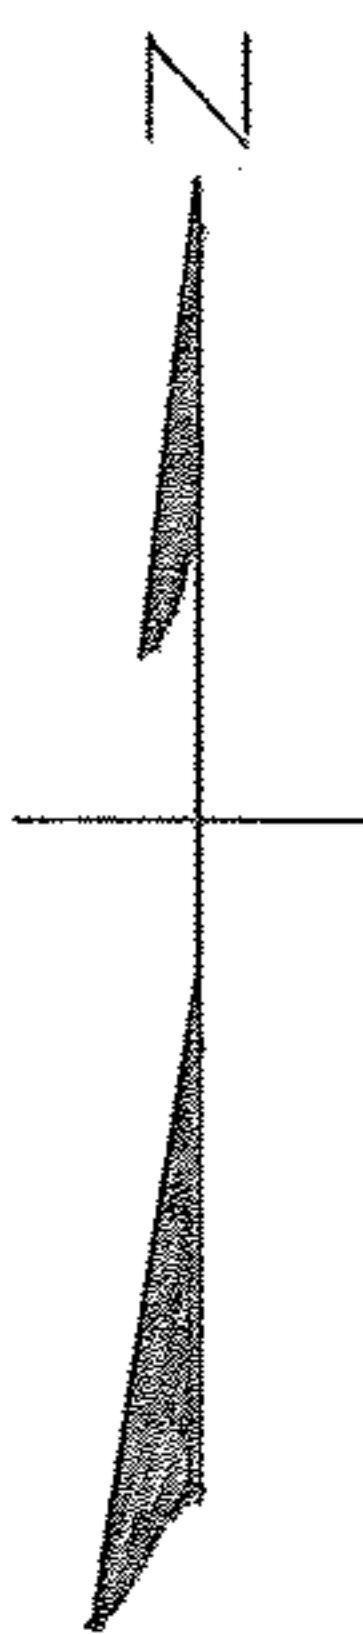


06-25-014-102-012  
 6-105  
 SCAN #45856

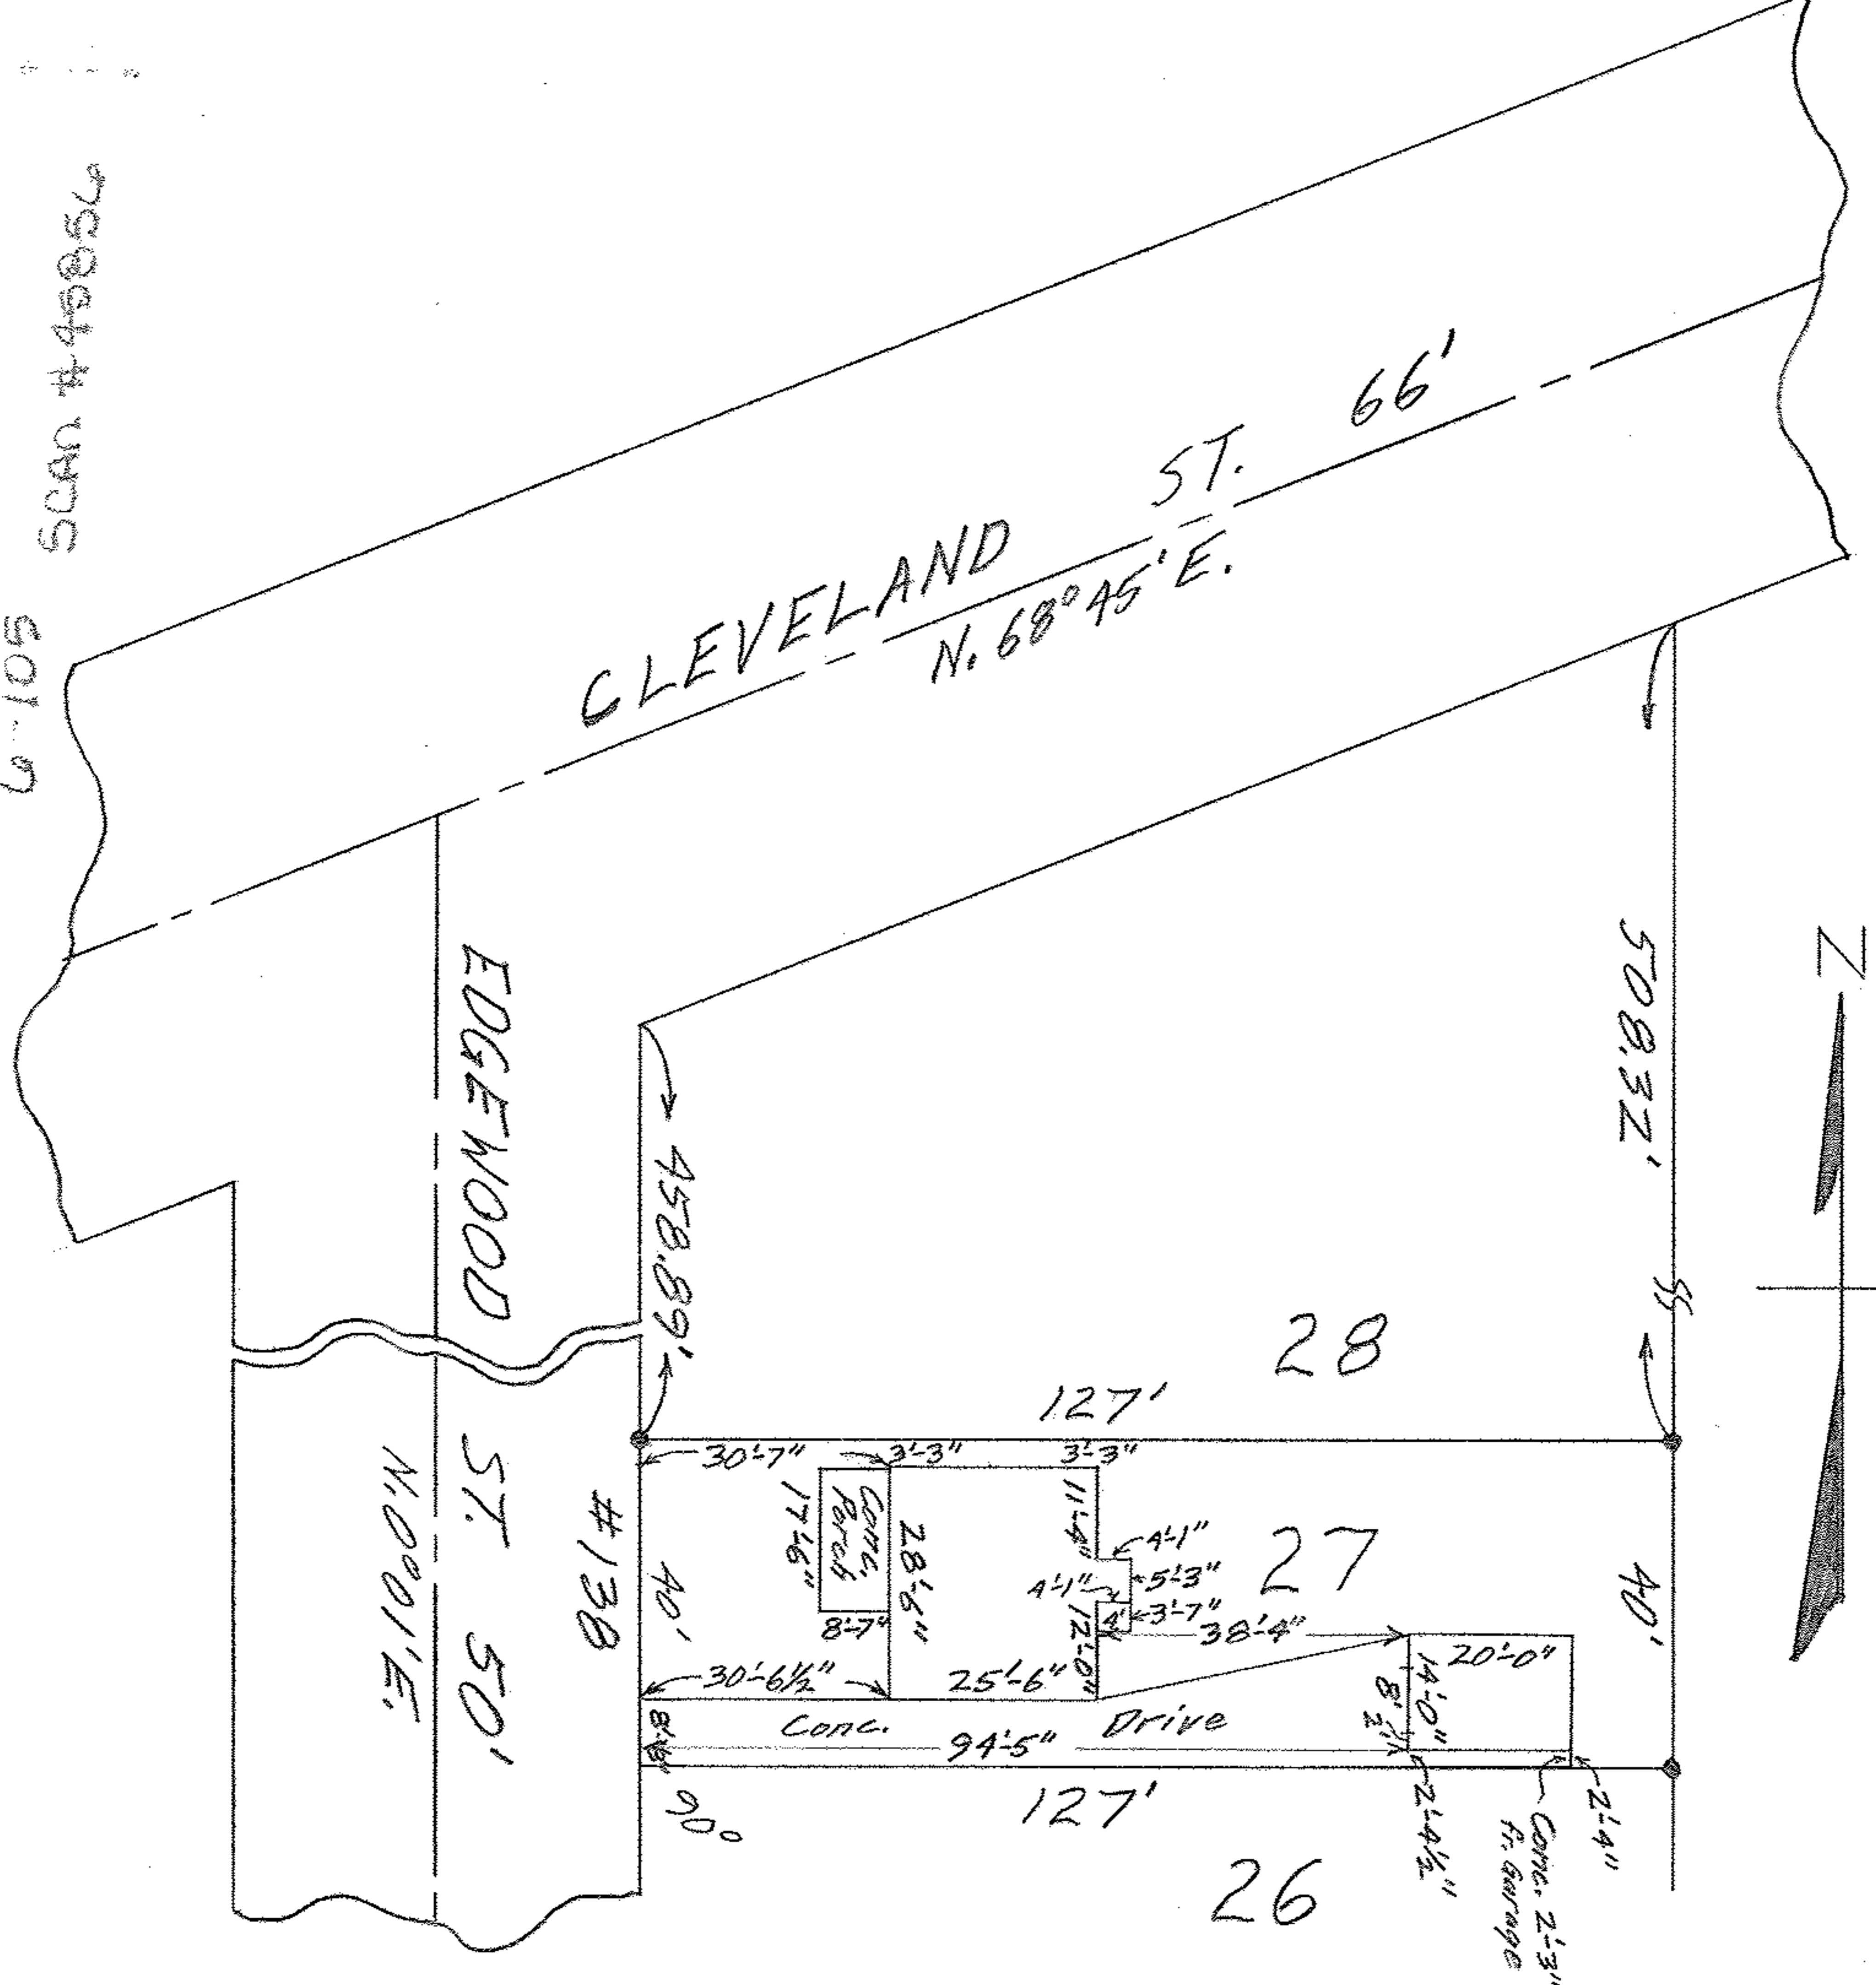

MAP OF SUB-LOT NO. 27  
 BEEBE SUB'N. NO. 3 VOL. 9 PG. 32  
 O.L.'S 13 & 14, EAST OF RIVER, ELYRIA TWP.  
 ELYRIA CITY - LORAIN COUNTY - OHIO  
 SCALE: 1" = 30' SEPT. 11 - 1963 4:30 P.M.  
 Gary E. Penfound REG. SURVEYOR

Helen D. Lanaghan WW