





06-25-014-109-001
6-123

SCAN # 458600

West Line O.L. 14

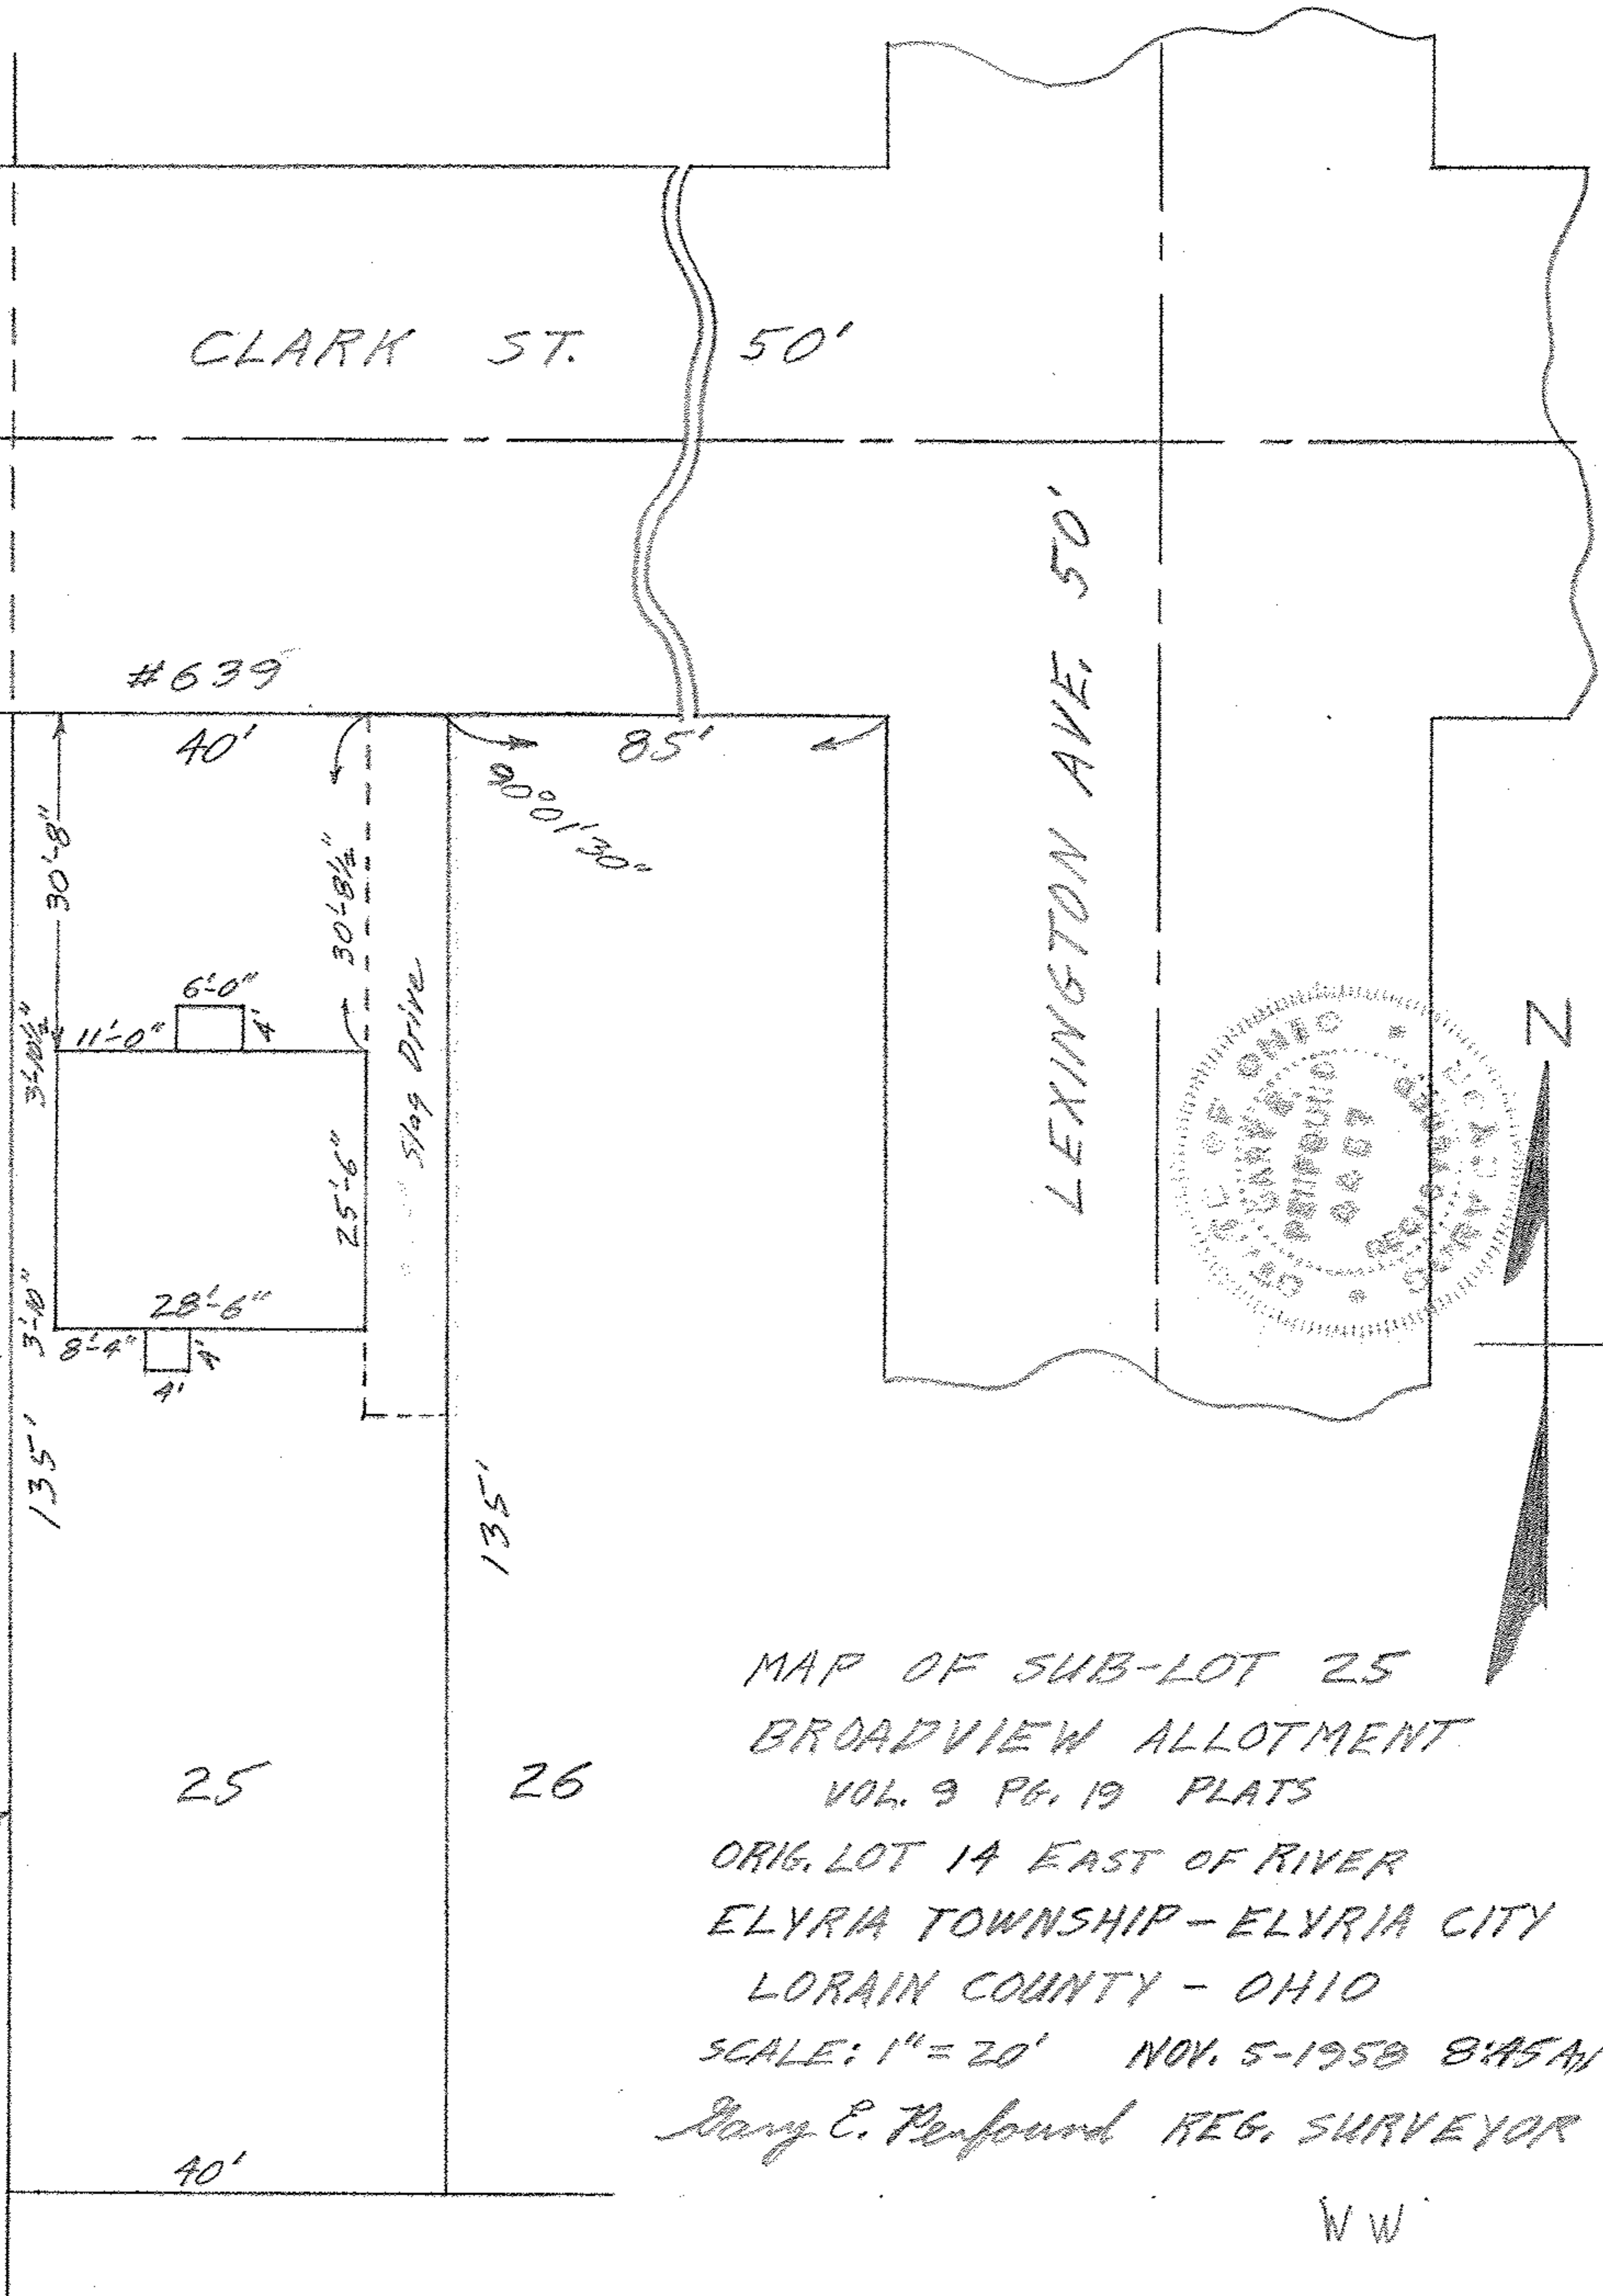

#639

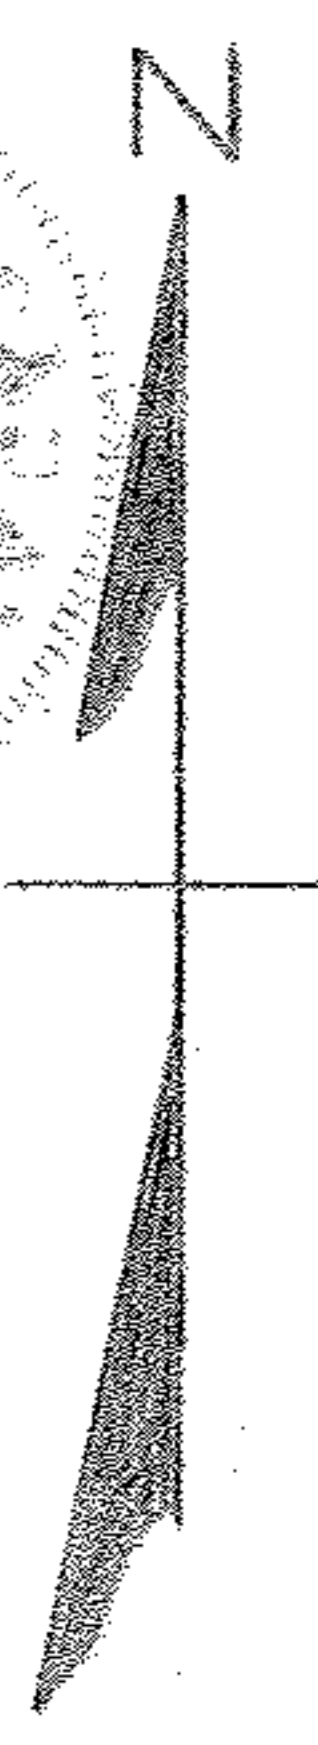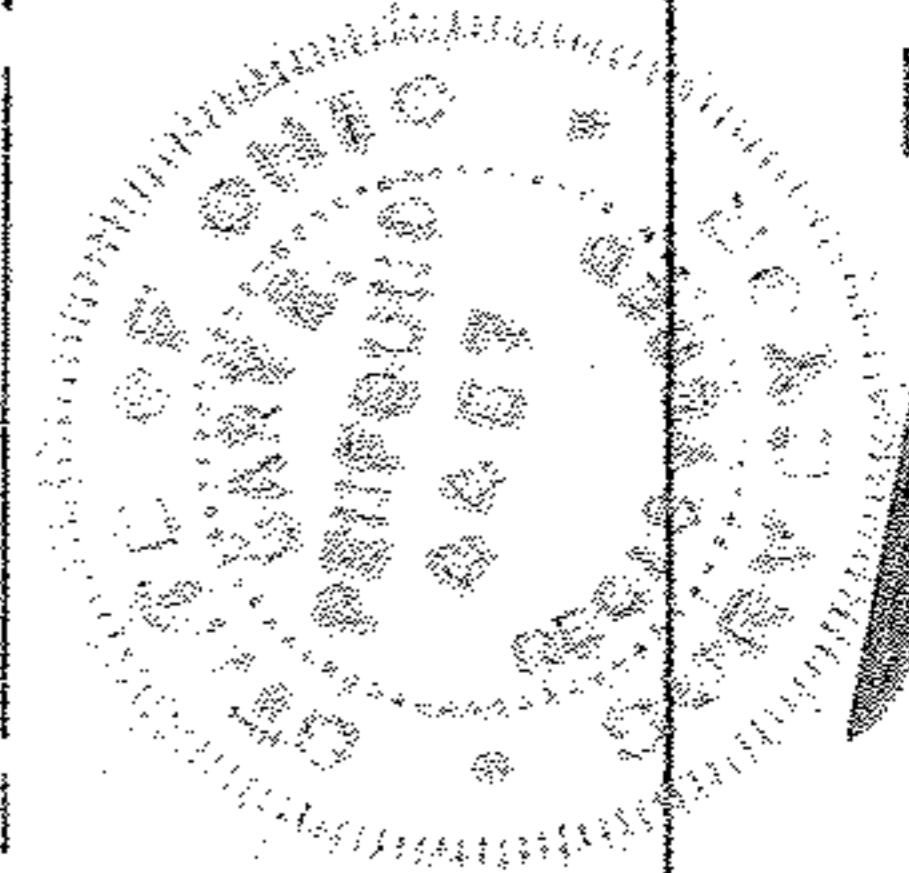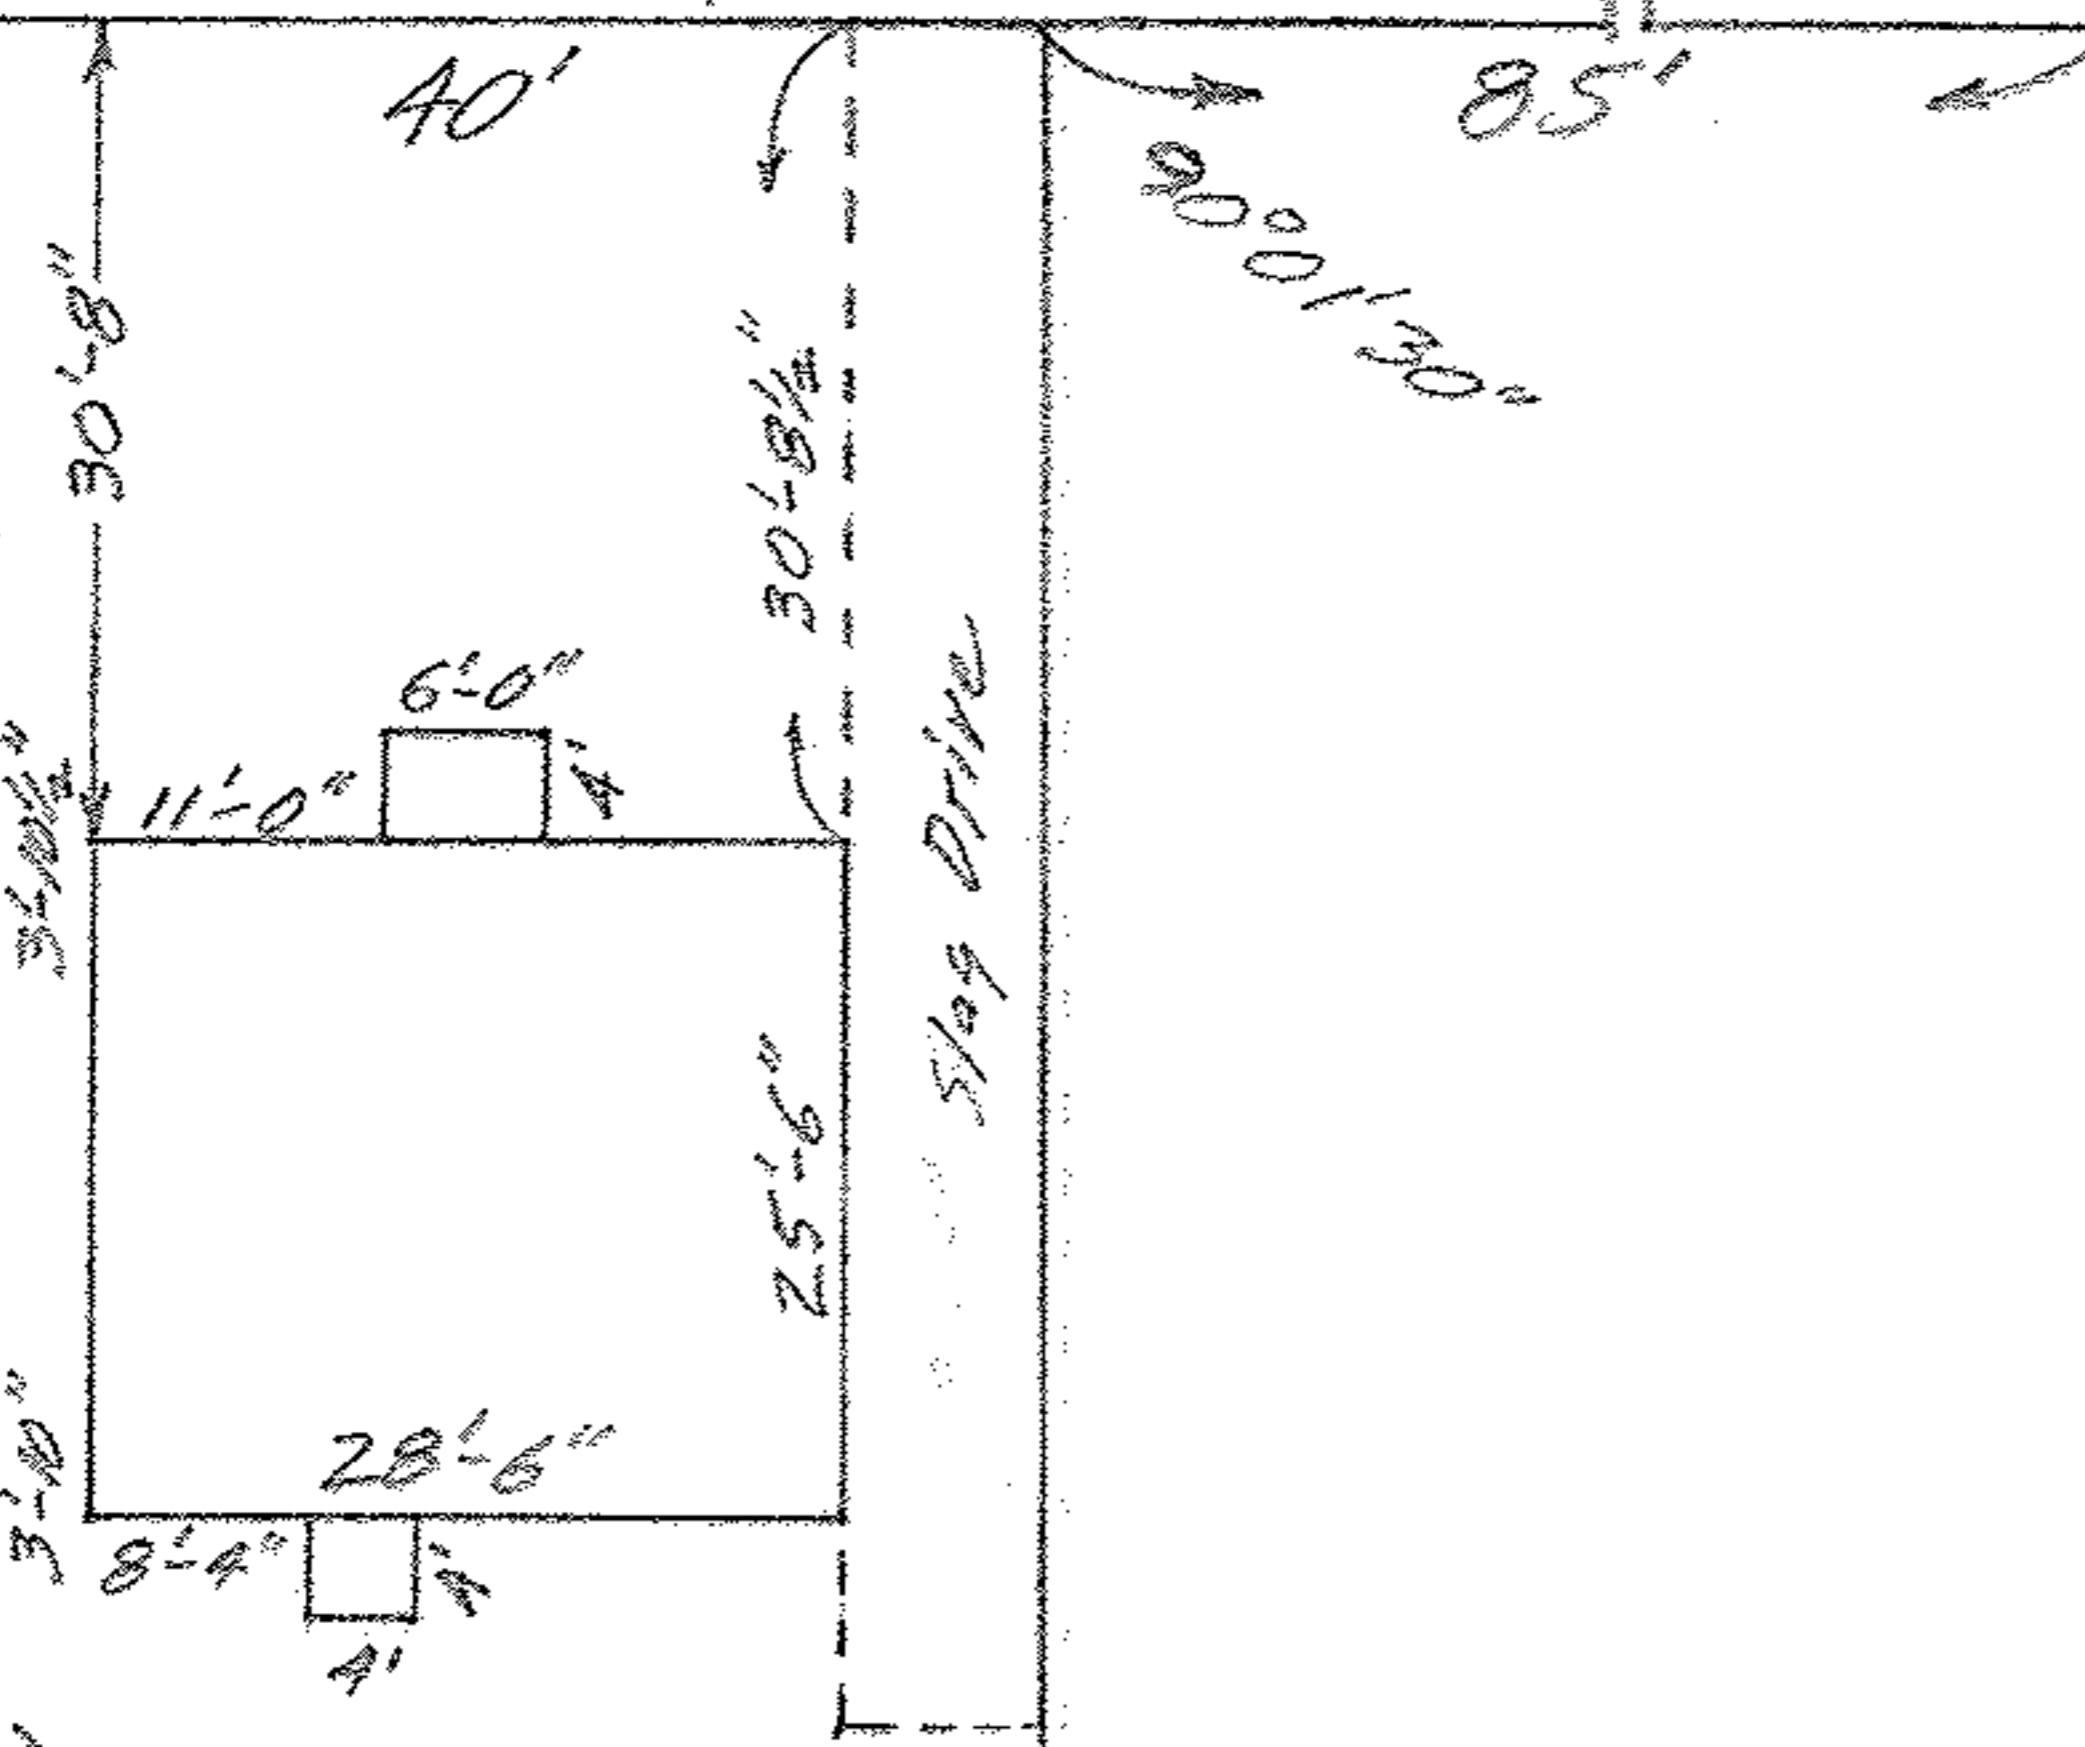

MAP OF SUB-LOT 25
 BROADVIEW ALLOTMENT
 VOL. 9 PG. 19 PLATS
 ORIG. LOT 14 EAST OF RIVER
 ELYRIA TOWNSHIP - ELYRIA CITY
 LORAIN COUNTY - OHIO
 SCALE: 1" = 20' NOV. 5-1958 8:45 AM.
 Mary E. Perford REG. SURVEYOR

NW