


06-25-017-103-038  
6-87



SCAN # 45882

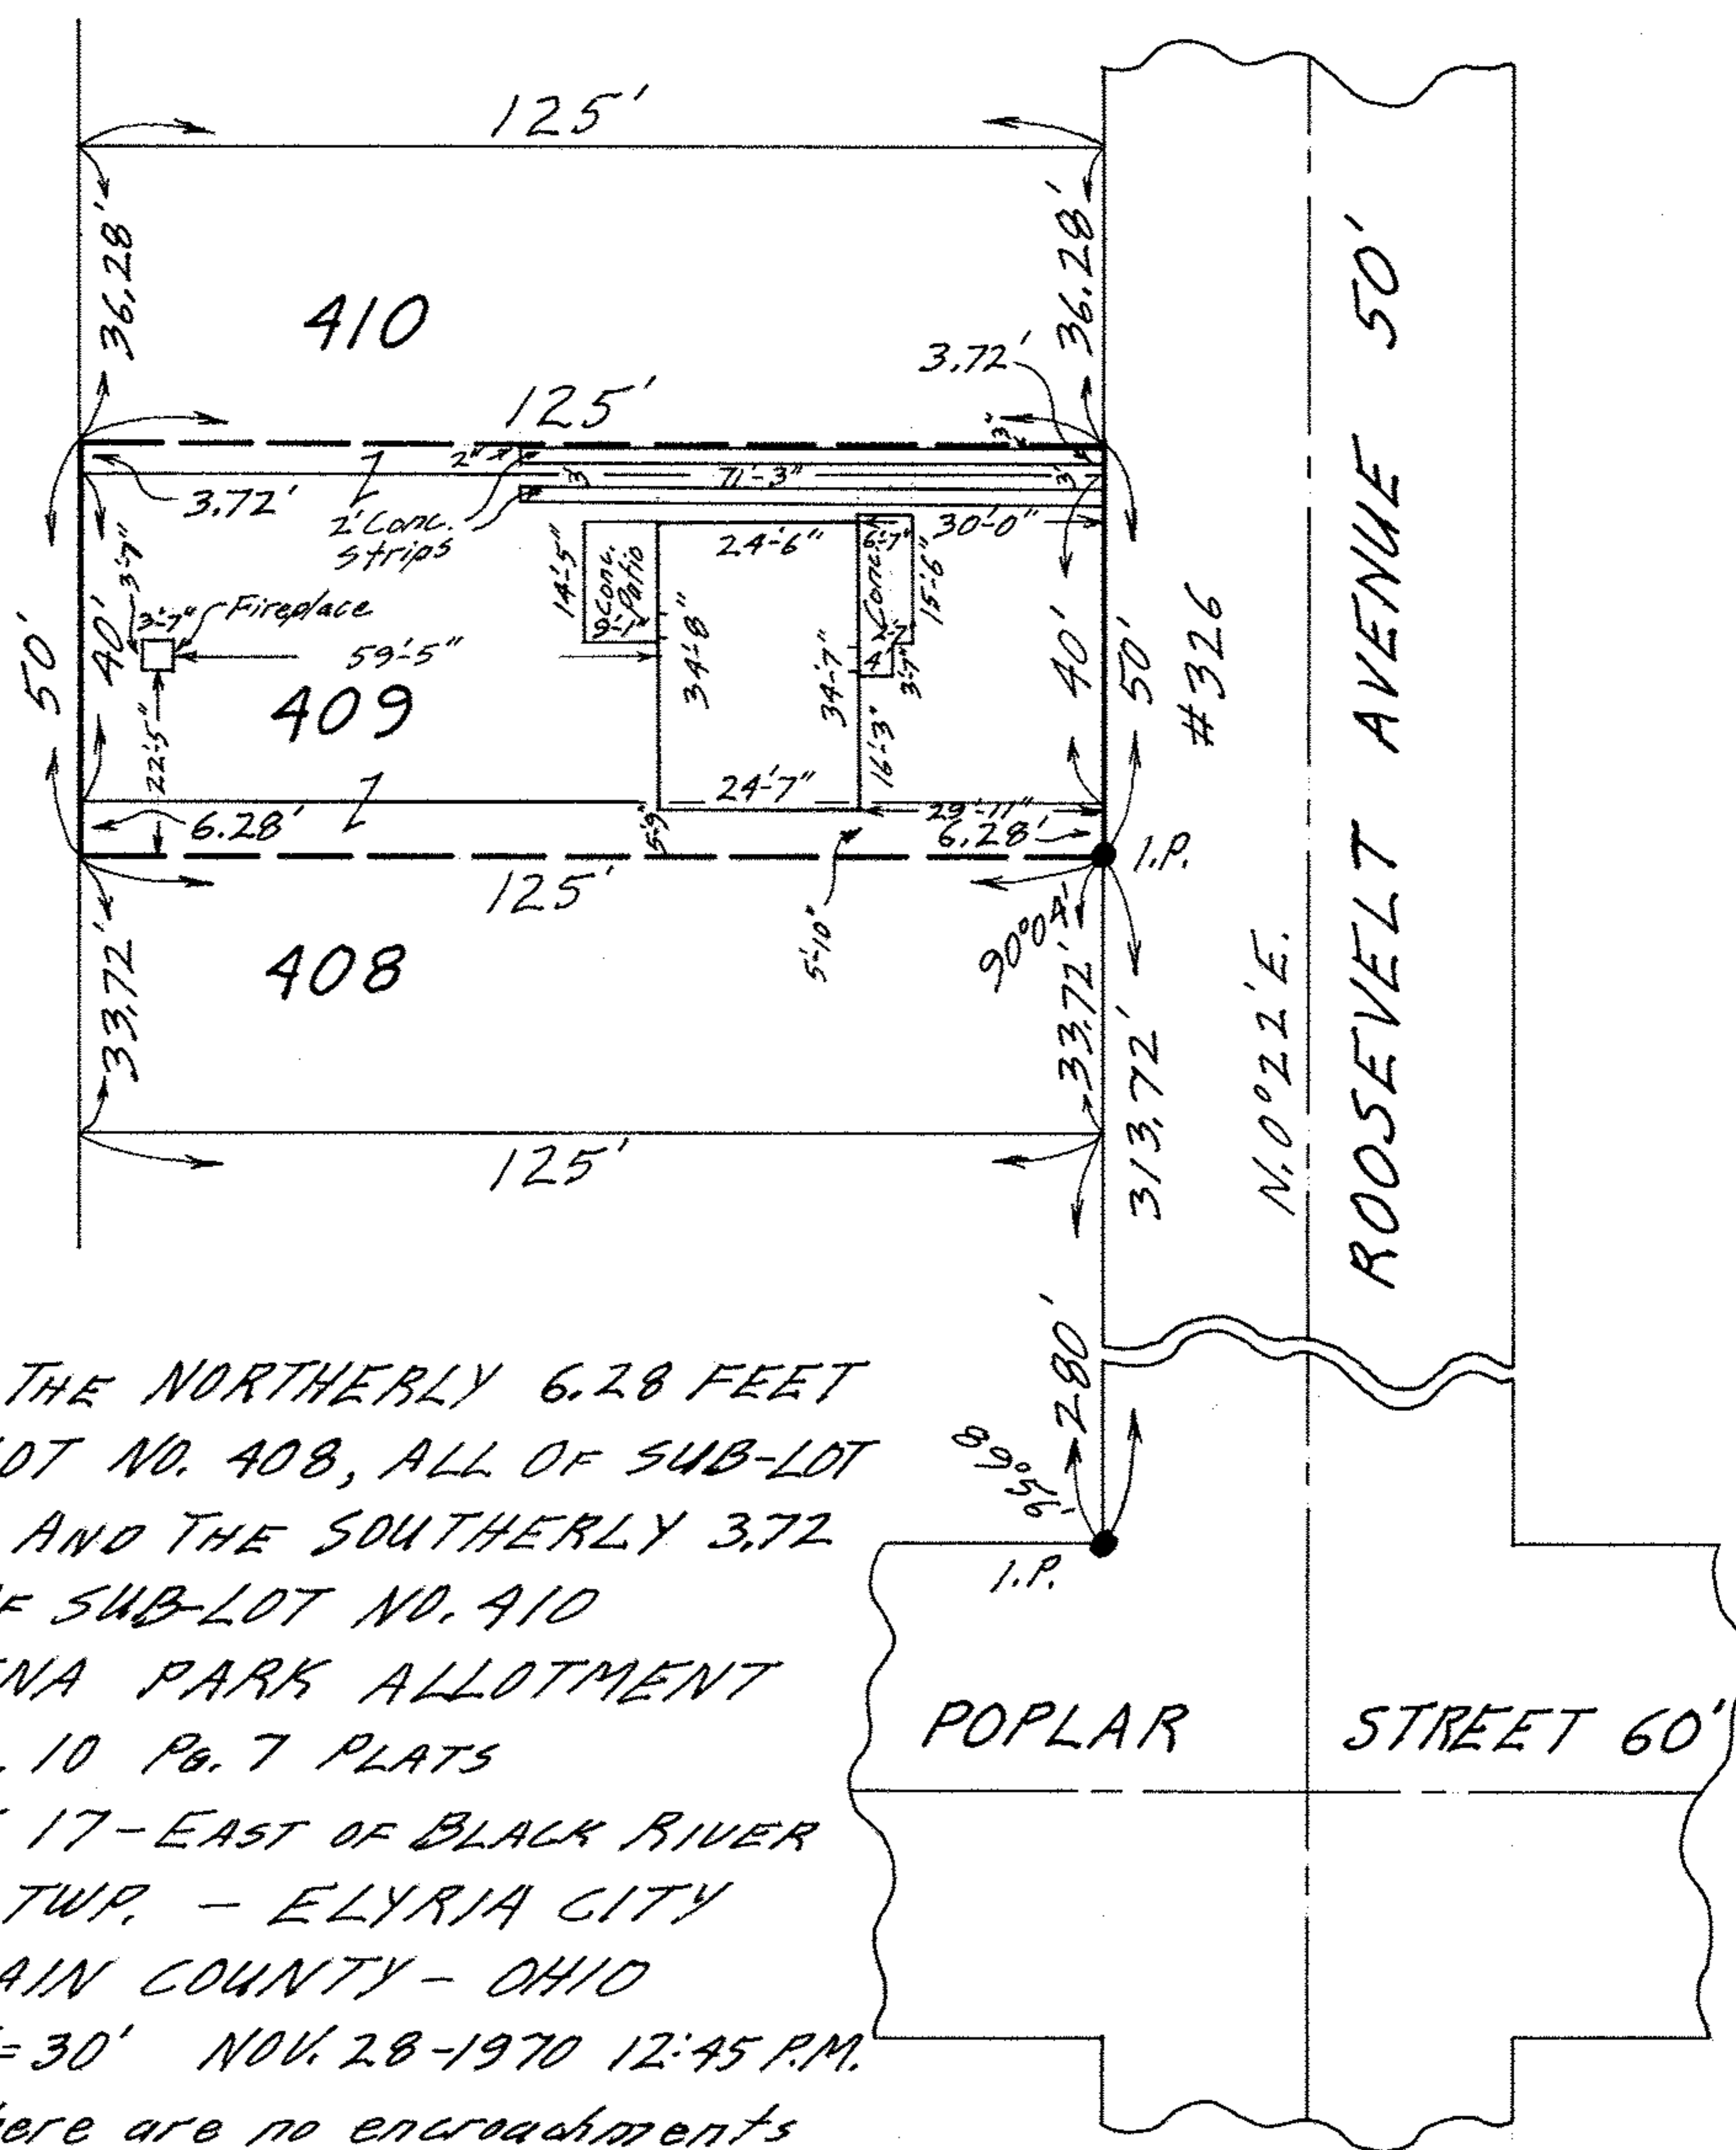

MAP OF THE NORTHERLY 6.28 FEET  
 OF SUB-LOT NO. 408, ALL OF SUB-LOT  
 NO. 409 AND THE SOUTHERLY 3.72  
 FEET OF SUB-LOT NO. 410

PASADENA PARK ALLOTMENT  
 VOL. 10 PG. 7 PLATS  
 ORIG. LOT 17 - EAST OF BLACK RIVER  
 ELYRIA TWP. - ELYRIA CITY  
 LORAIN COUNTY - OHIO  
 SCALE: 1" = 30' NOV. 28-1970 12:45 P.M.

NOTE: There are no encroachments  
 on this property.

Gary E. Penfound REG. SURVEYOR NO. 4457

CITY TITLE Co. Order No. E-1397-8  
 Buckland to Liston