


06-25-017-107-029 6-87  
Scan # 45883

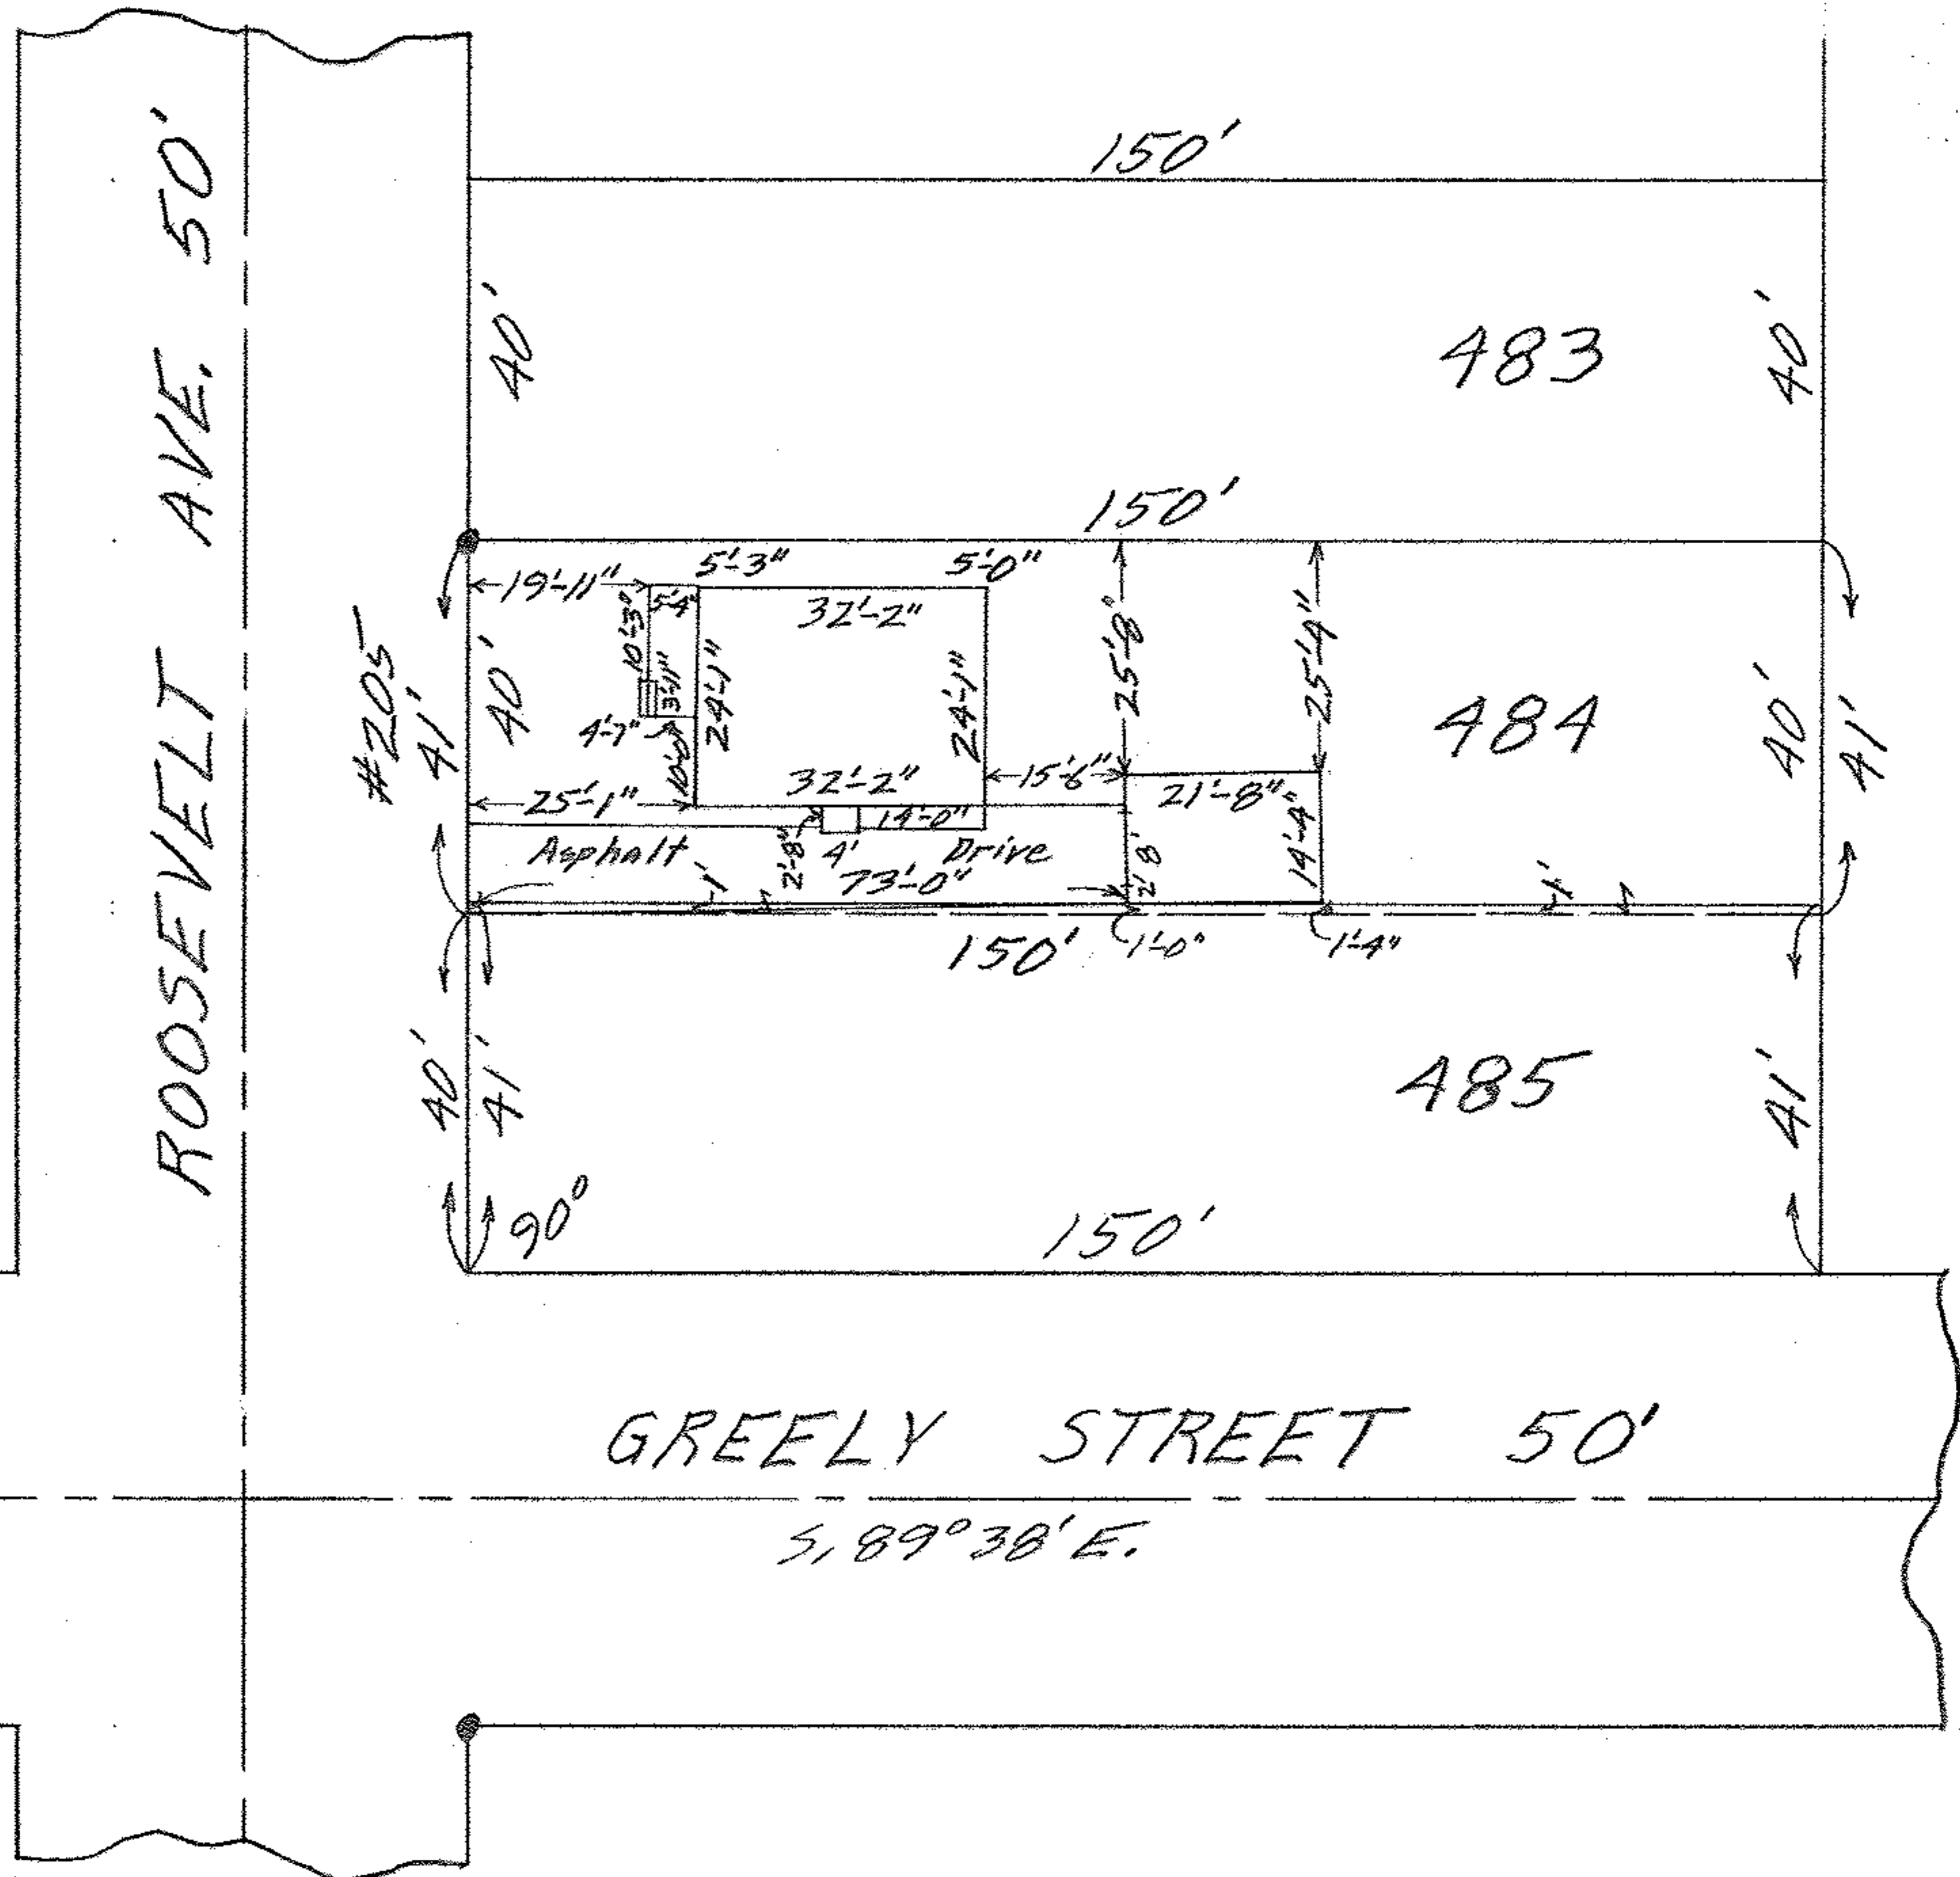

MAP OF SUB-LOT 484 AND NORTHERLY  
ONE FOOT OF SUB-LOT 485  
PASADENA PARK ALL'T. Vol. 10 Pg. 7  
ELYRIA CITY - LORAIN COUNTY - OHIO  
SCALE: 1" = 30' FEB. 18-1963 4:00 P.M.  
Gary E. Penfound REG. SURVEYOR

W W

WWW