


06-25-017-109-024  
Scan# 45884  
4-87

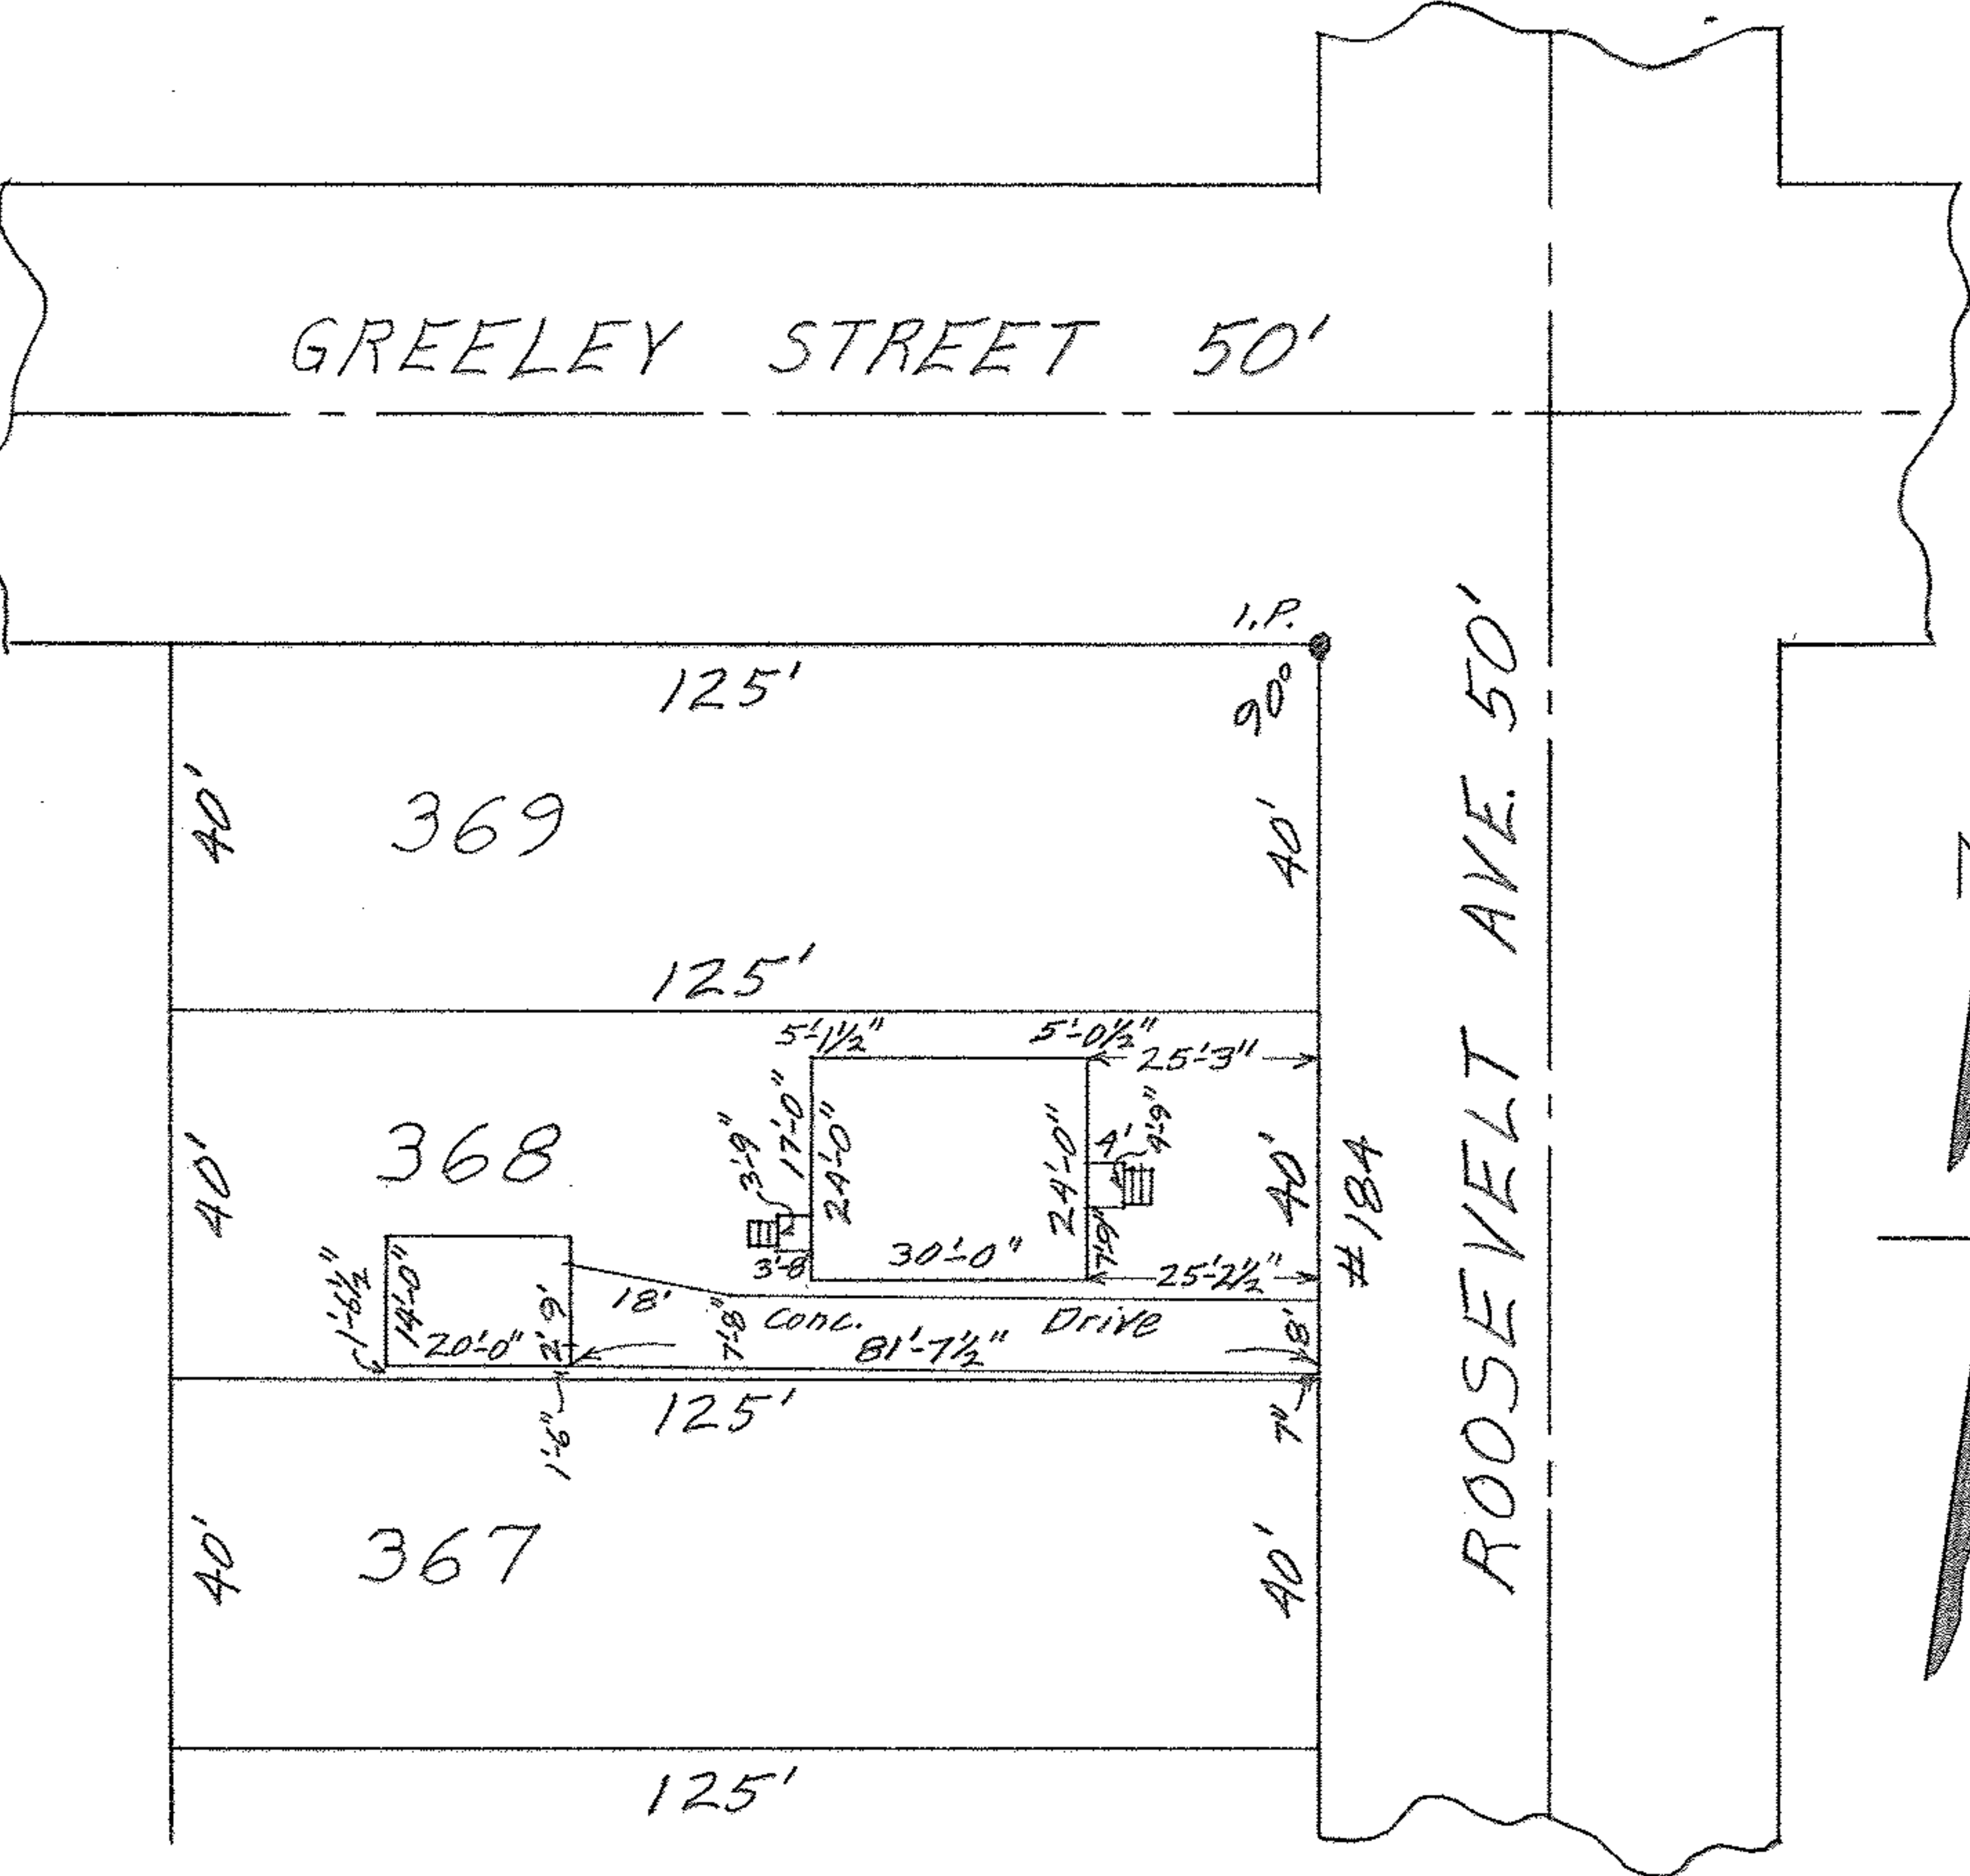

MAP OF SUB-LOT NO. 368

PASADENA PARK ALL'T. Vol. 10 Pg. 7  
ELYRIA TOWNSHIP ELYRIA CITY  
LORAIN COUNTY OHIO

SCALE: 1" = 30' MAY 2-1964 12:45 P.M.

Mary E. Penfound REG. SURVEYOR

Kenneth H. & Mary A. Bonnett WW