


06.25.020.108 001, 002
6-88
Scan # 45896



06.25.020.108 001, 002
6-88
Scan # 45896

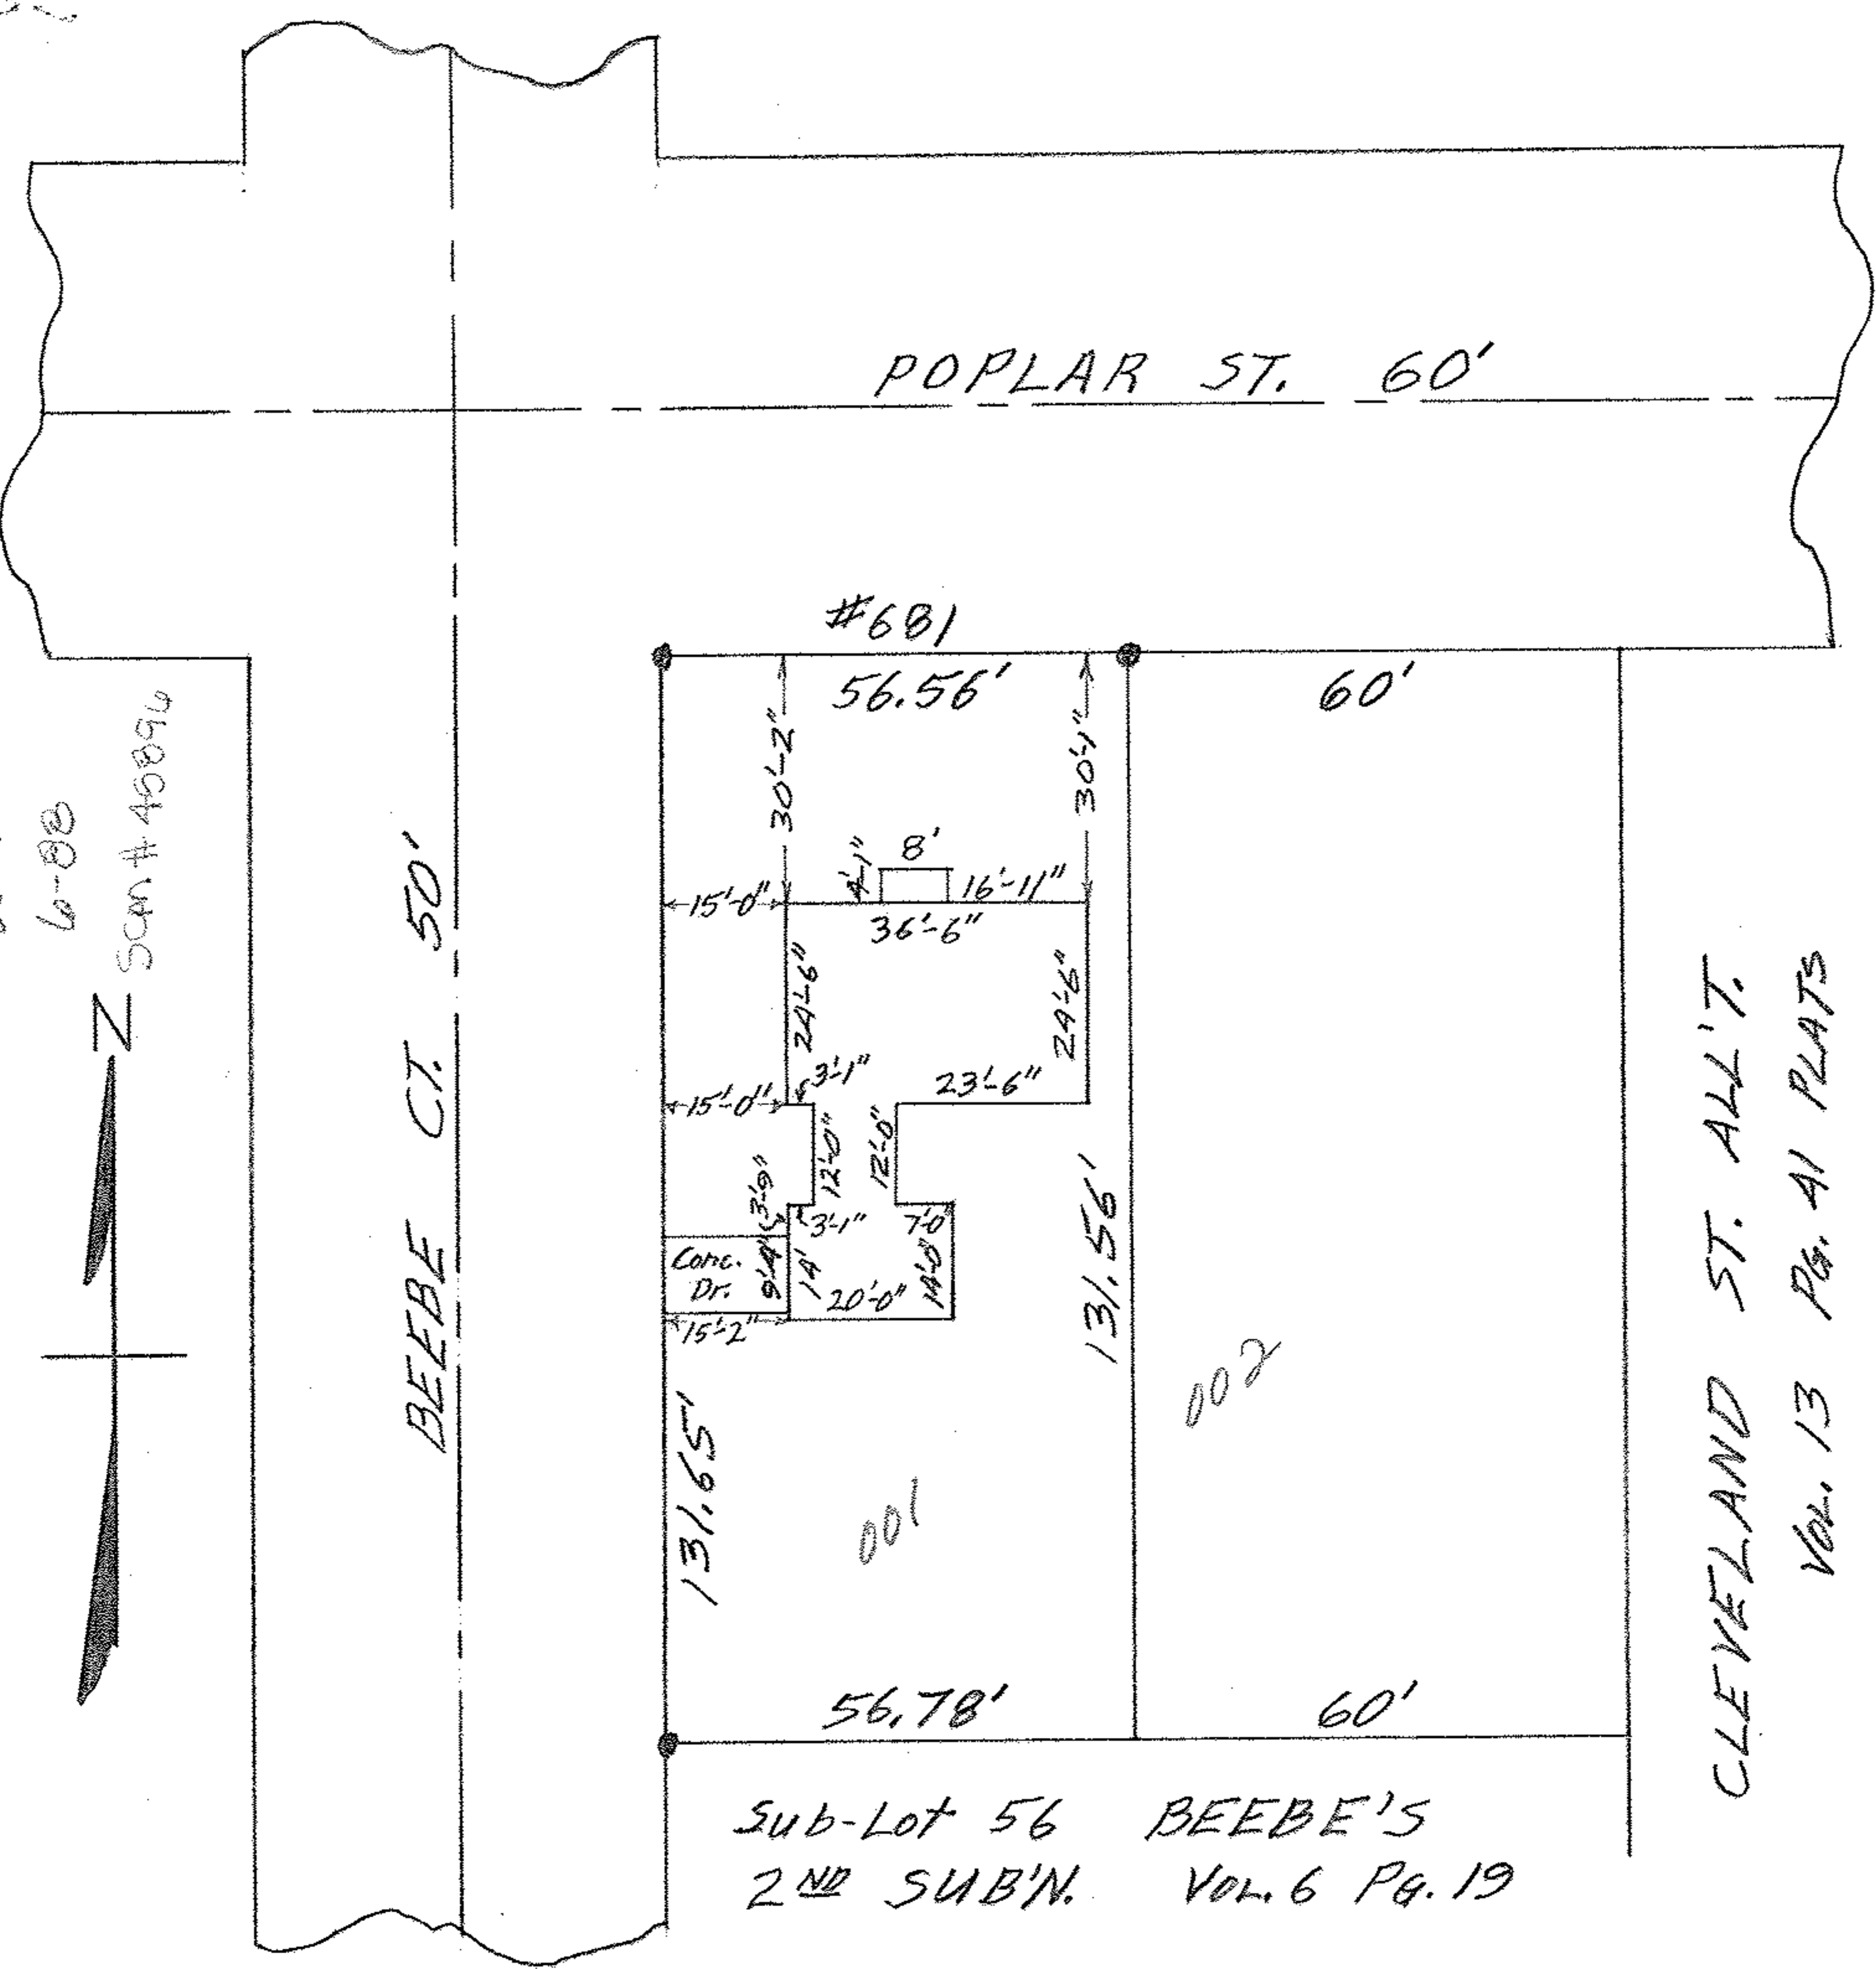

MAP OF PART OF ORIGINAL LOT 20,
EAST OF BLACK RIVER - ELYRIA TWP.
ELYRIA CITY - LORAIN COUNTY - OHIO
SCALE: 1" = 30' DEL. 15-1961 3:00 P.M.
Gary E. Penfound REG. SURVEYOR

Dan D. & Betty J. Pribich WW