


06.25.020.108.227.228  
6-80

SCAN # 45897

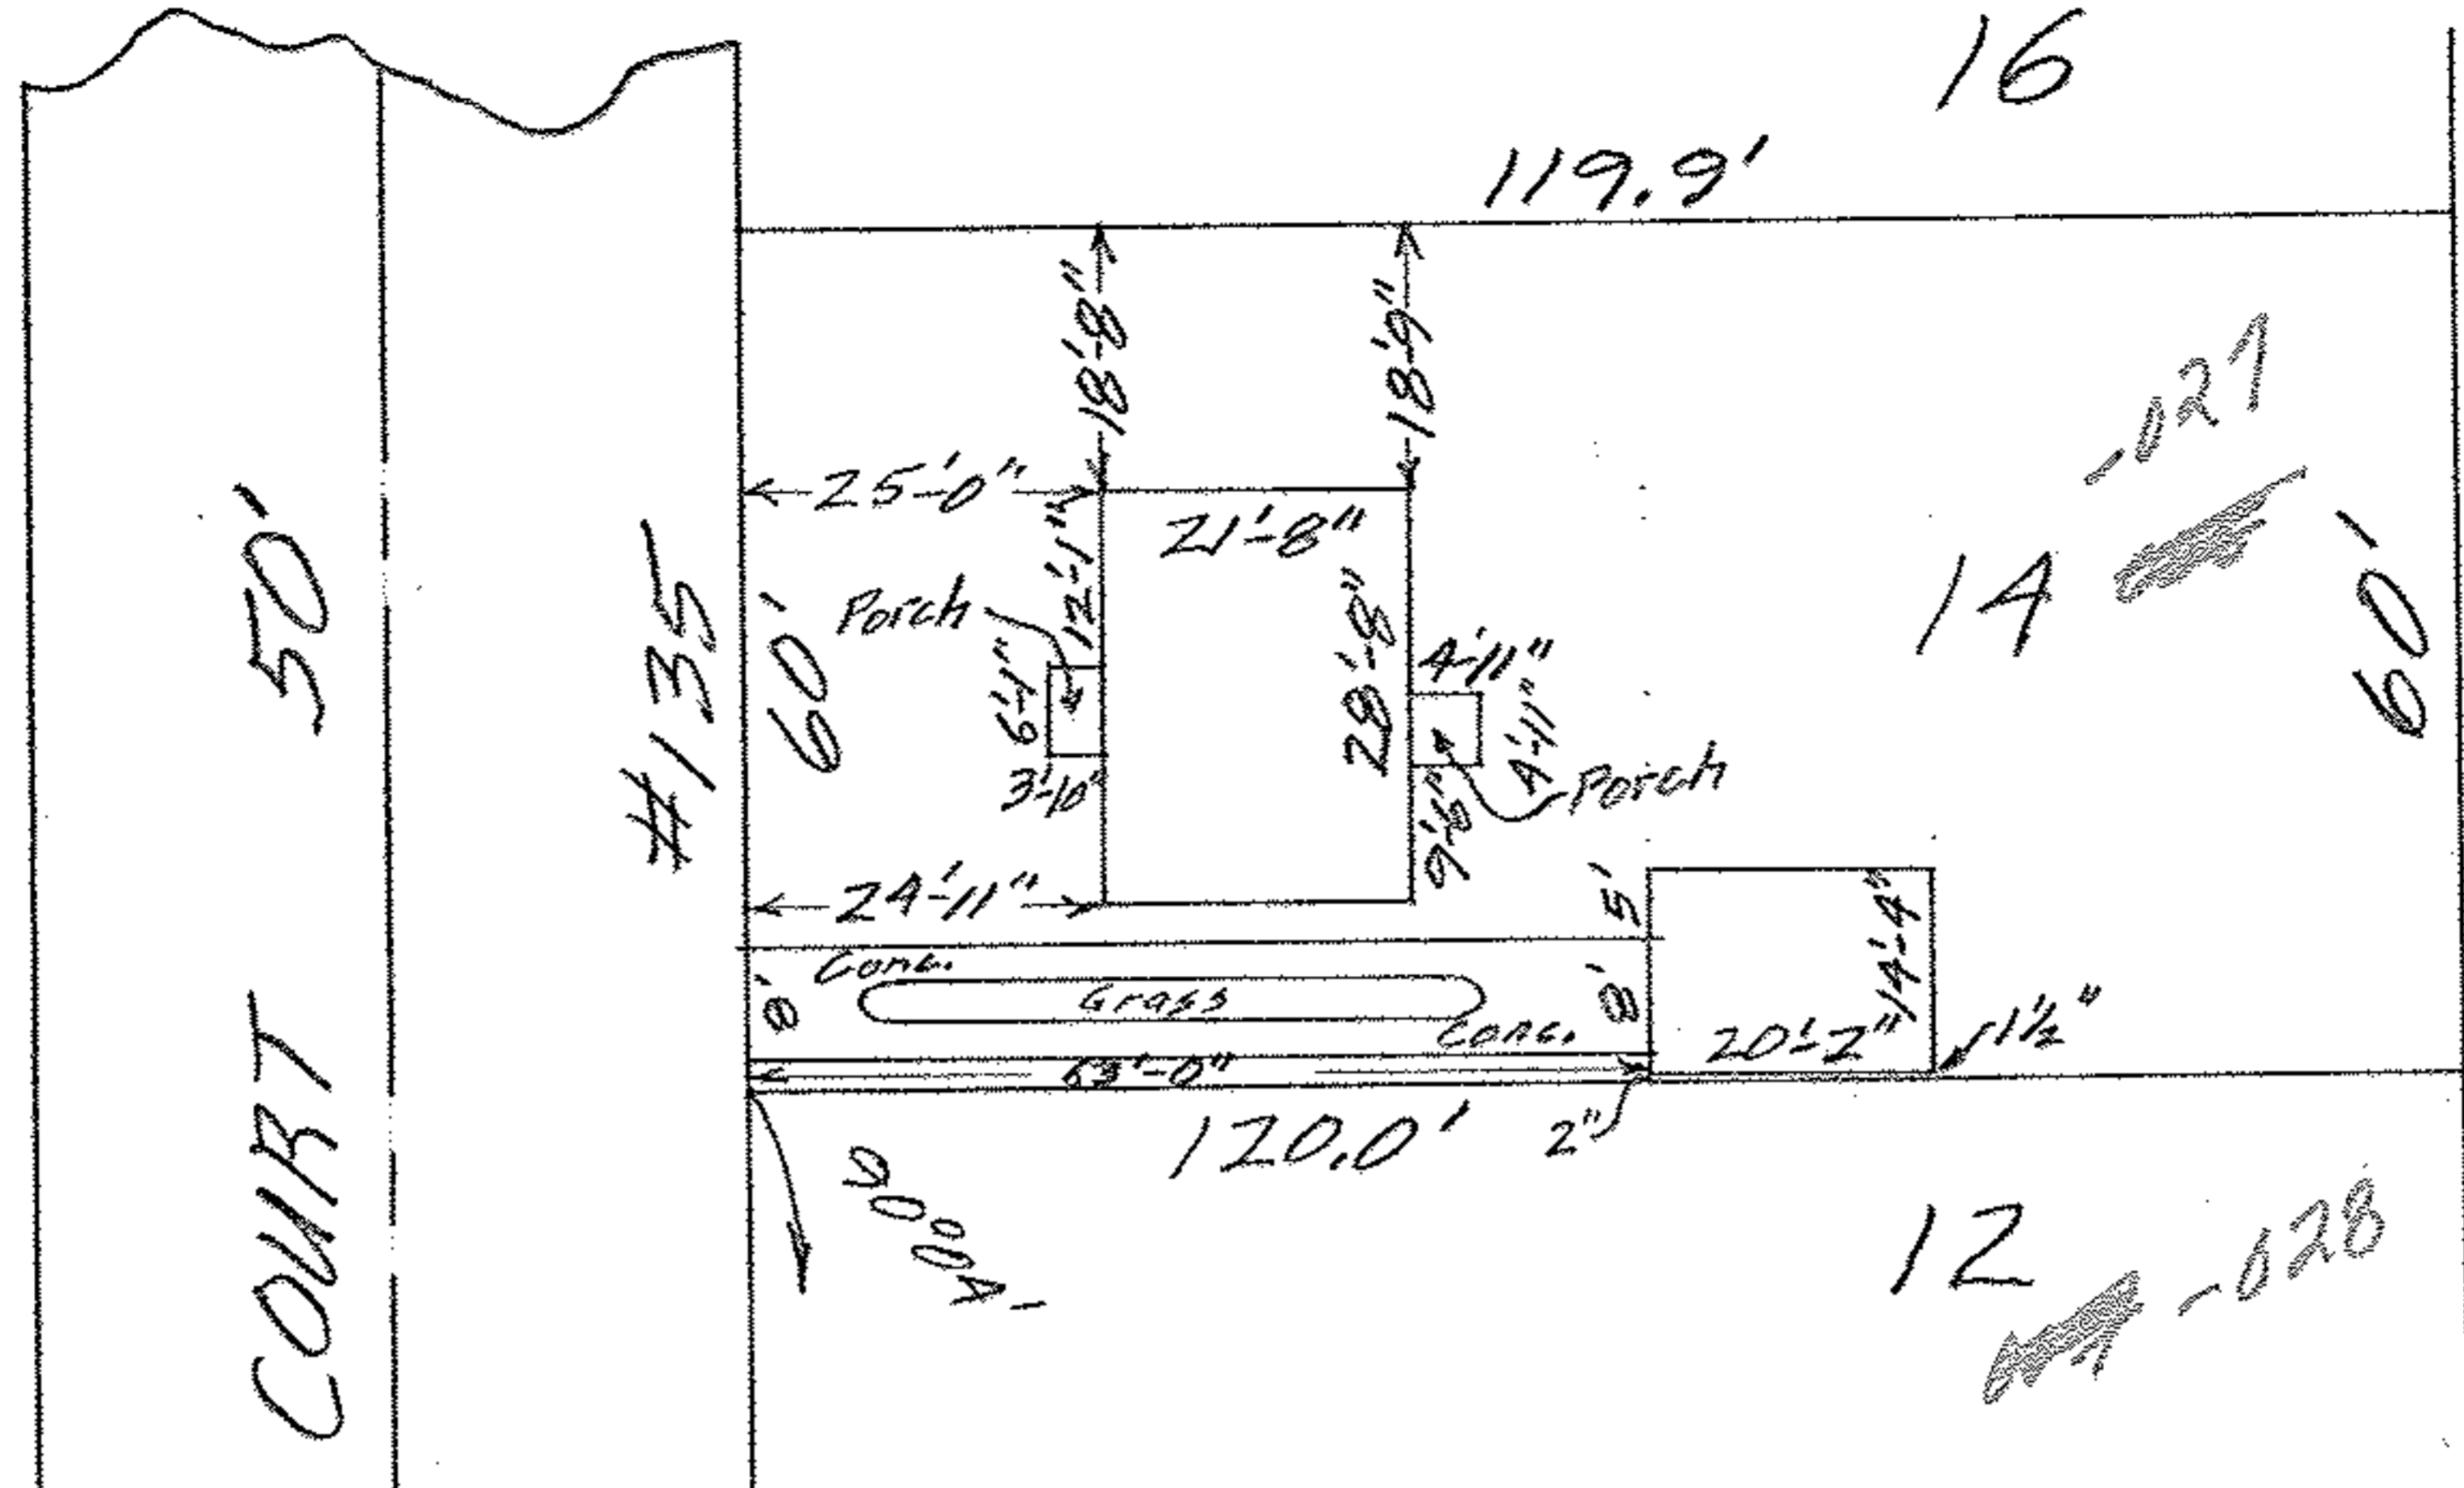

BEEBE

378.95'

CLEVELAND STREET

66'

MAP OF SUB-LOT NO. 14  
 BEEBE'S SUB'N. Vol. 5 Pg. 18 PLATS  
 O.L. 20, EAST OF RIVER, ELYRIA TOWNSHIP  
 ELYRIA CITY - LORAIN COUNTY - OHIO  
 SCALE: 1" = 30' DEC. 2, 1963 2:15 P.M.  
 Mary E. Penfound REG. SURVEYOR  
 Ronald E. & Jeanette I. Keim WW

06.25.020.108.227.228