
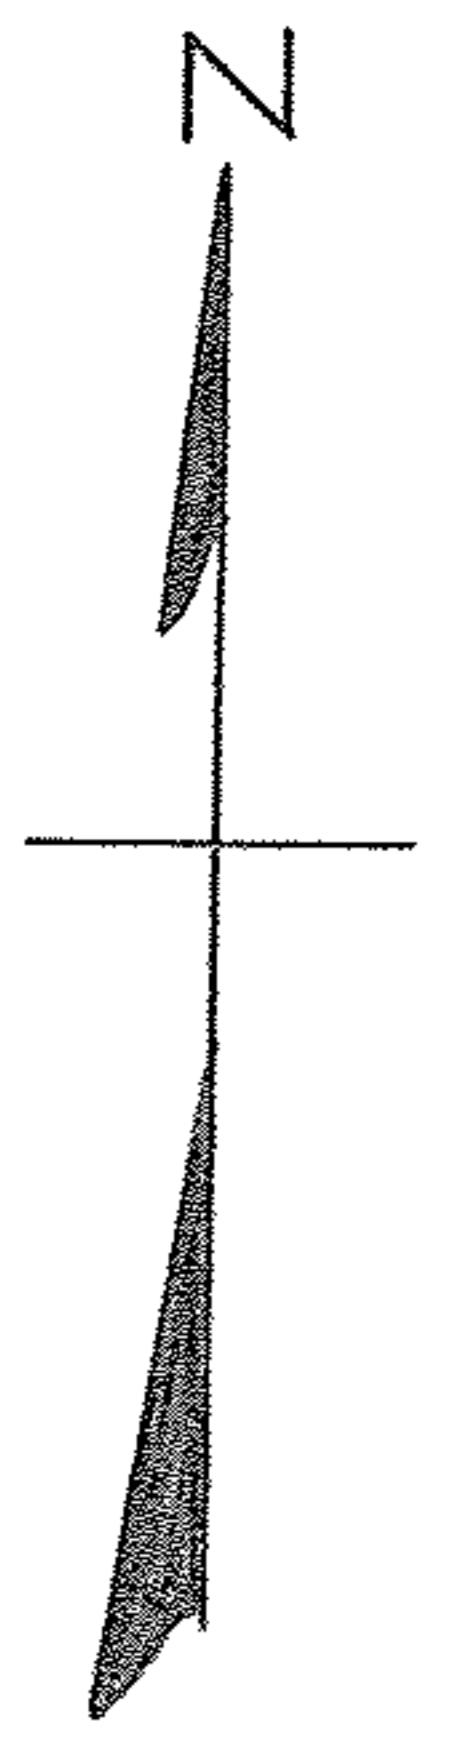


06-25-020.100,035,037
45090 6-88

06-25-020.100,035,037
45090 6-88

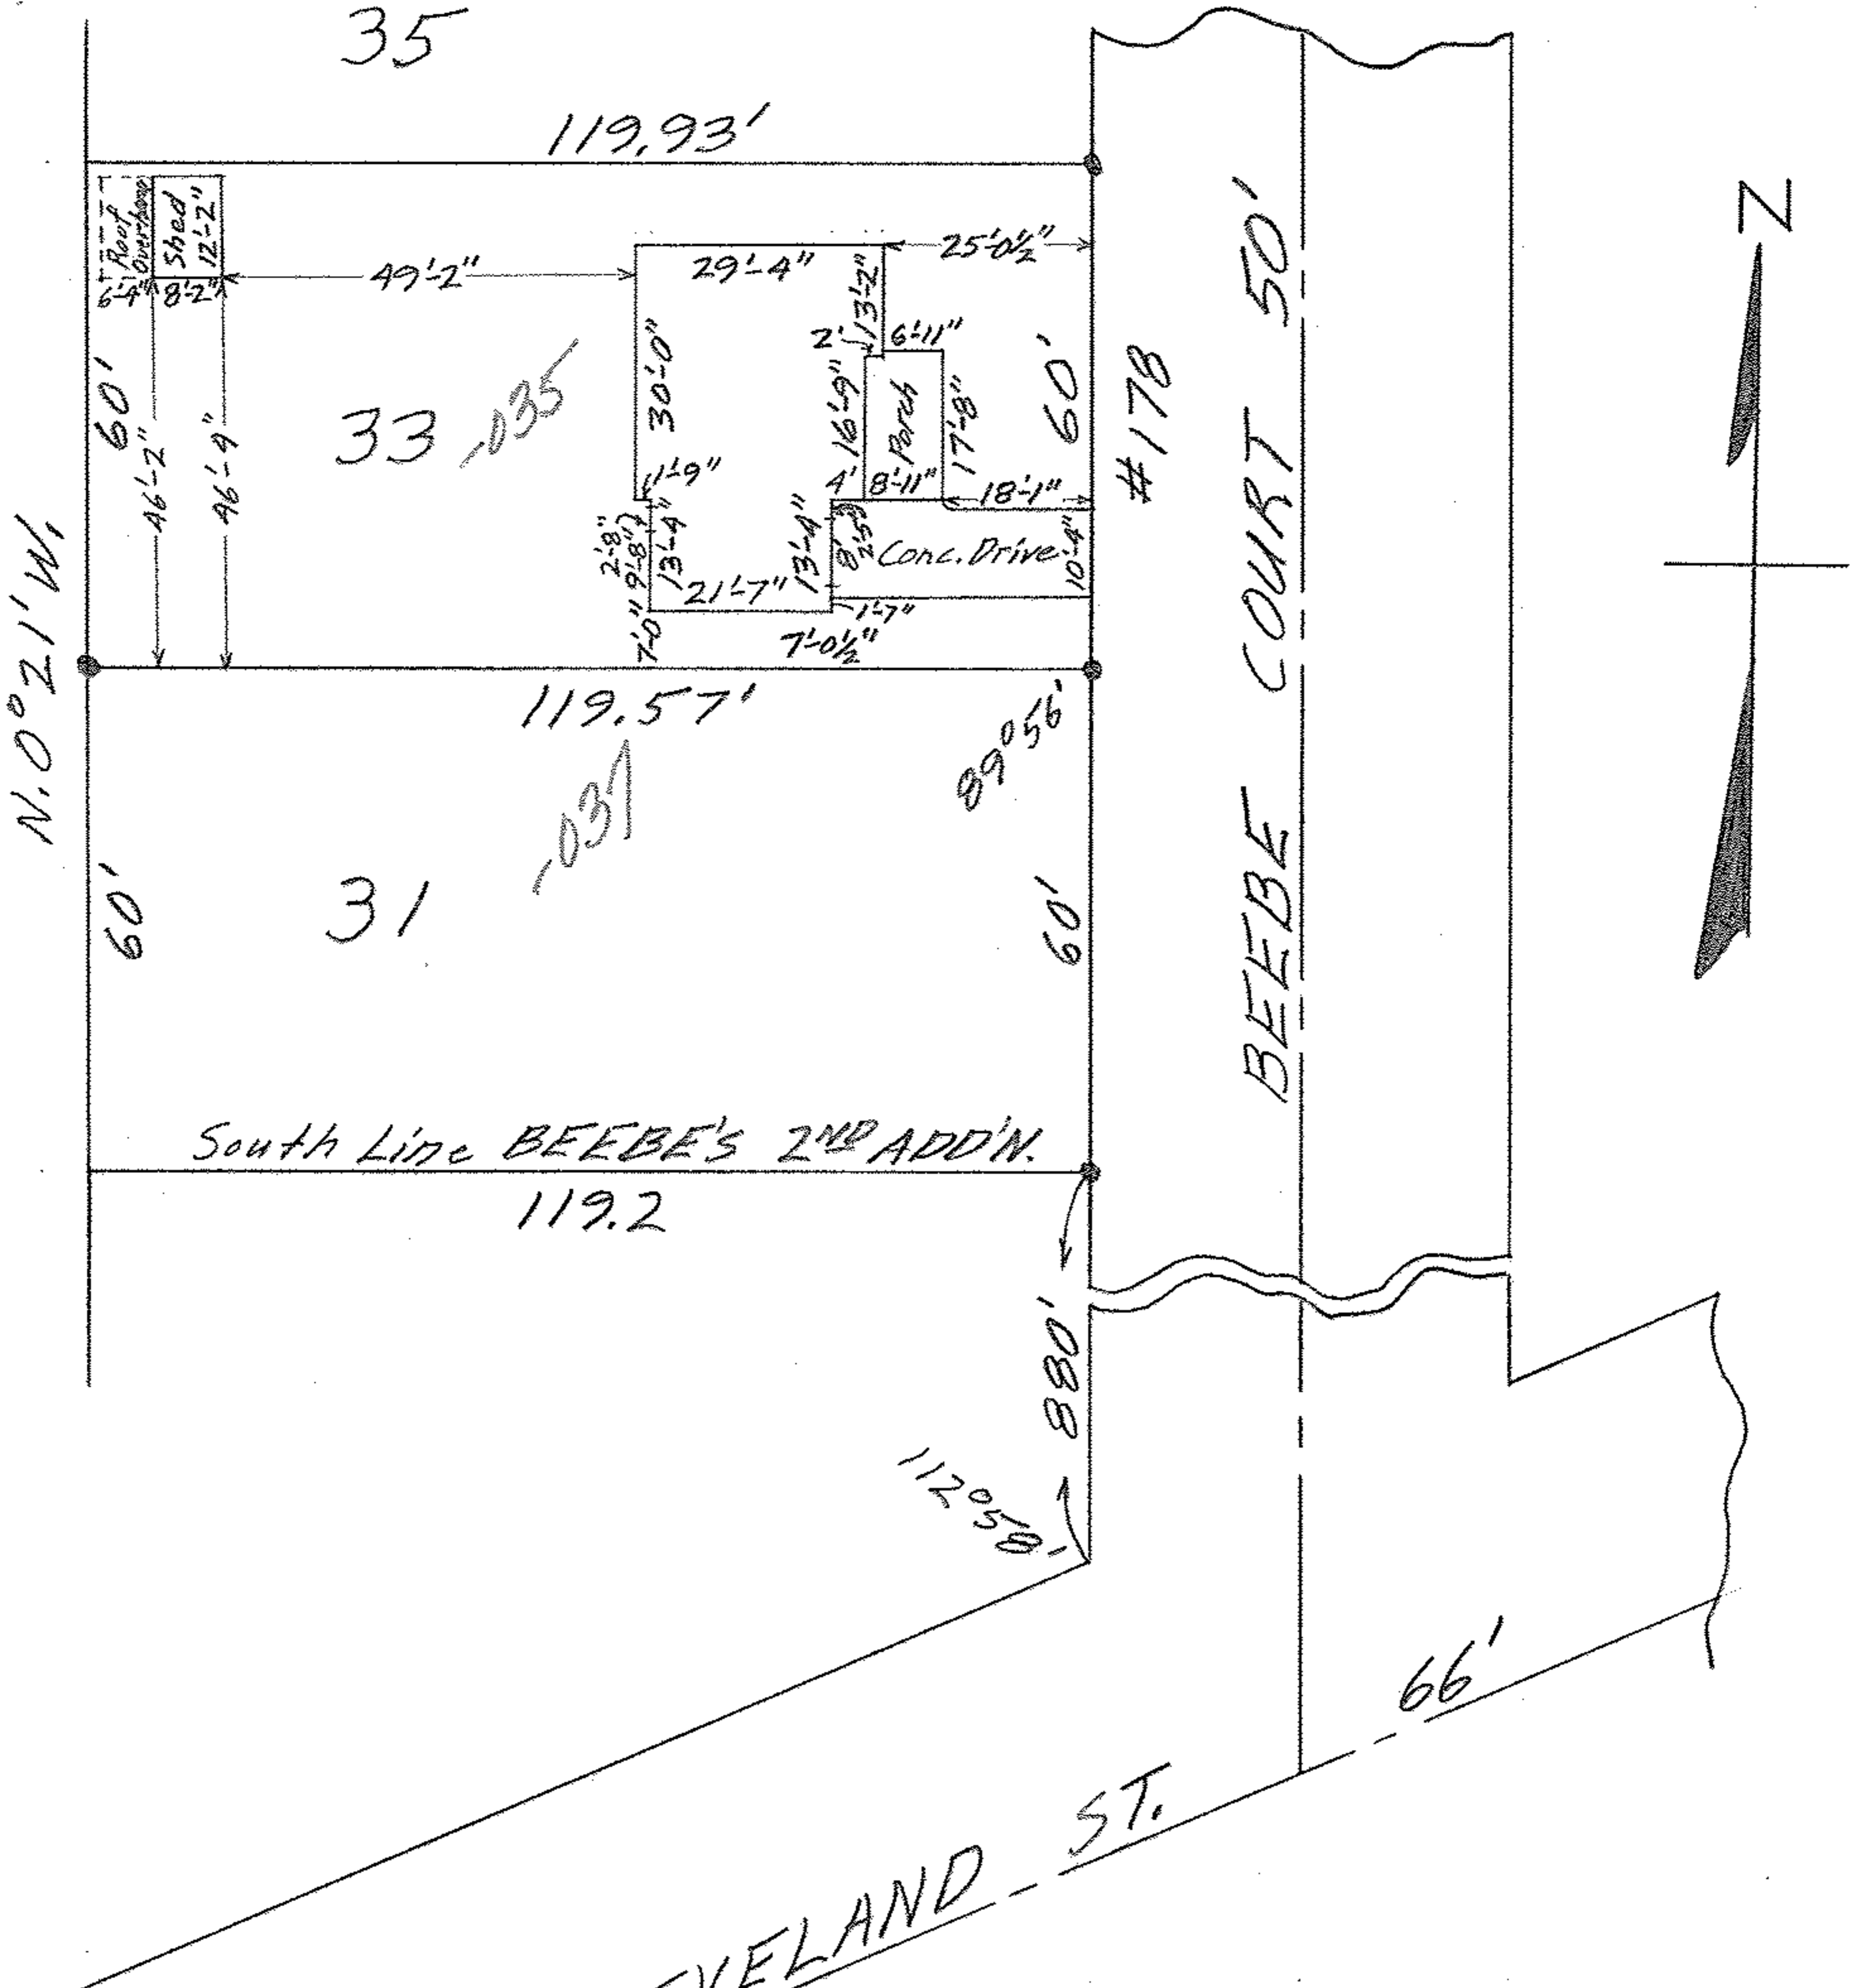

MAP OF SUB-LOT NO. 33
 BEEBE'S 2ND ADD'N. VOL. 6 Pg. 19
 ELYRIA TWP. ELYRIA CITY
 LORAIN COUNTY OHIO
 SCALE: 1"=30' AUG. 8-1963 4:00 P.M.
 Mary E. Penfound REG. SURVEYOR
 Bobby Lewis Drake & Barbara F. Drake W W