


06-25-022-101-033,034  
 6-71 SCAN#45905

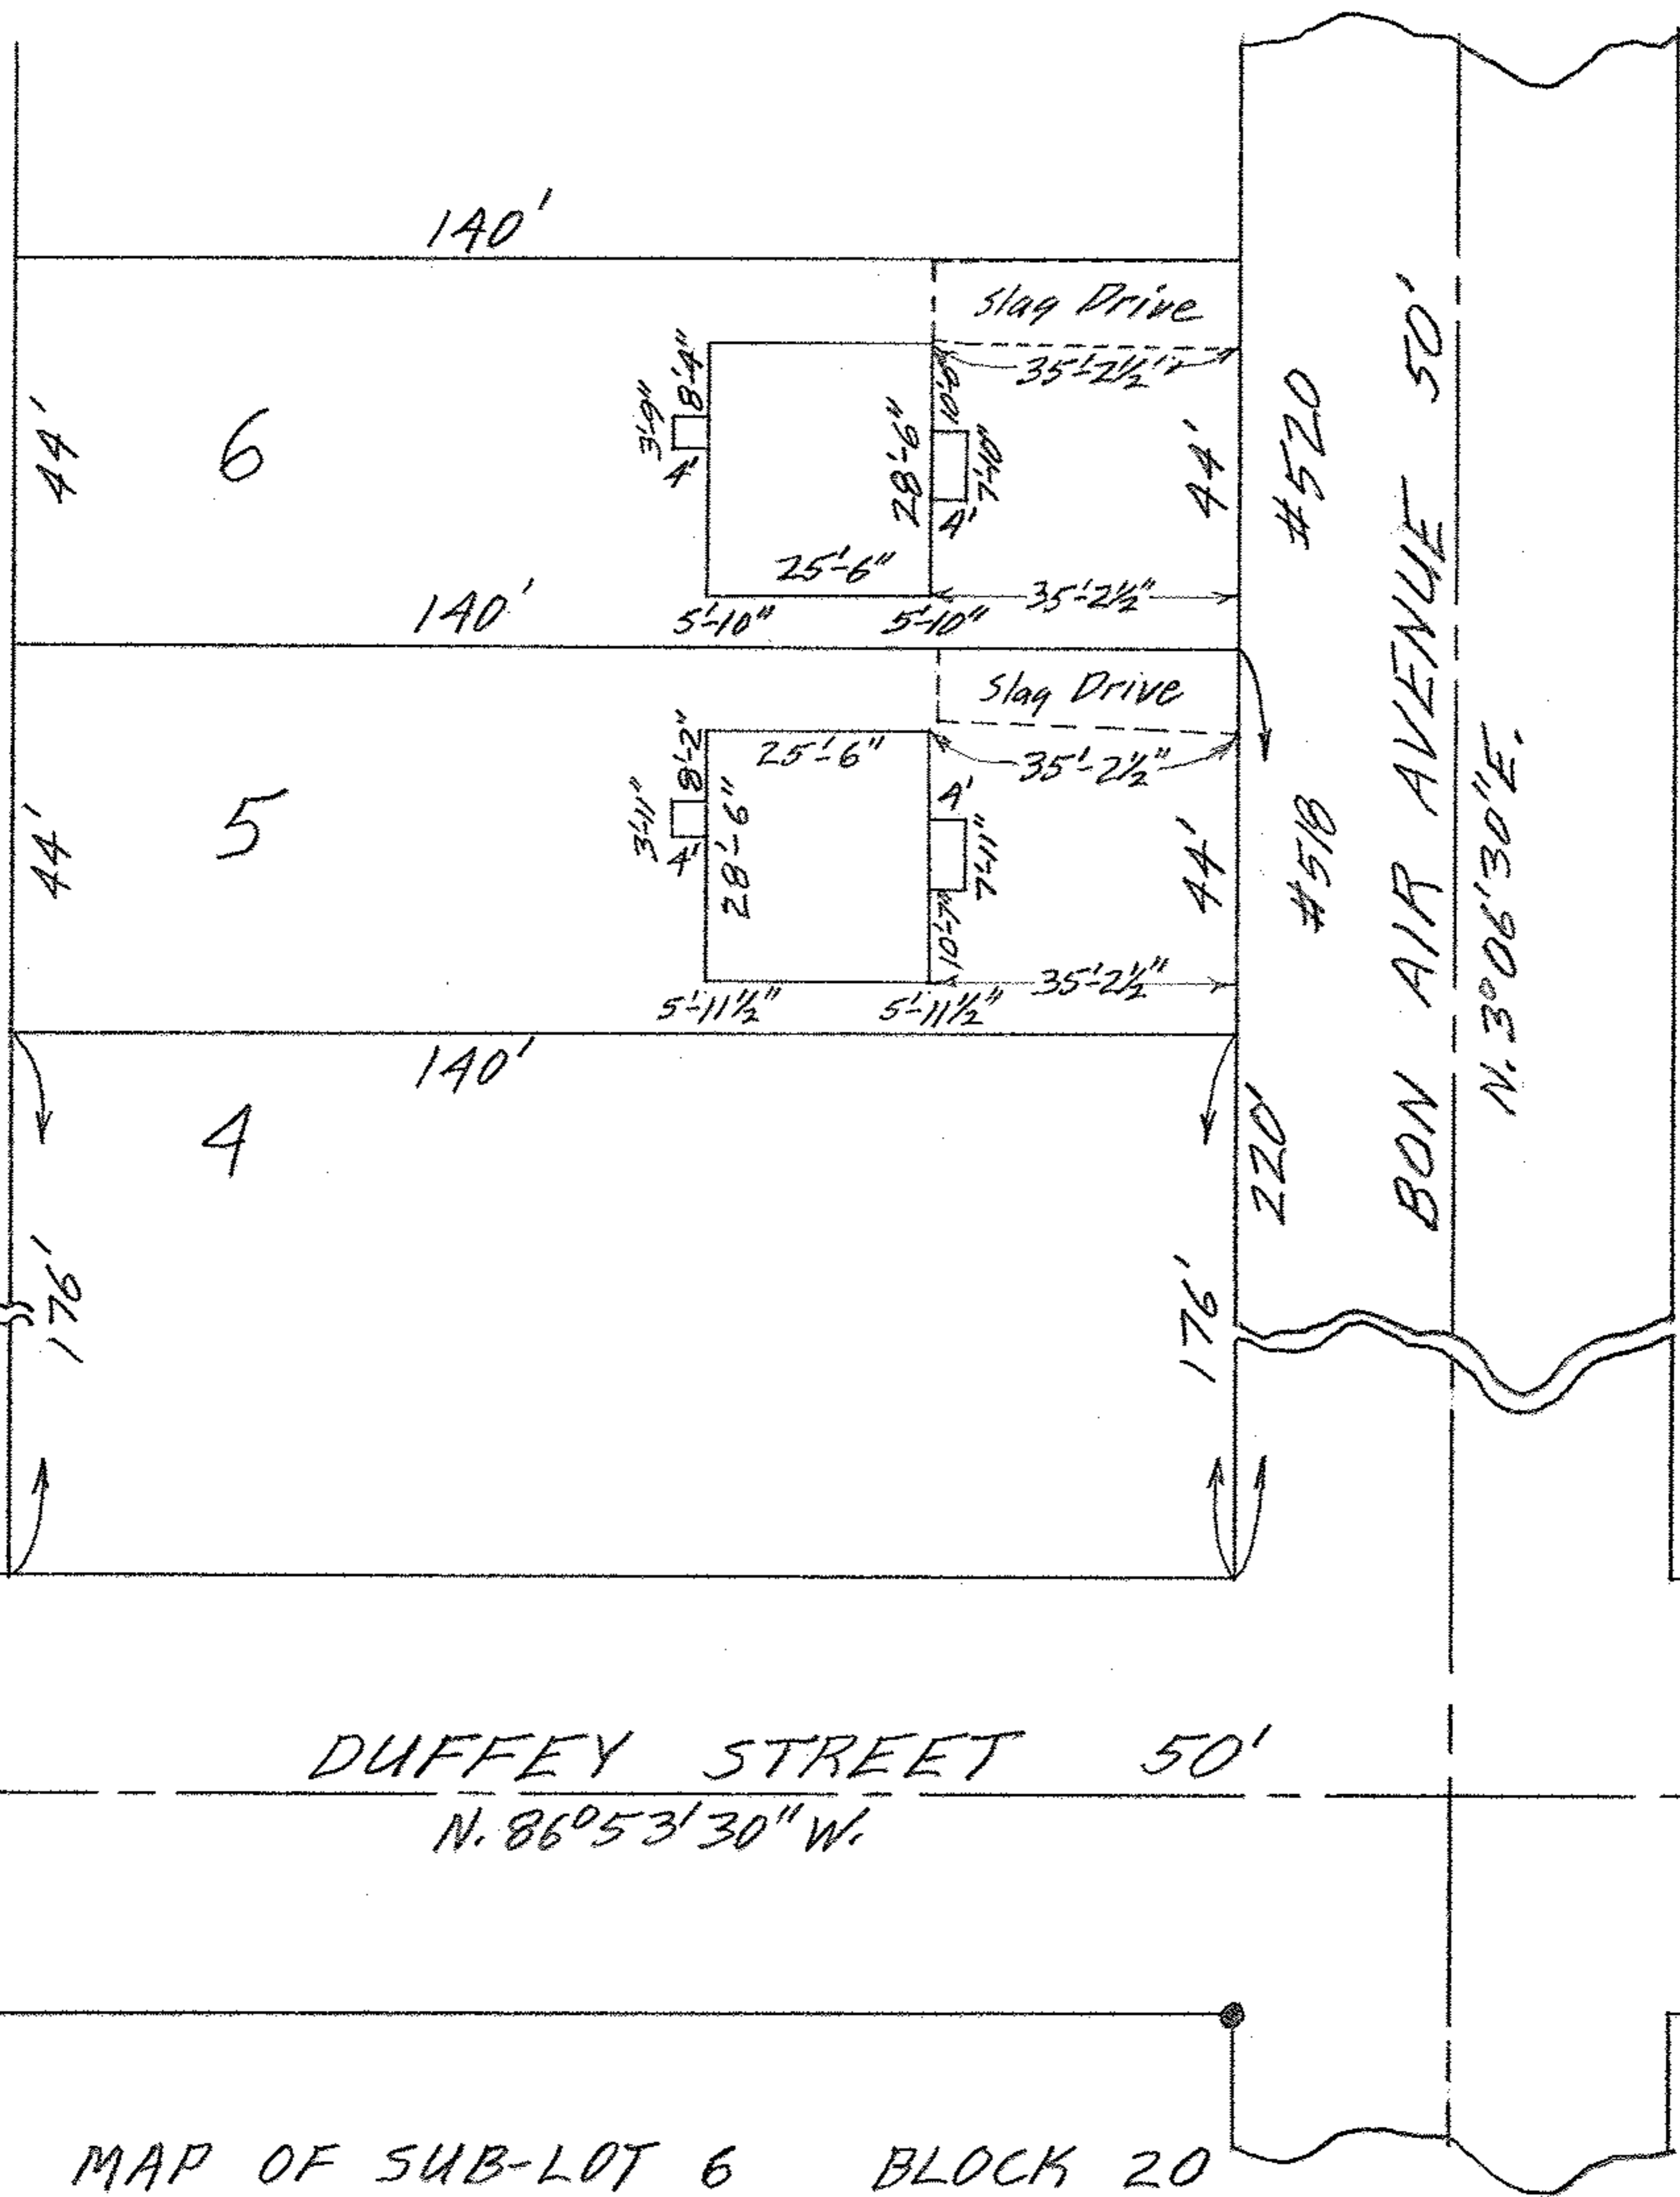

MAP OF SUB-LOT 6 BLOCK 20  
 CITY FARMS ALL'T. VOL. 9 PG. 3 PLATS  
 ELYRIA TWP. ELYRIA CITY  
 LORAIN COUNTY OHIO  
 SCALE: 1"=30' DEC. 27-1961 2:30 P.M.  
 Gary E. Penfound REG. SURVEYOR

David L. & Madeline Bentley