


06-25-022-101-036  
6-71 SCAN # 45908

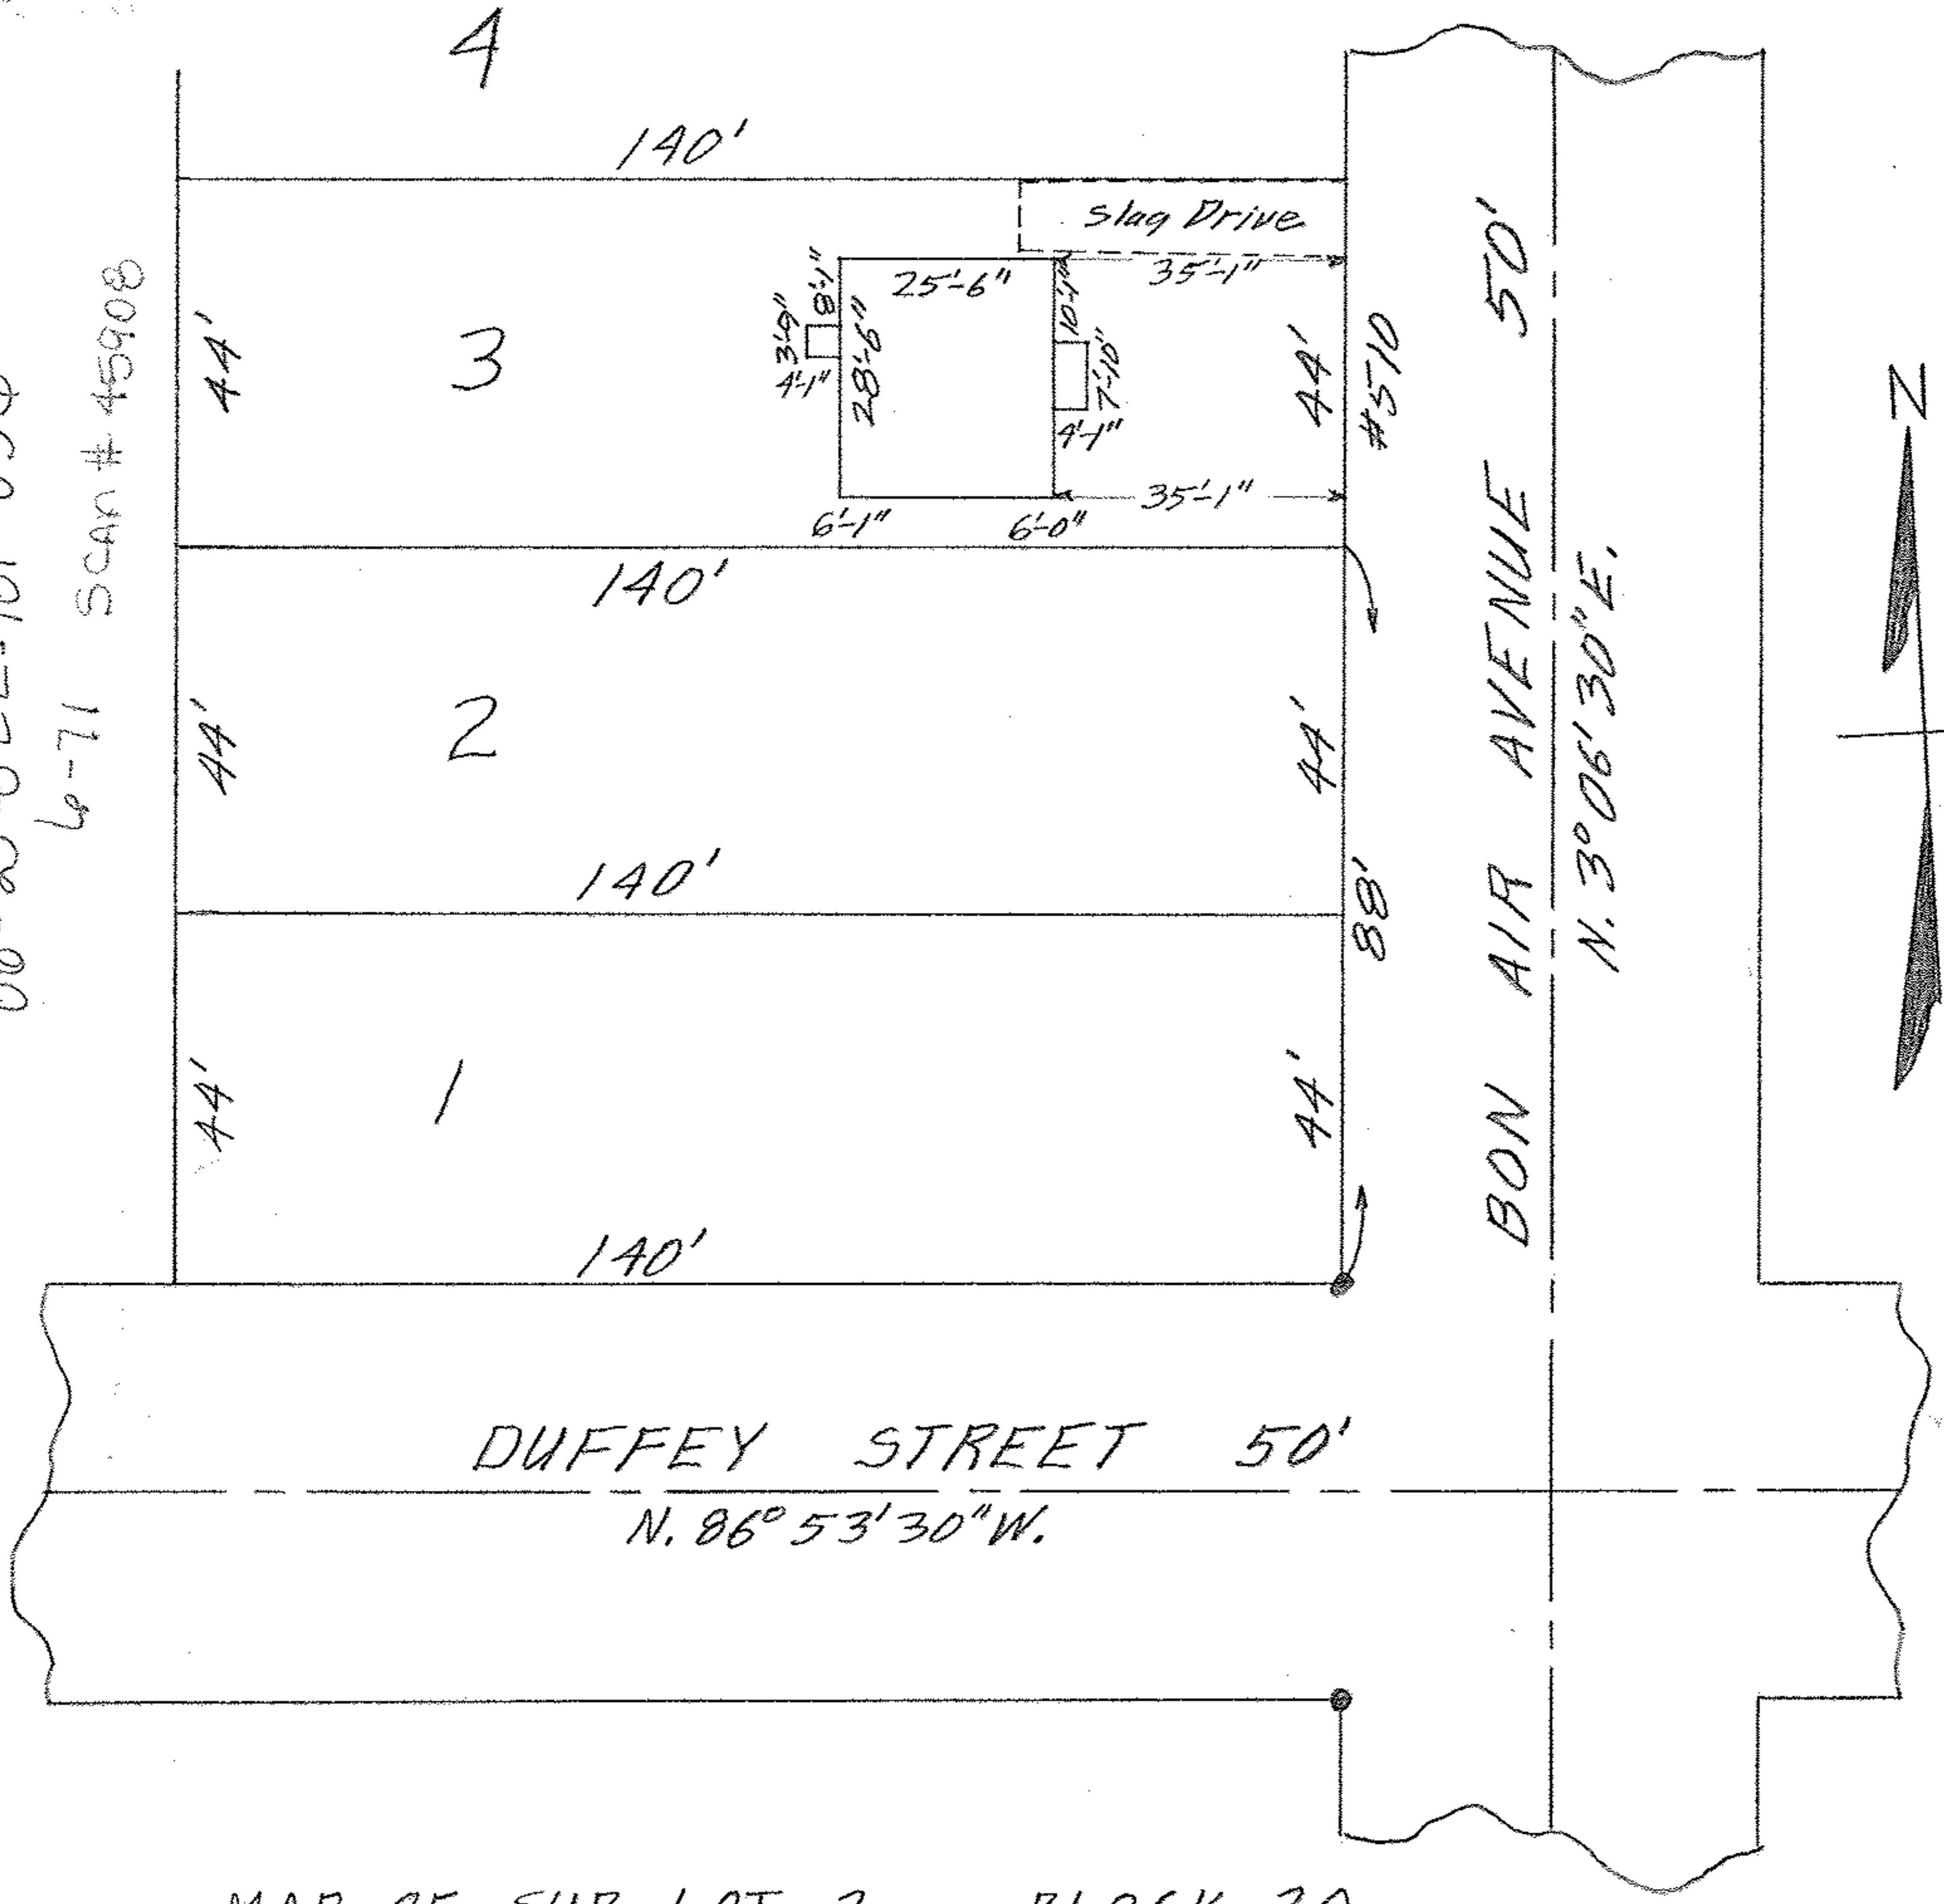

MAP OF SUB-LOT 3      BLOCK 20  
 CITY FARMS ALL'T.      VOL. 9 PG. 3 PLATS  
 ELYRIA TWP.              ELYRIA CITY  
 LORAIN COUNTY          OHIO

SCALE: 1" = 30'              JUNE 4-1962 2:00 P.M.  
 Gary E. Penfound          REG. SURVEYOR

Billy Jean Hopkins & Ella Nora Hopkins