


06-25-022-101-037

6-71

SCAN # 45909

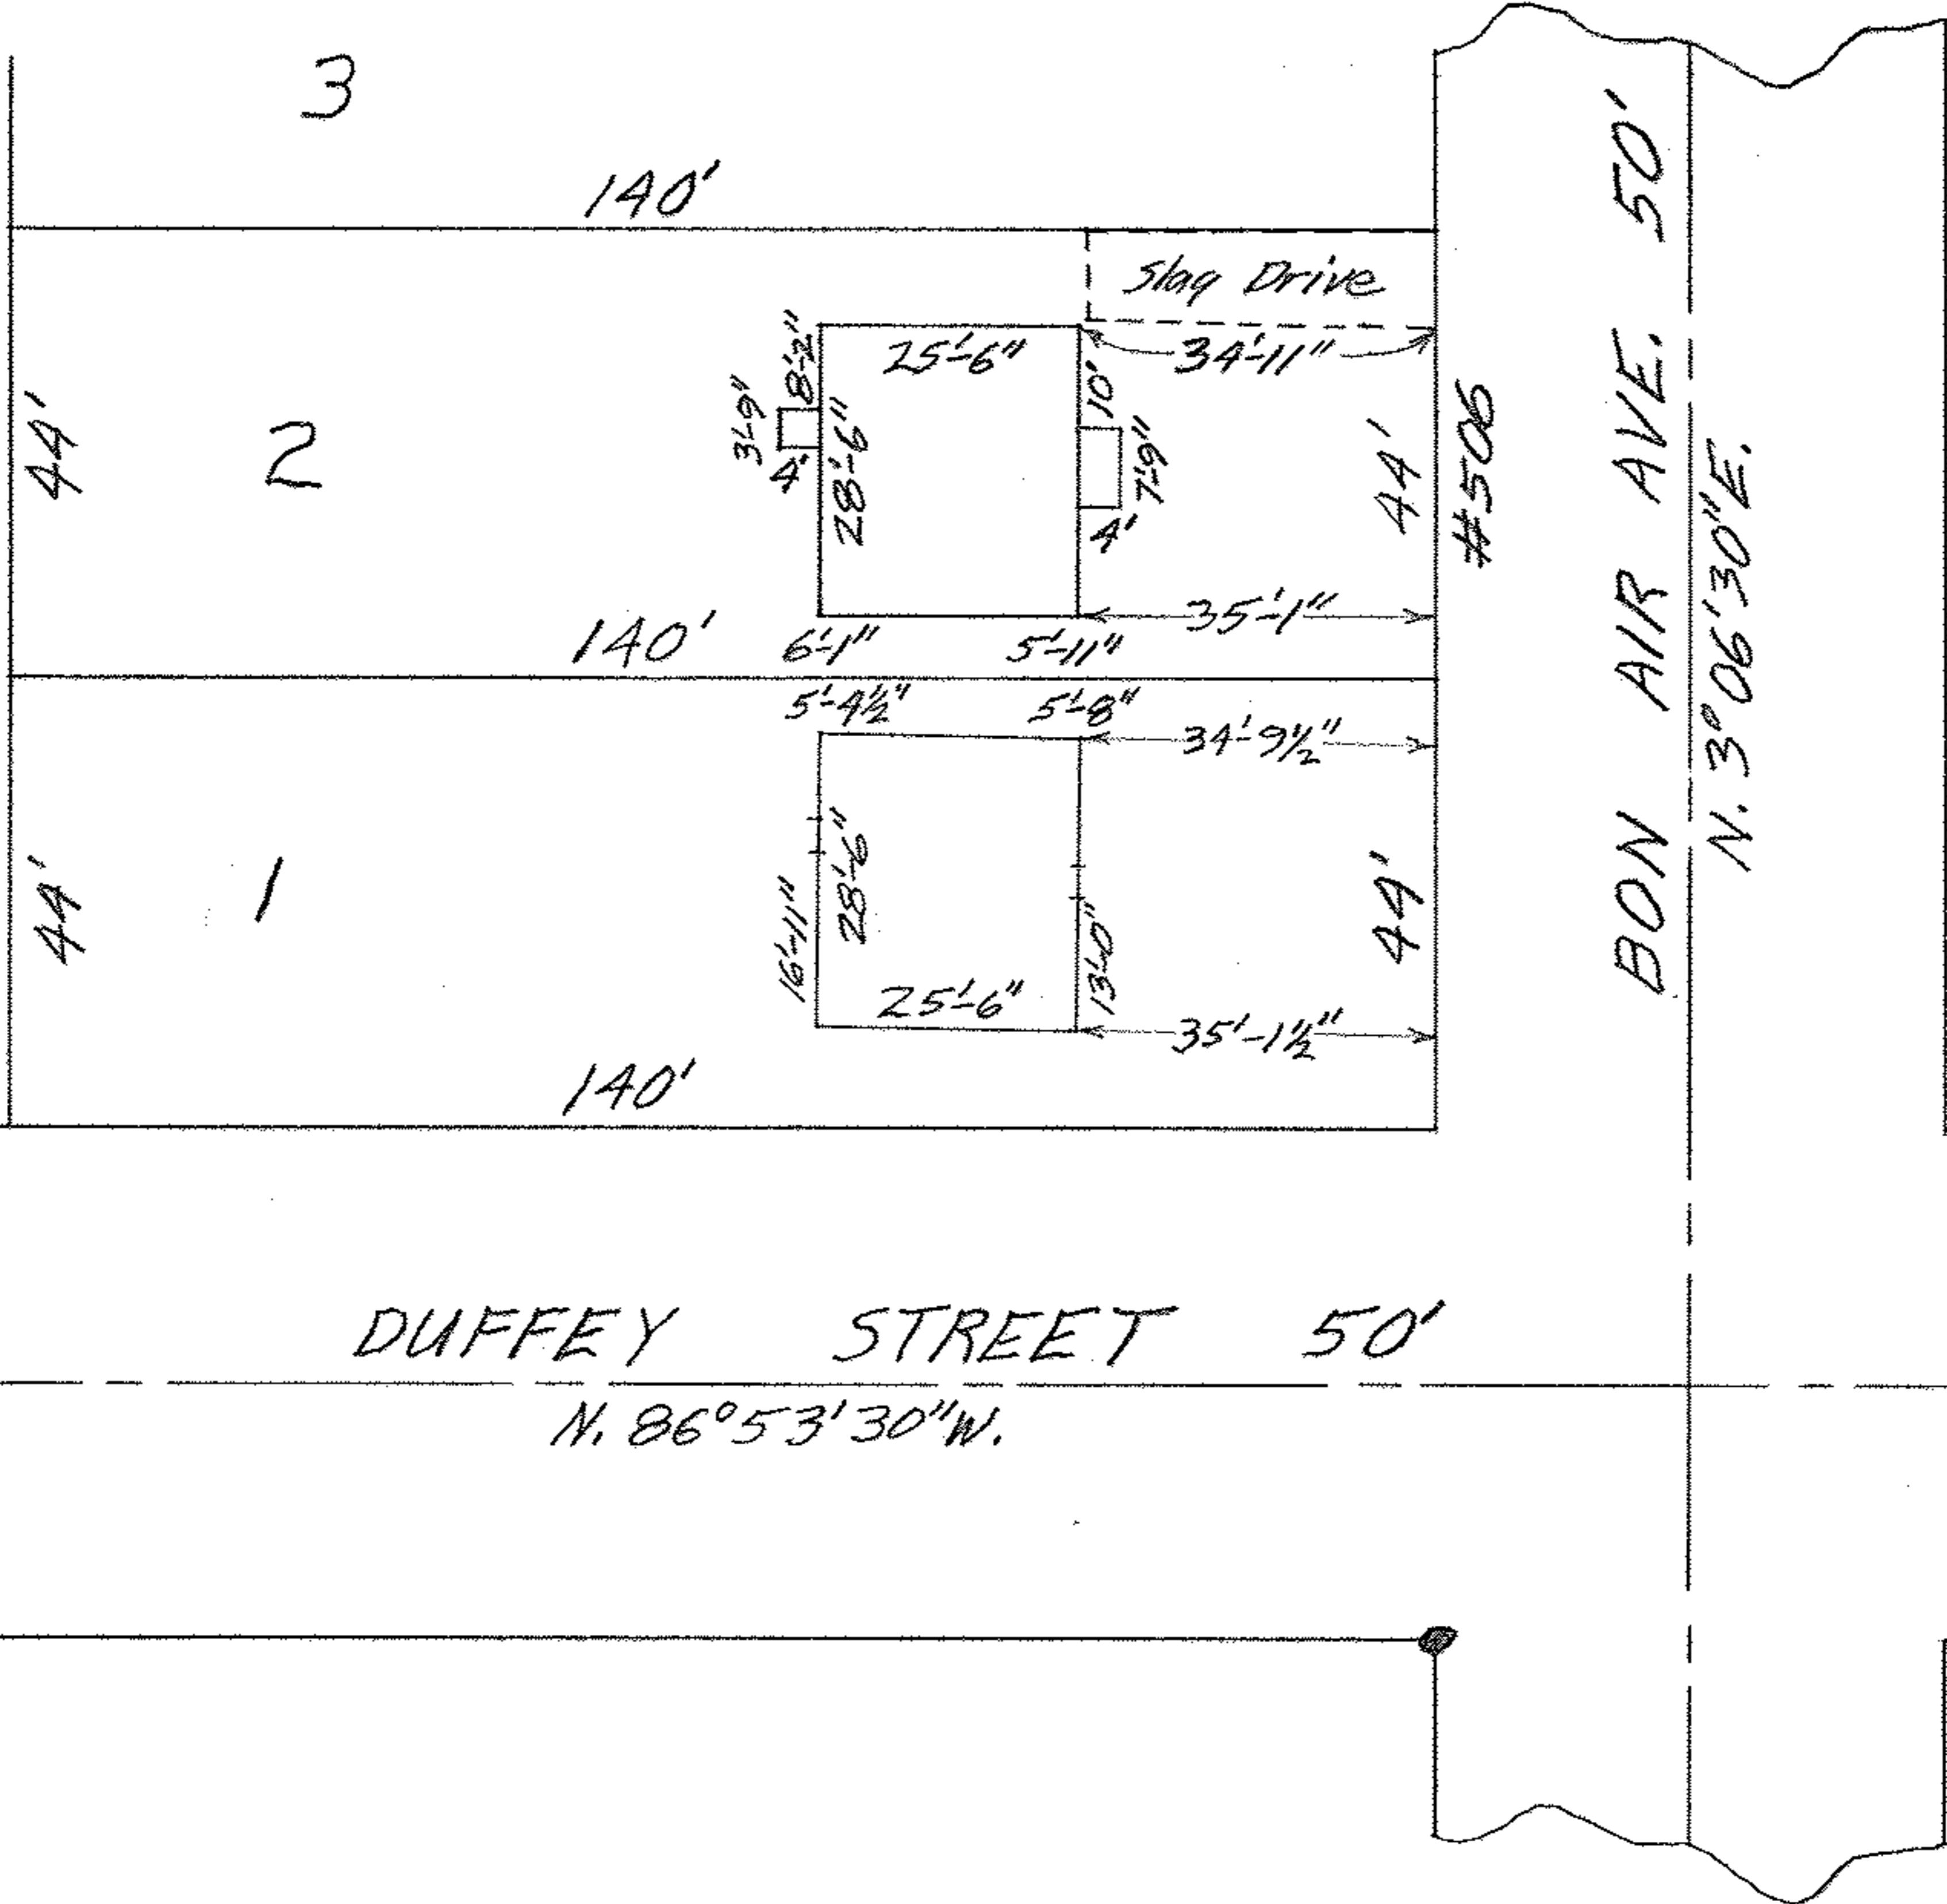

MAP OF SUB-LOT 2      BLOCK 20  
 CITY FARMS ALL'T.      VOL. 9 PG. 3 PLATS  
 ELYRIA TWP.      ELYRIA CITY  
 LORAIN COUNTY      OHIO  
 SCALE: 1"=30'      JANUARY 8, -1962 9:15 A.M.  
 Gary E. Penfound      REG. SURVEYOR

Artie Z. & Helen J. Rice