


06-25-022-102-032, 033

6-71 SCAN #45961

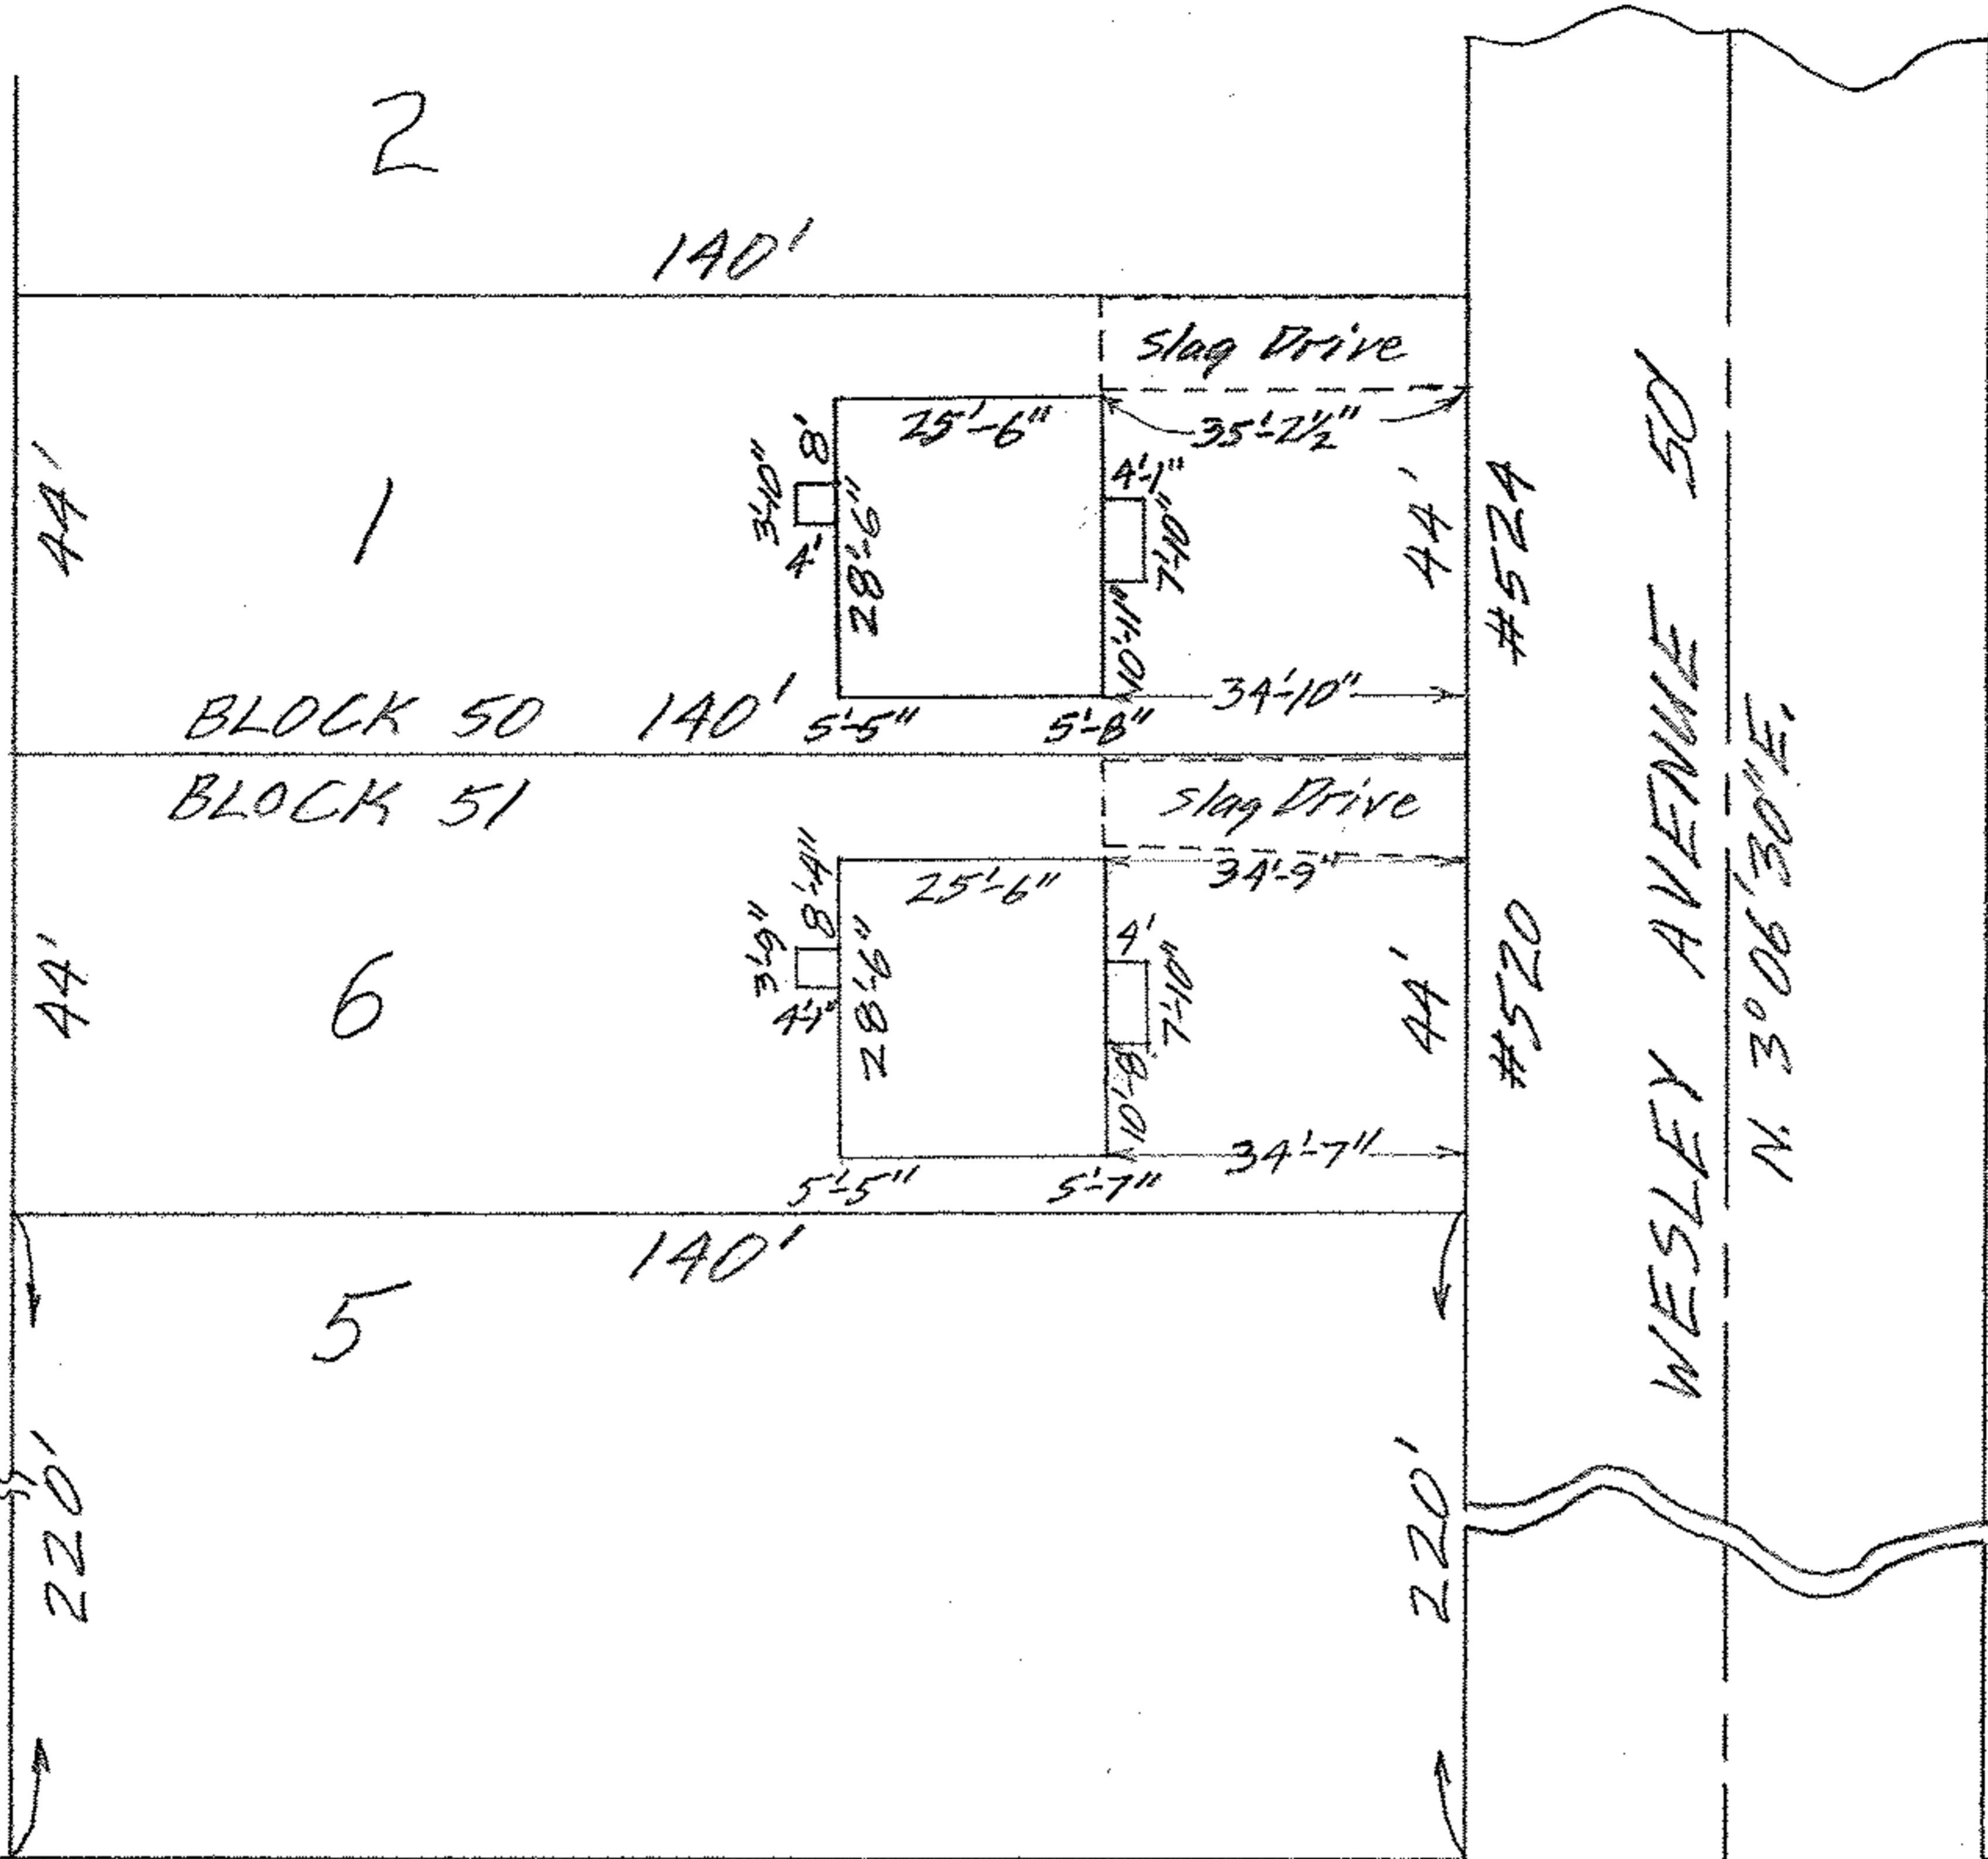

DUFFEY STREET 50'  
 N. 86°53'30"W.

MAP OF SUB-LOT 1 BLOCK 50  
 CITY FARMS ALL'T. VOL. 9 PG. 3 PLATS  
 ELYRIA TOWNSHIP ELYRIA CITY  
 LORAIN COUNTY OHIO

SCALE: 1" = 30' JAN. 22-1962 9:30 A.M.

Mary E. Penfound

REG. SURVEYOR

Richard D. Roberts