


06-29-22-105-009
68-9
SCAN # 45915

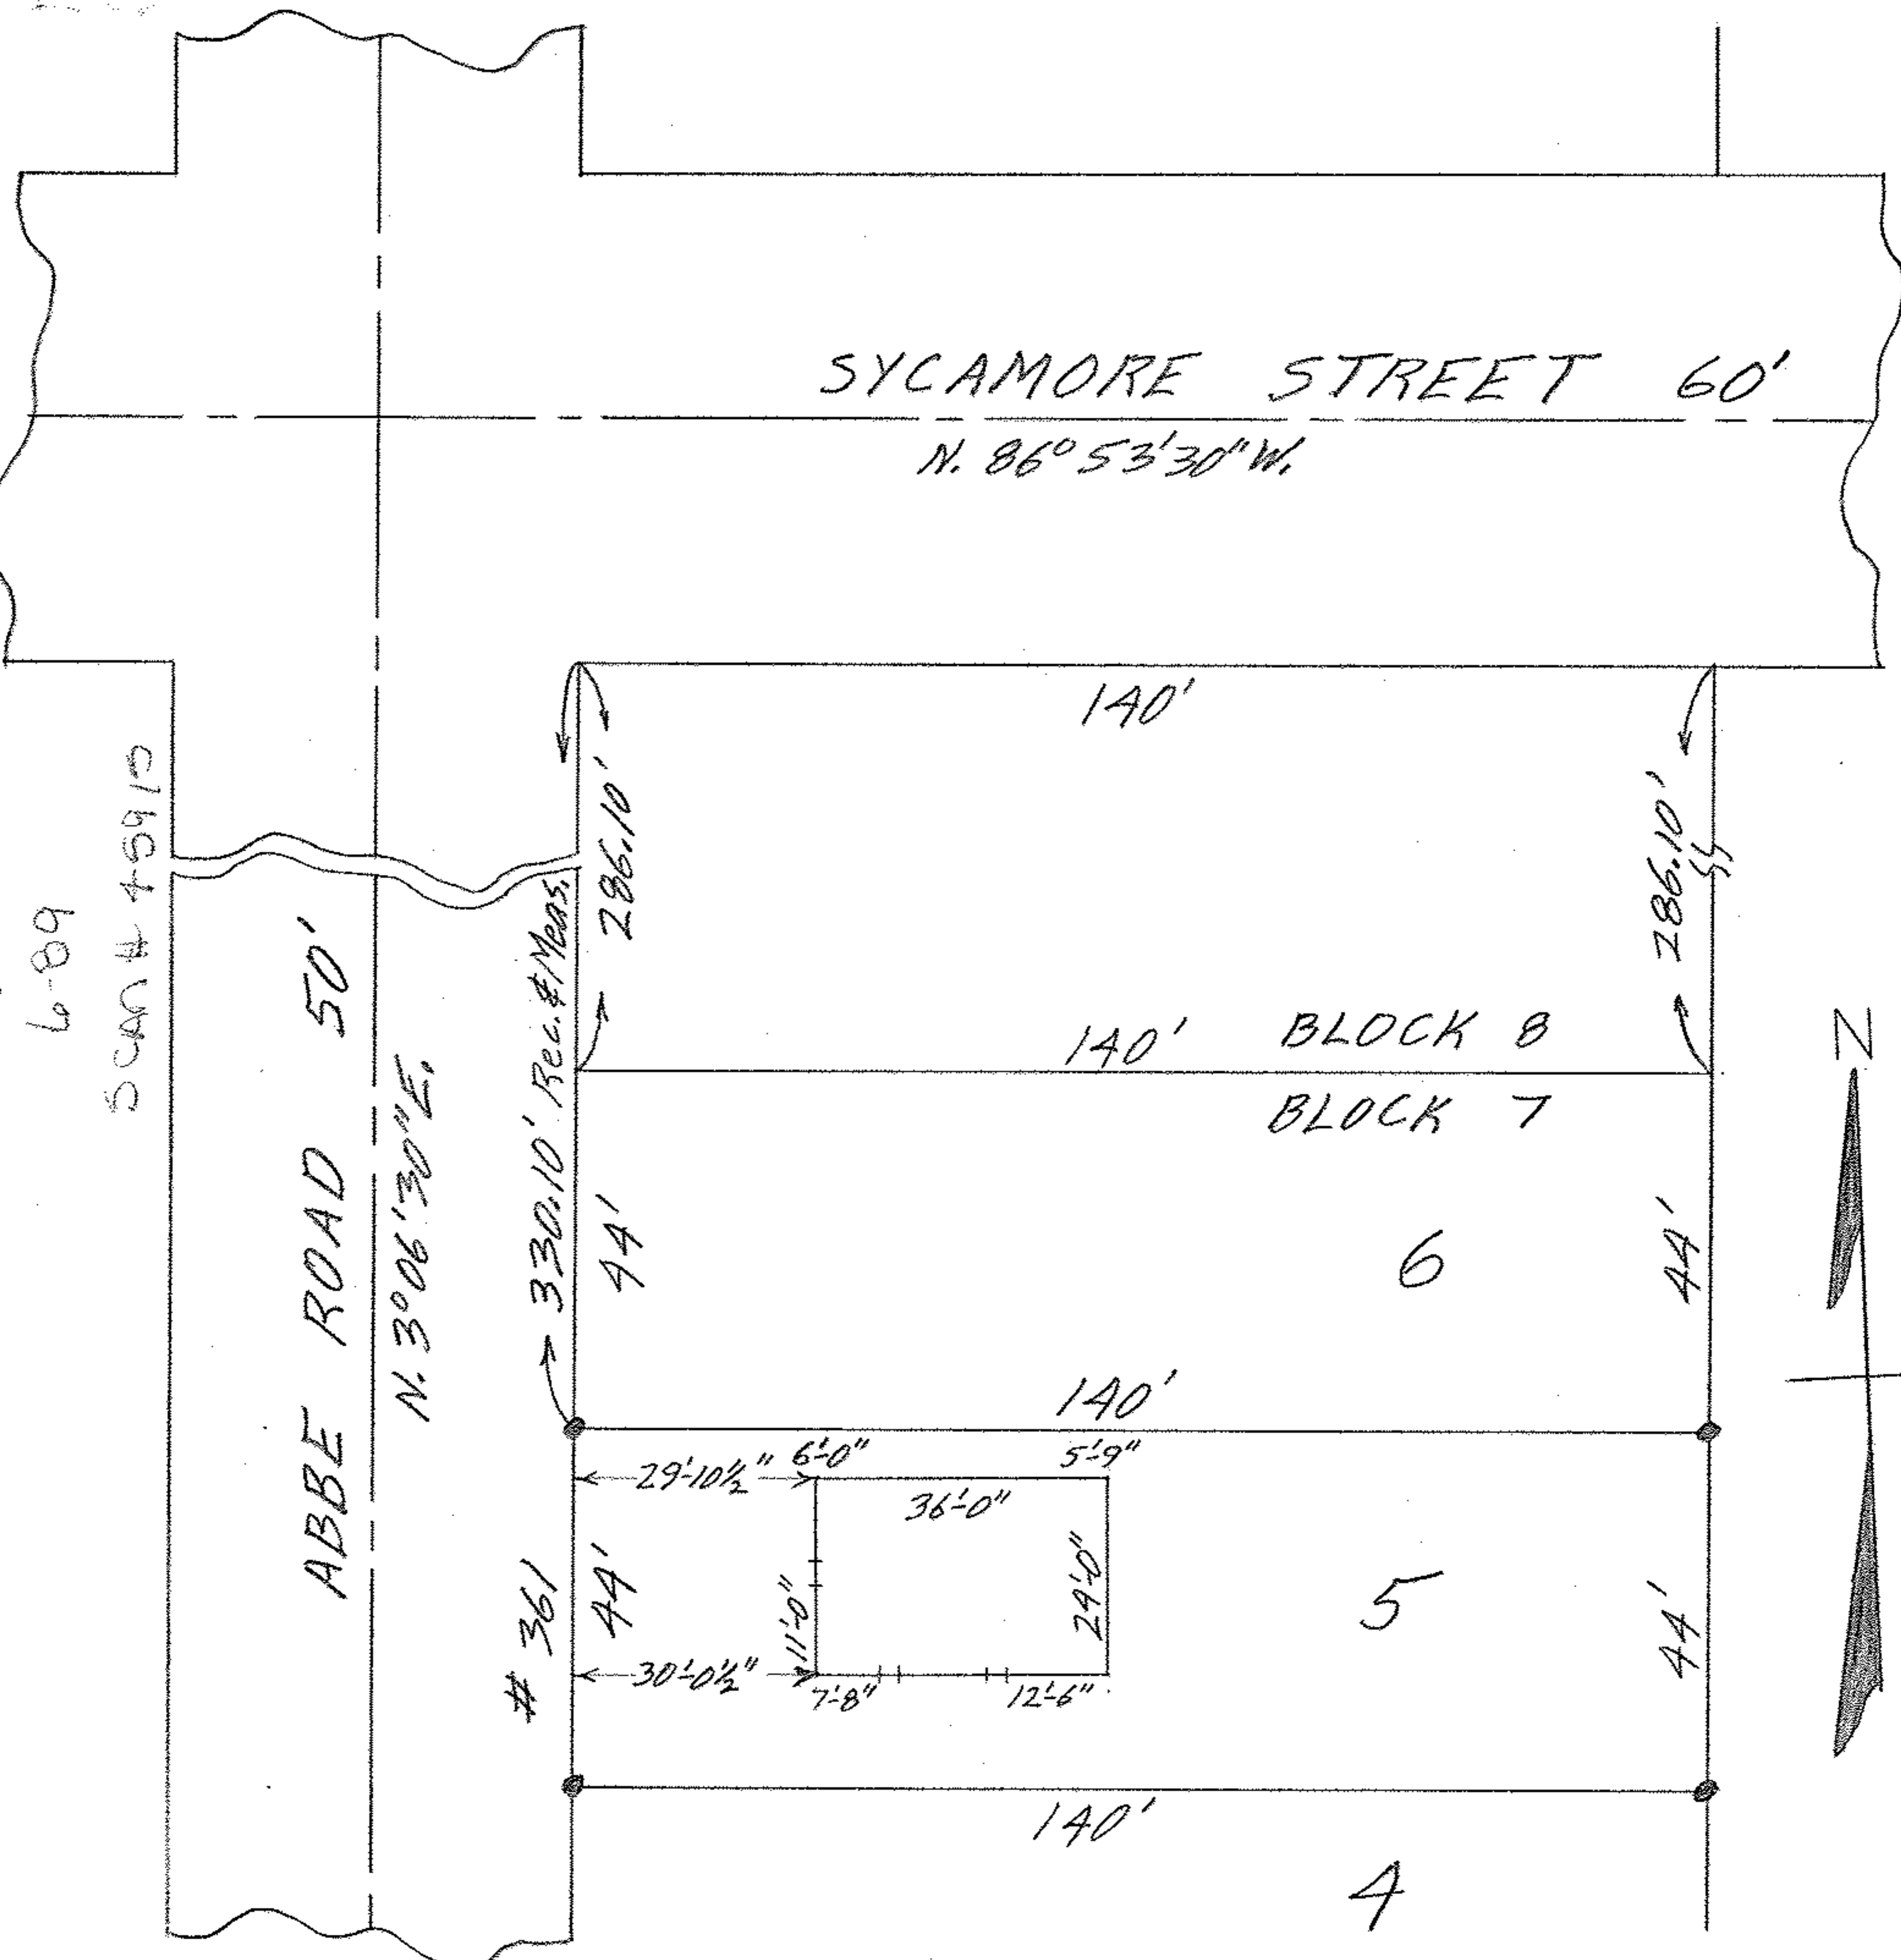

MAP OF SUB-LOT 5 BLOCK 7
 CITY FARMS ALL'T. VOL. 9 PG. 3 PLATS
 ELYRIA TWP. ELYRIA CITY
 LORAIN COUNTY OHIO
 SCALE: 1" = 30' AUG. 15-1962 3:30 P.M.
 Gary E. Penfound REG. SURVEYOR
 Douglas W. & Virginia Baldt