


06-25-022-105-044

N

6-89

Scan # 45917

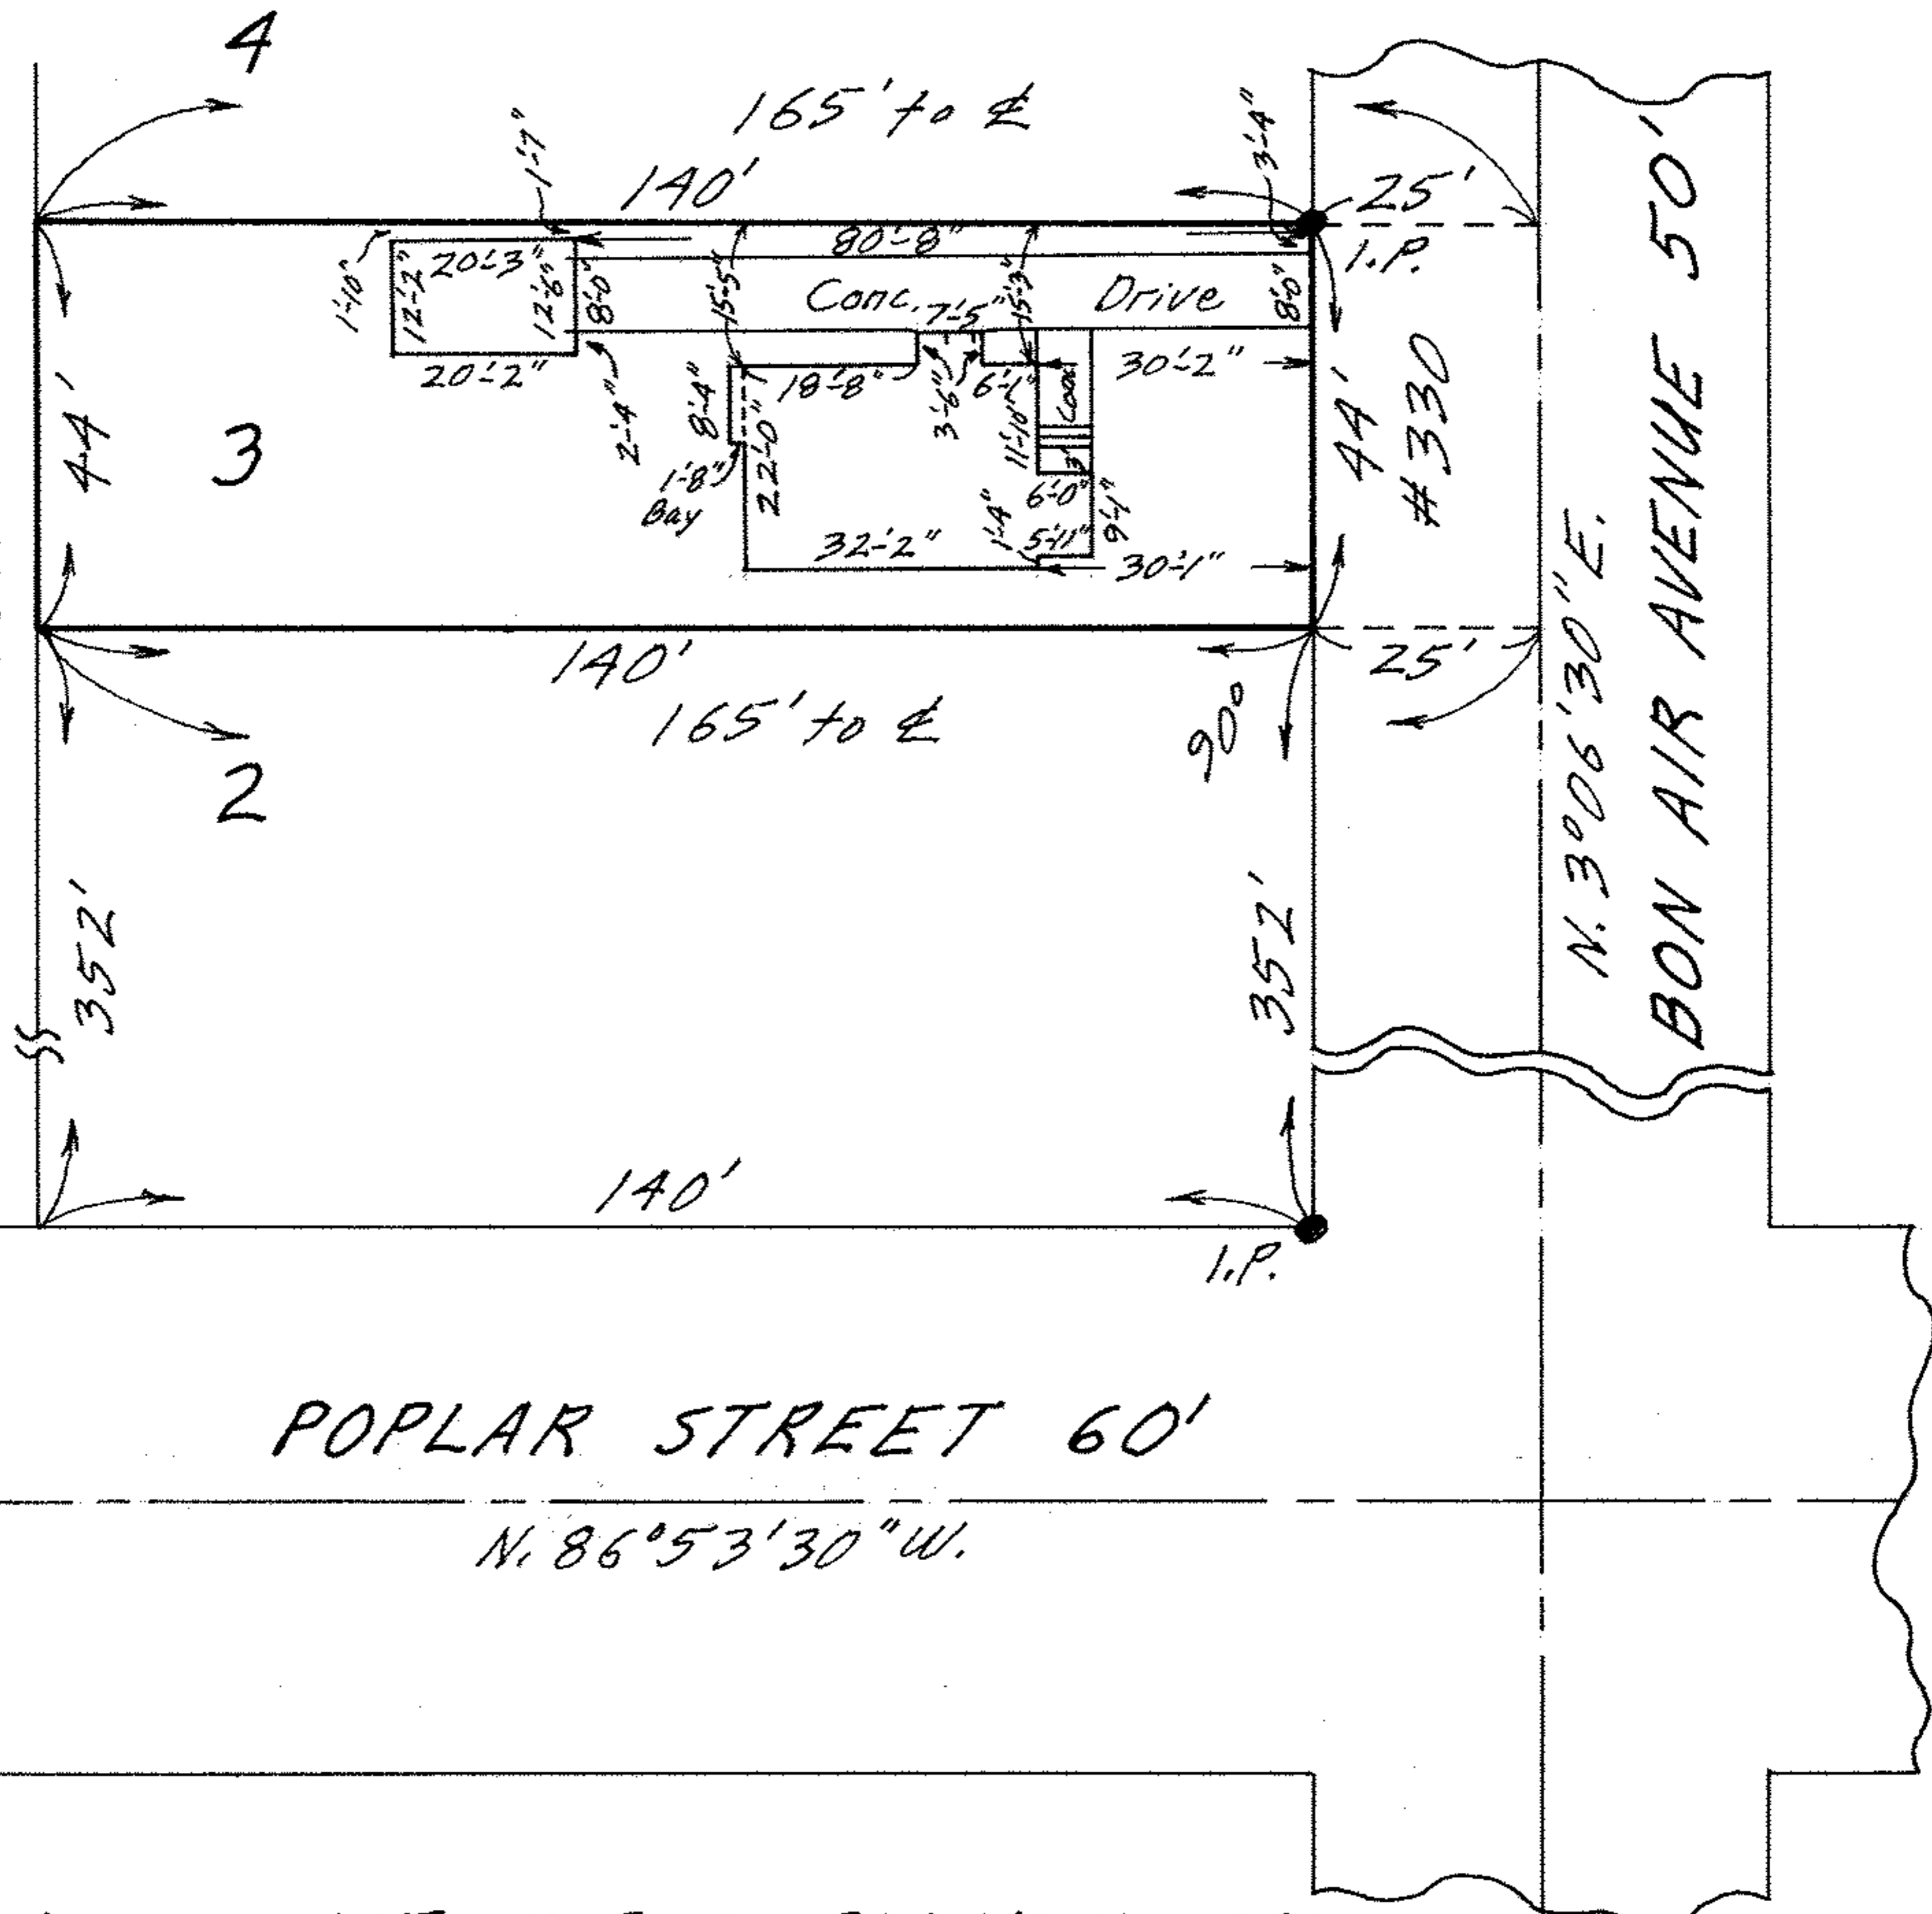

MAP OF SUB-LOT NO. 3 OF BLOCK NO. 27
 CITY FARMS ALL'T. VOL. 9 PG. 3 PLATS
 ORIG. LOT 22-EAST OF BLACK RIVER - ELYRIA TWP.
 ELYRIA CITY LORAIN COUNTY OHIO
 SCALE: 1"=30' NOV. 18-1970 12:30 P.M.

NOTE: There are no encroachments on this property.
 Gary E. Penfound REG. SURVEYOR NO. 4457

CITY TITLE Co. Order No. E-1356-7
 Murial to Watson