


06-25-022-107-029-2031

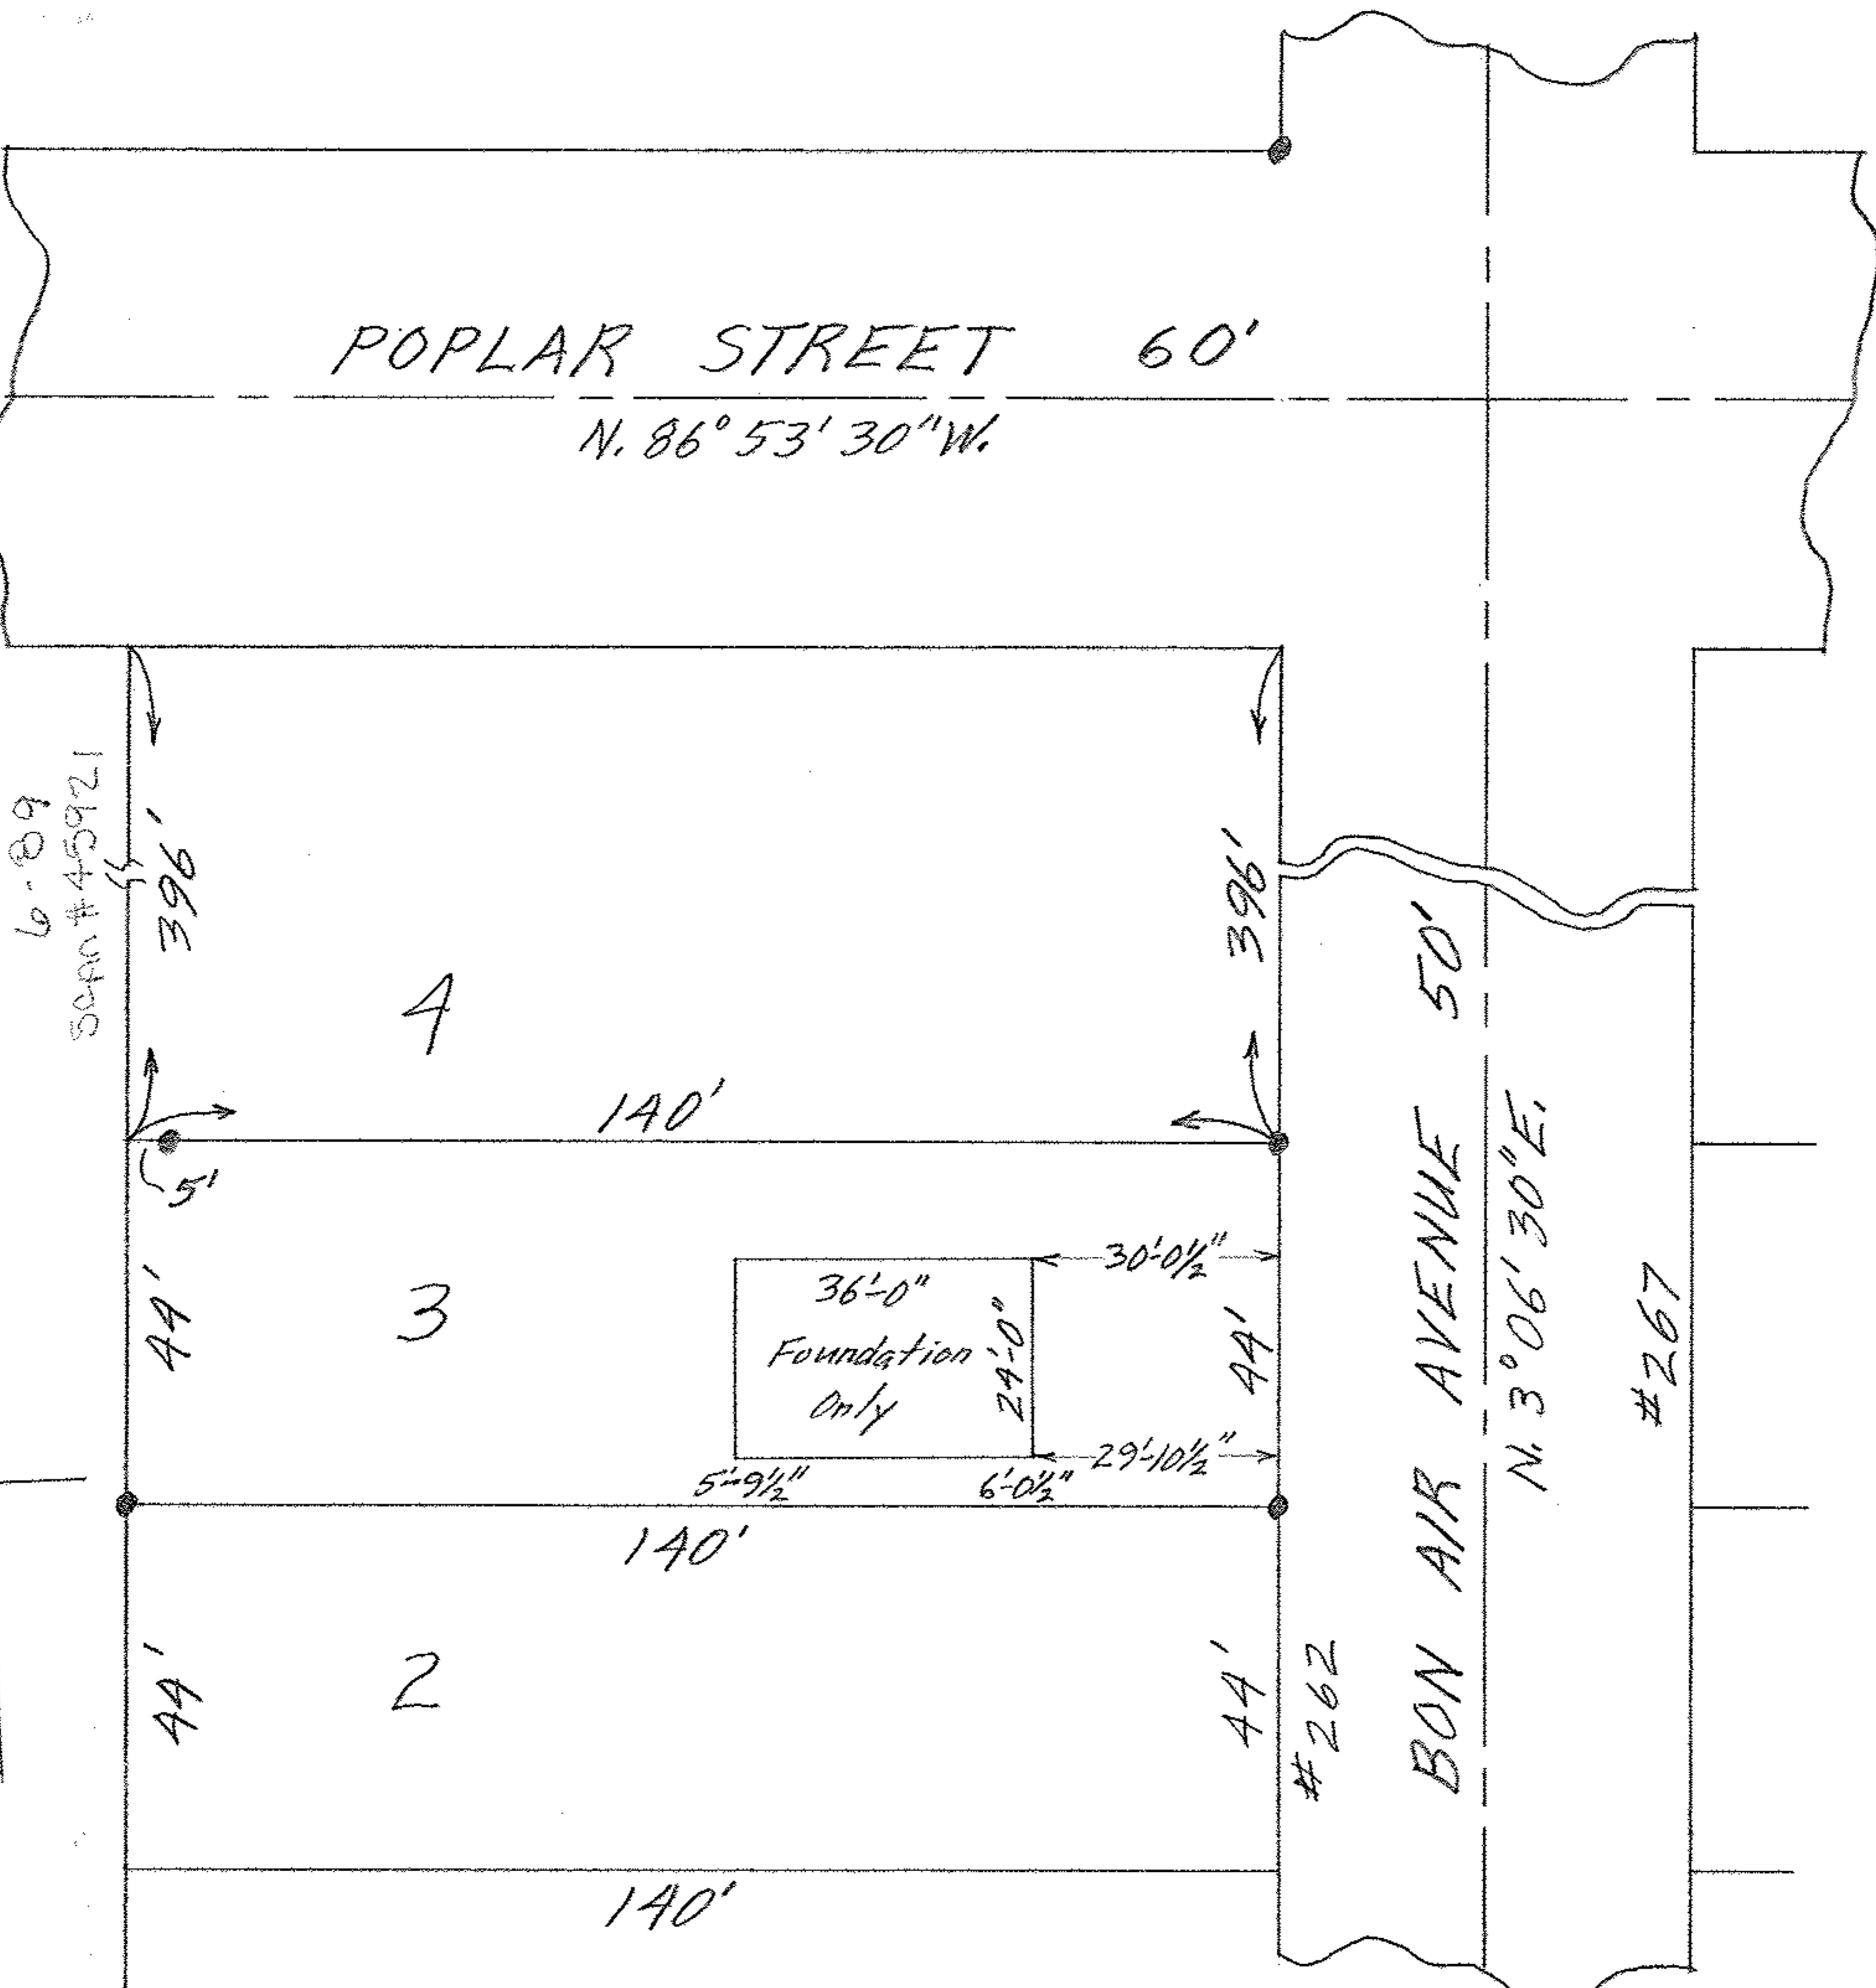

6-89  
SEPT #45921

MAP OF SUB-LOT 3 BLOCK 30  
 CITY FARMS ALL'T. VOL. 9 PG. 3 PLATS  
 ELYRIA TWP. ELYRIA CITY  
 LORAIN COUNTY OHIO  
 SCALE: 1" = 30' JUNE 20-1962 2:30 P.M.  
 Gary E. Penfound REG. SURVEYOR  
 Ronald D. Burdette