


06-25-022-108-003

6-89  
Scant. 45928

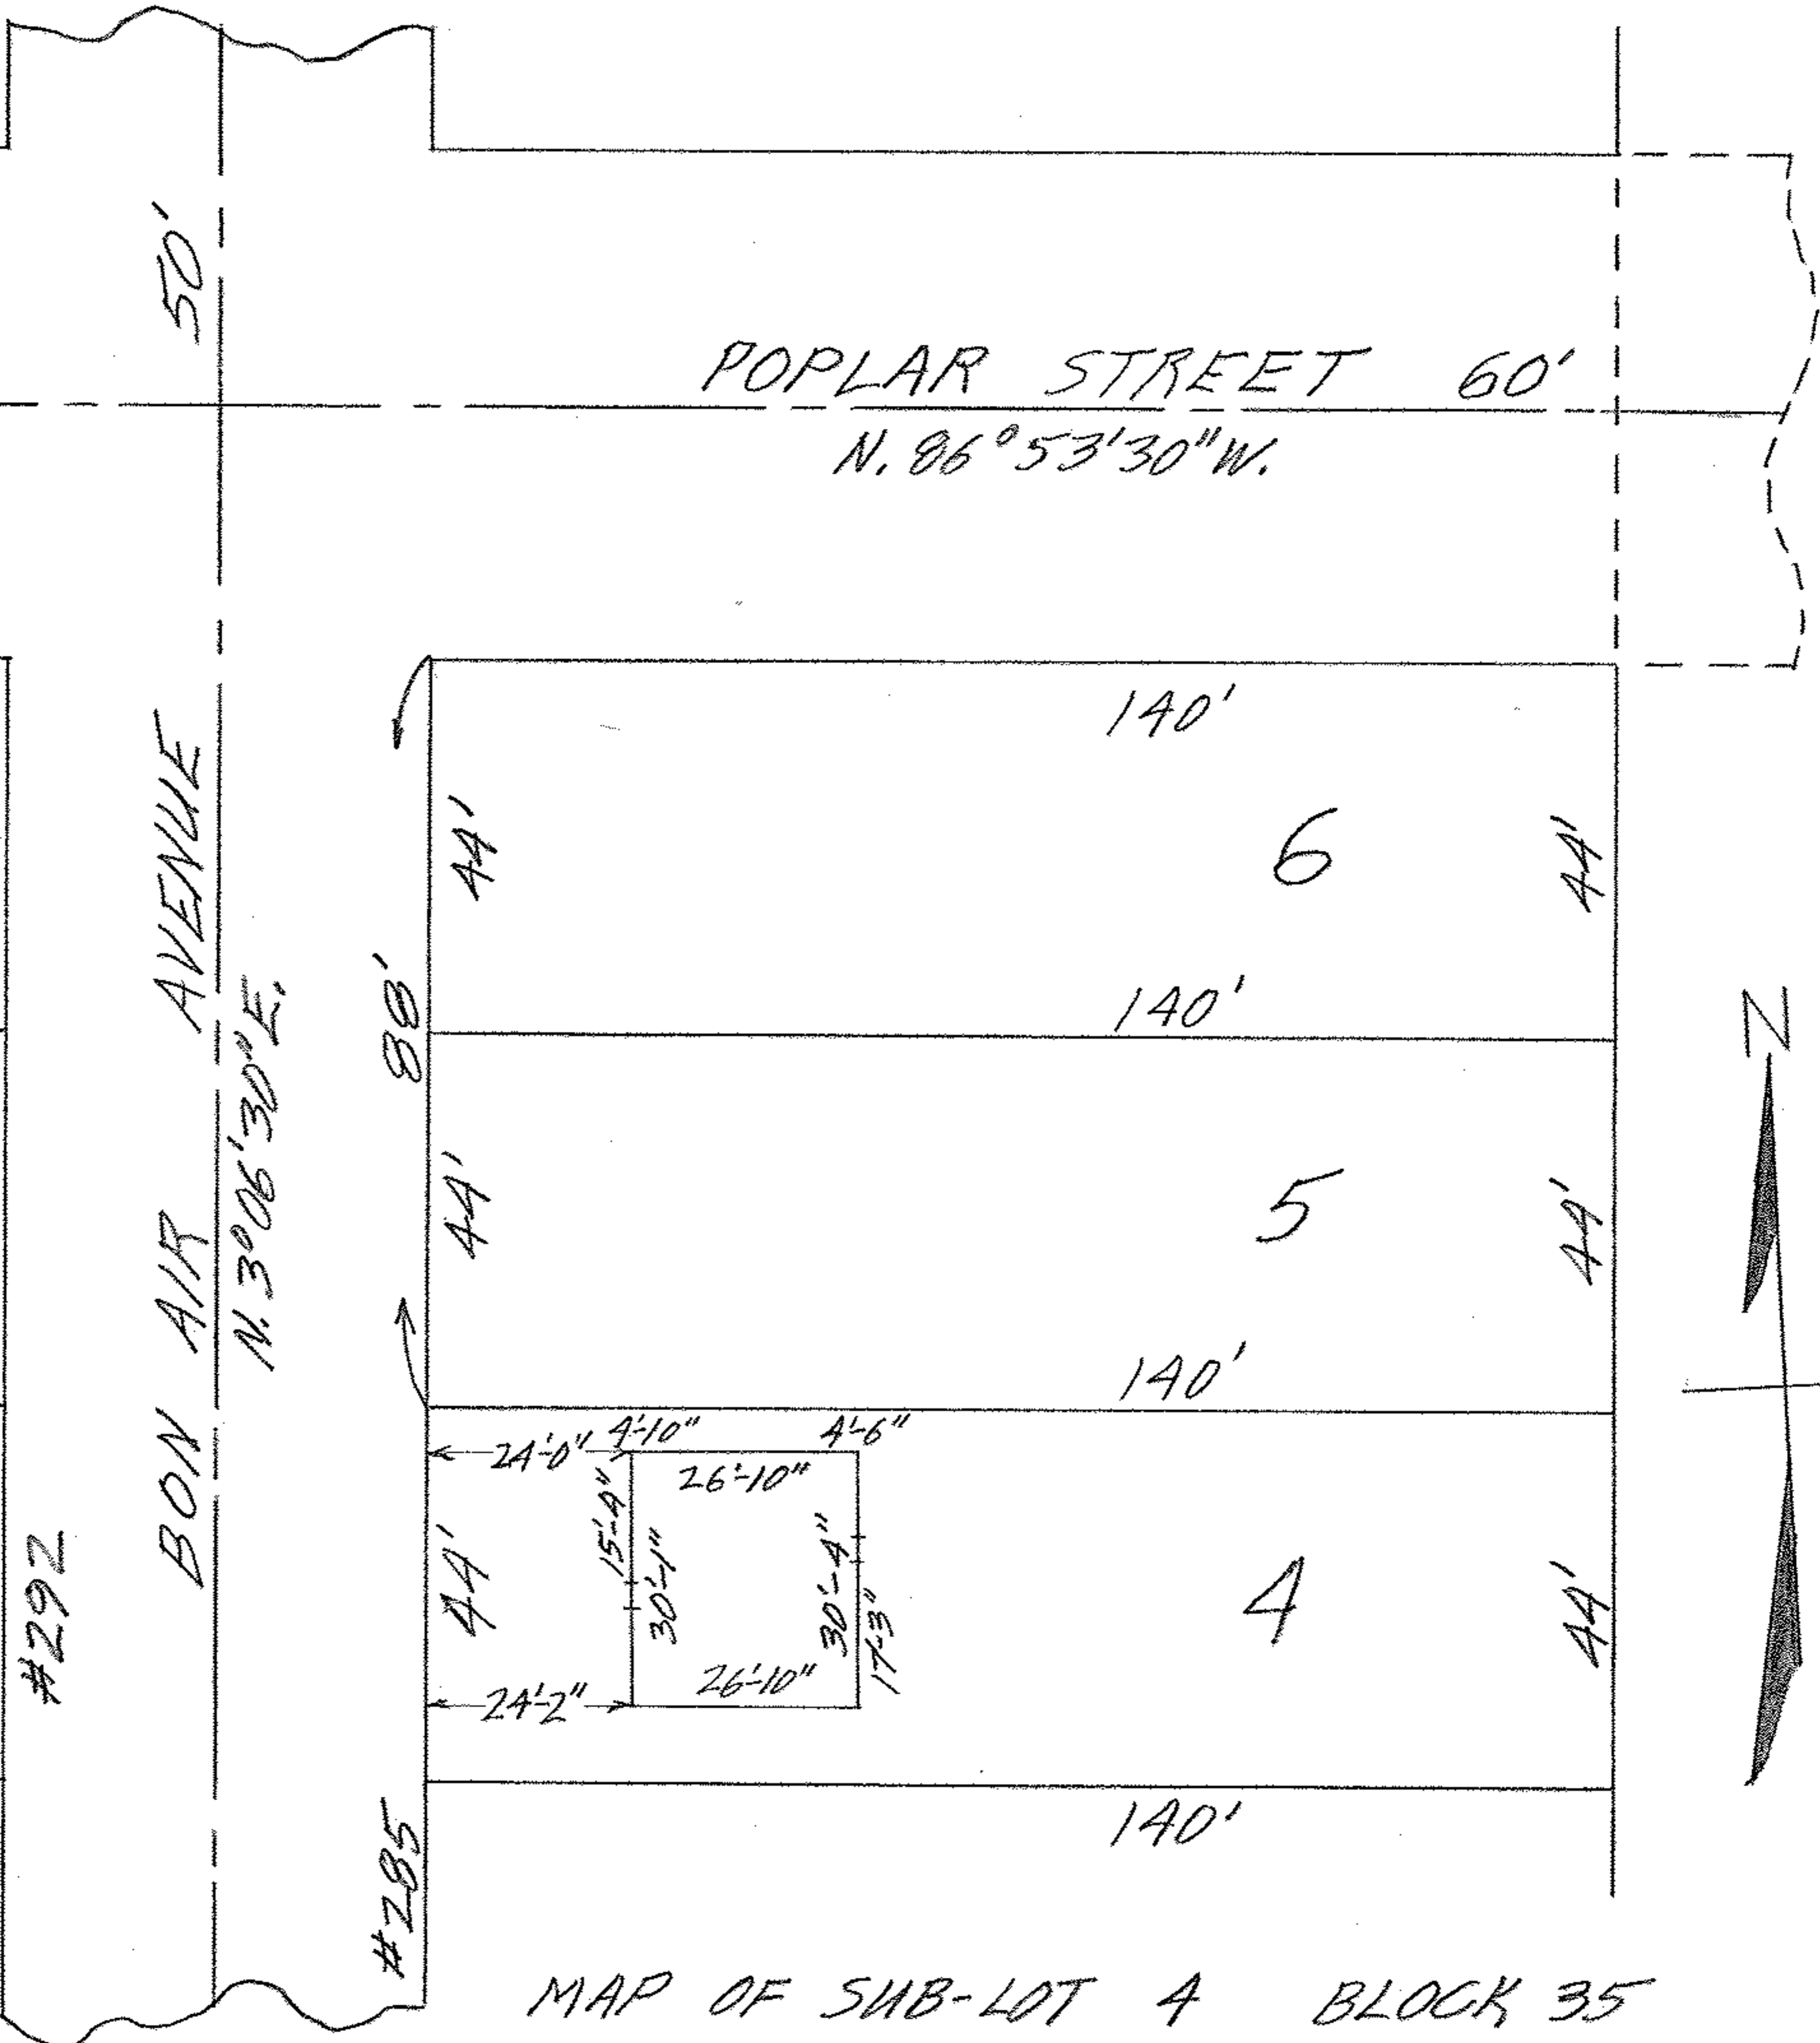

MAP OF SUB-LOT 4 BLOCK 35  
 CITY FARMS ALL'T. VOL. 9 PG. 3 PLATS  
 ELYRIA TWP. ELYRIA CITY  
 LORAIN COUNTY - OHIO  
 SCALE: 1" = 30' JULY 9-1962 3:00 P.M.  
 Gary E. Penfound REG. SURVEYOR.

Eloy S. & Thelma G. Fulmer