


06-25-023-101-015  
6-71  
Scan # 459264

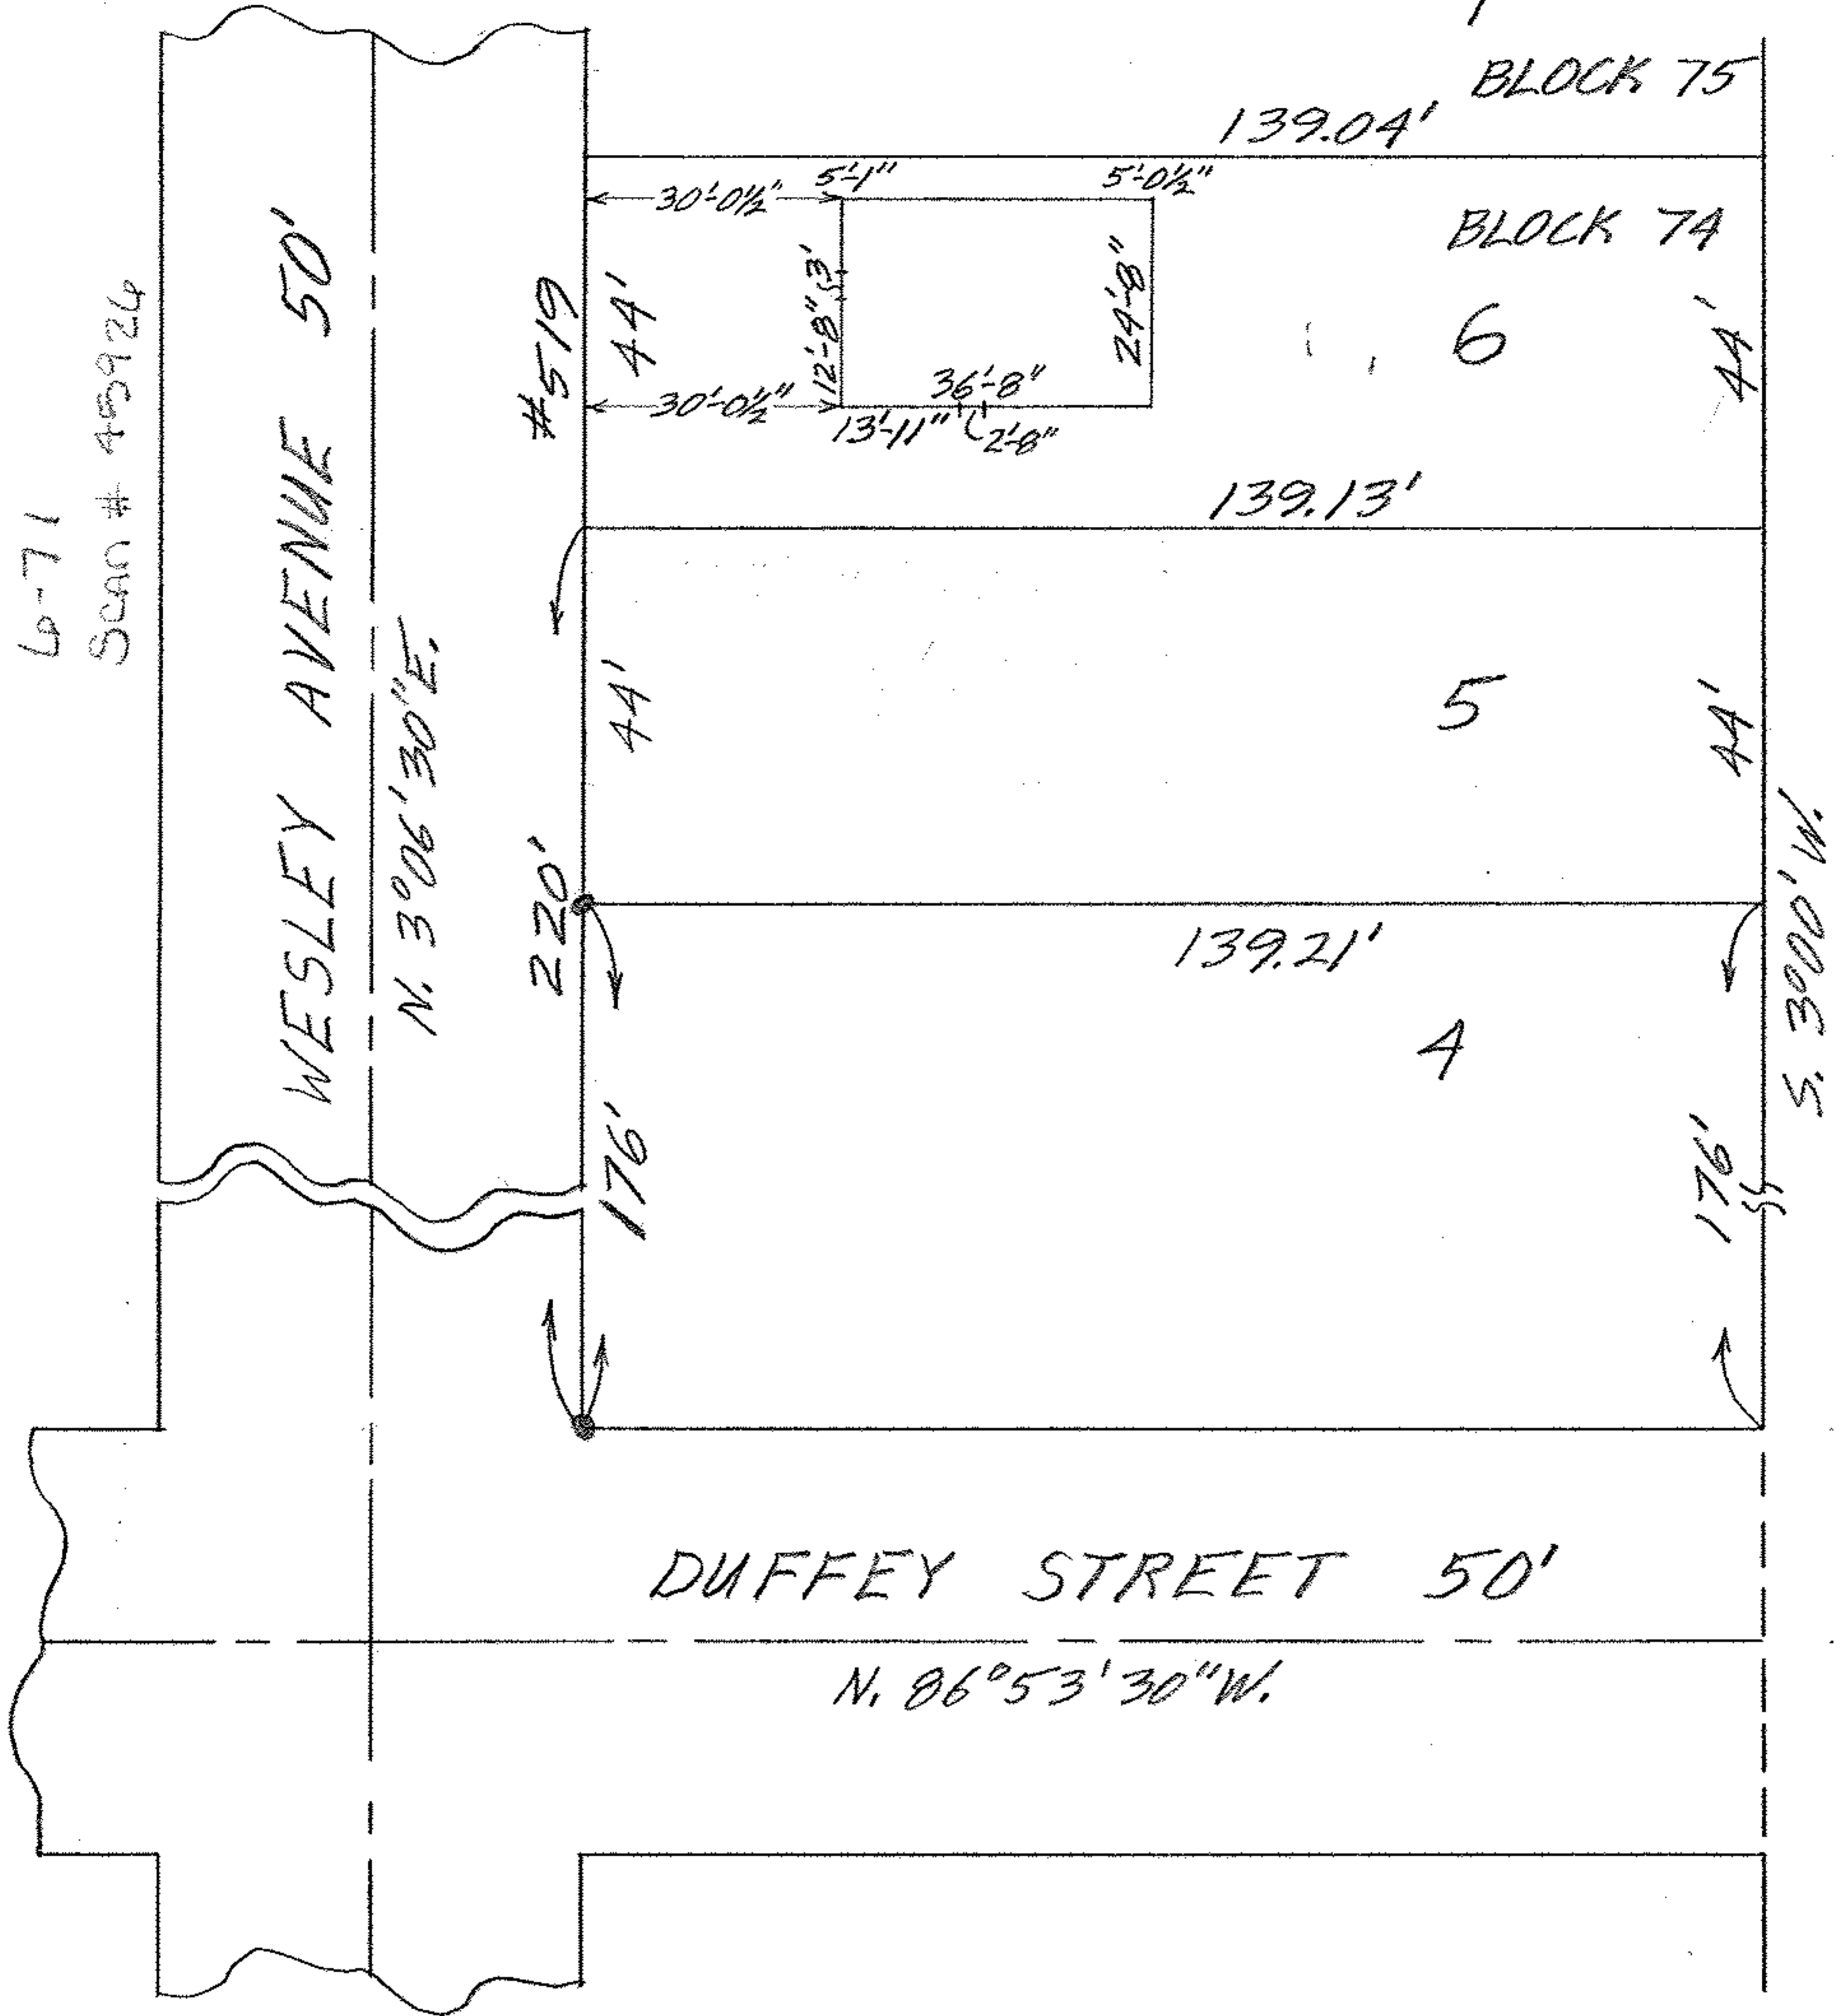

MAP OF SUB-LOT 6 - BLOCK 74  
CITY FARMS ALL'T. VOL. 9 Pg. 3 PLATS  
ELYRIA TWP. ELYRIA CITY  
LORAIN COUNTY OHIO  
SCALE: 1"=30' FEB. 15 - 1963 9:15 A.M.  
Gary E. Penfound REG. SURVEYOR  
Daniel B. & Francis M. Roberts