


06-25-023-101-015  
 6-71  
 SCAN # 45927

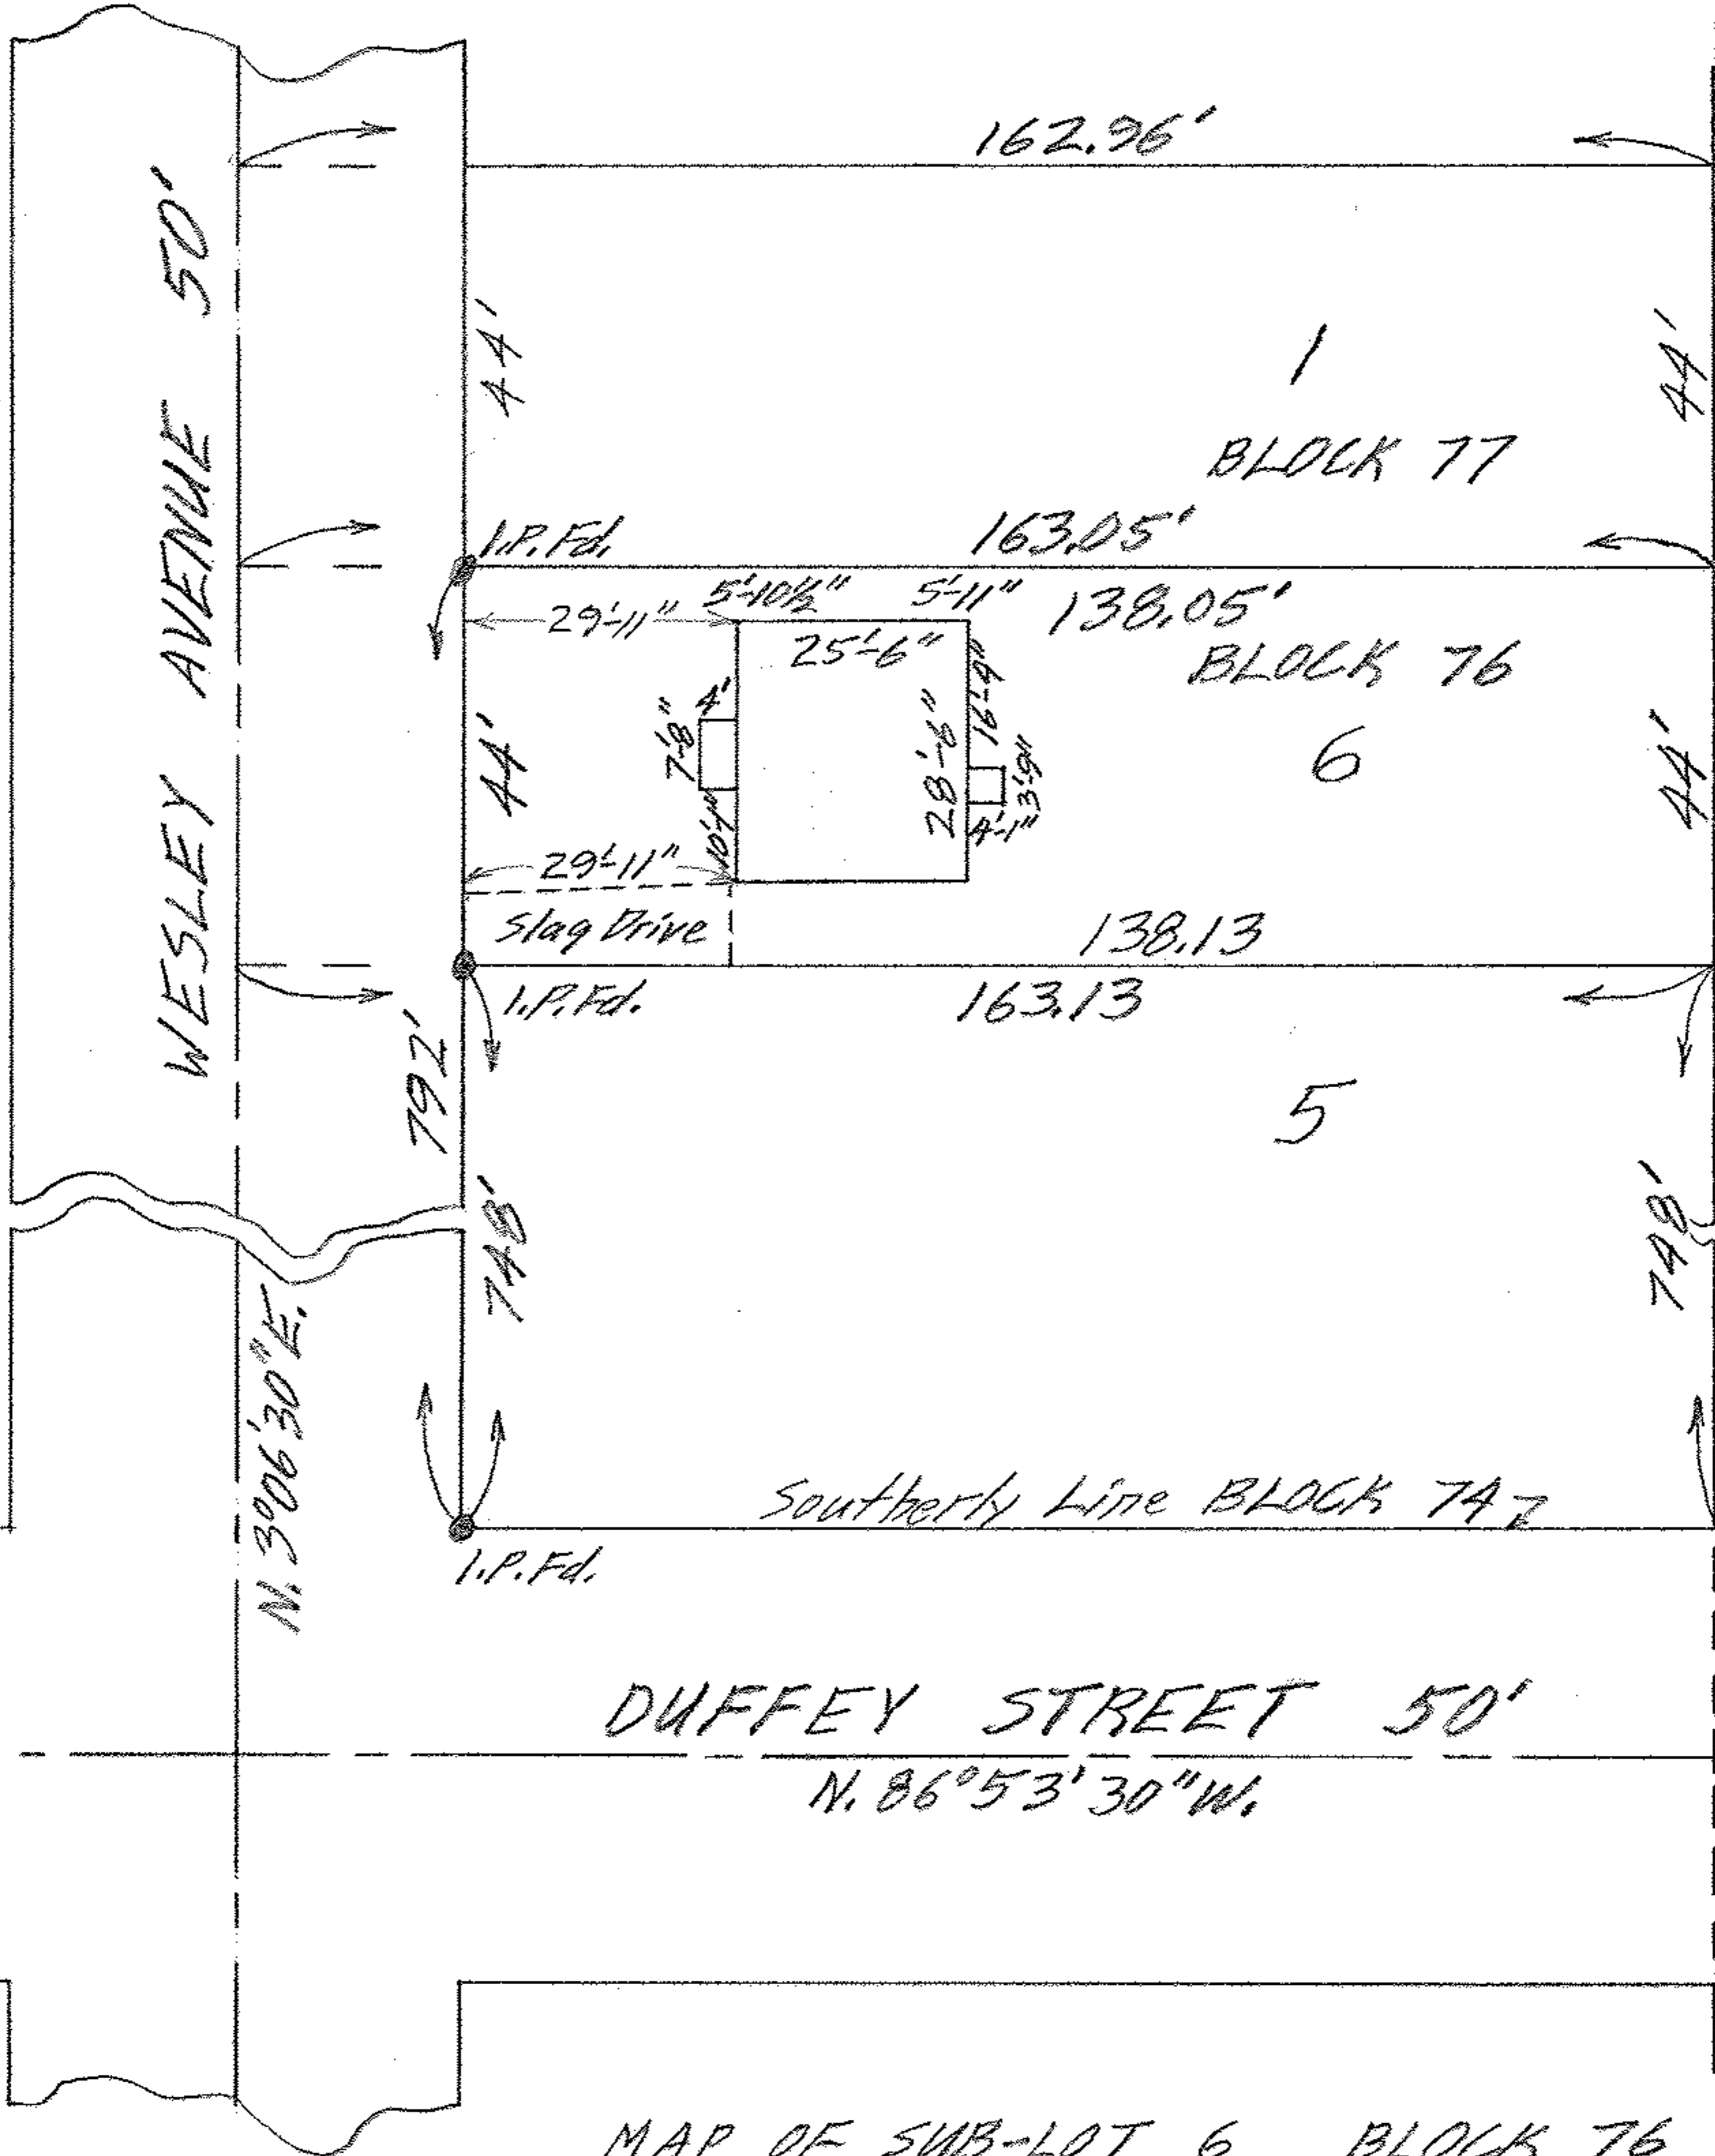

MAP OF SUB-LOT 6 BLOCK 76  
 CITY FARMS ALL'T. VOL. 9 PG. 3 PLATS  
 ELYRIA TWP. ELYRIA CITY  
 LORAIN COUNTY OHIO  
 SCALE: 1" = 30' DEC. 28 - 1961 12:15 P.M.  
 Gary E. Penfound REG. SURVEYOR

Francis W. Carder