


06-25-023-101-010

6-71
SCAN # 45928

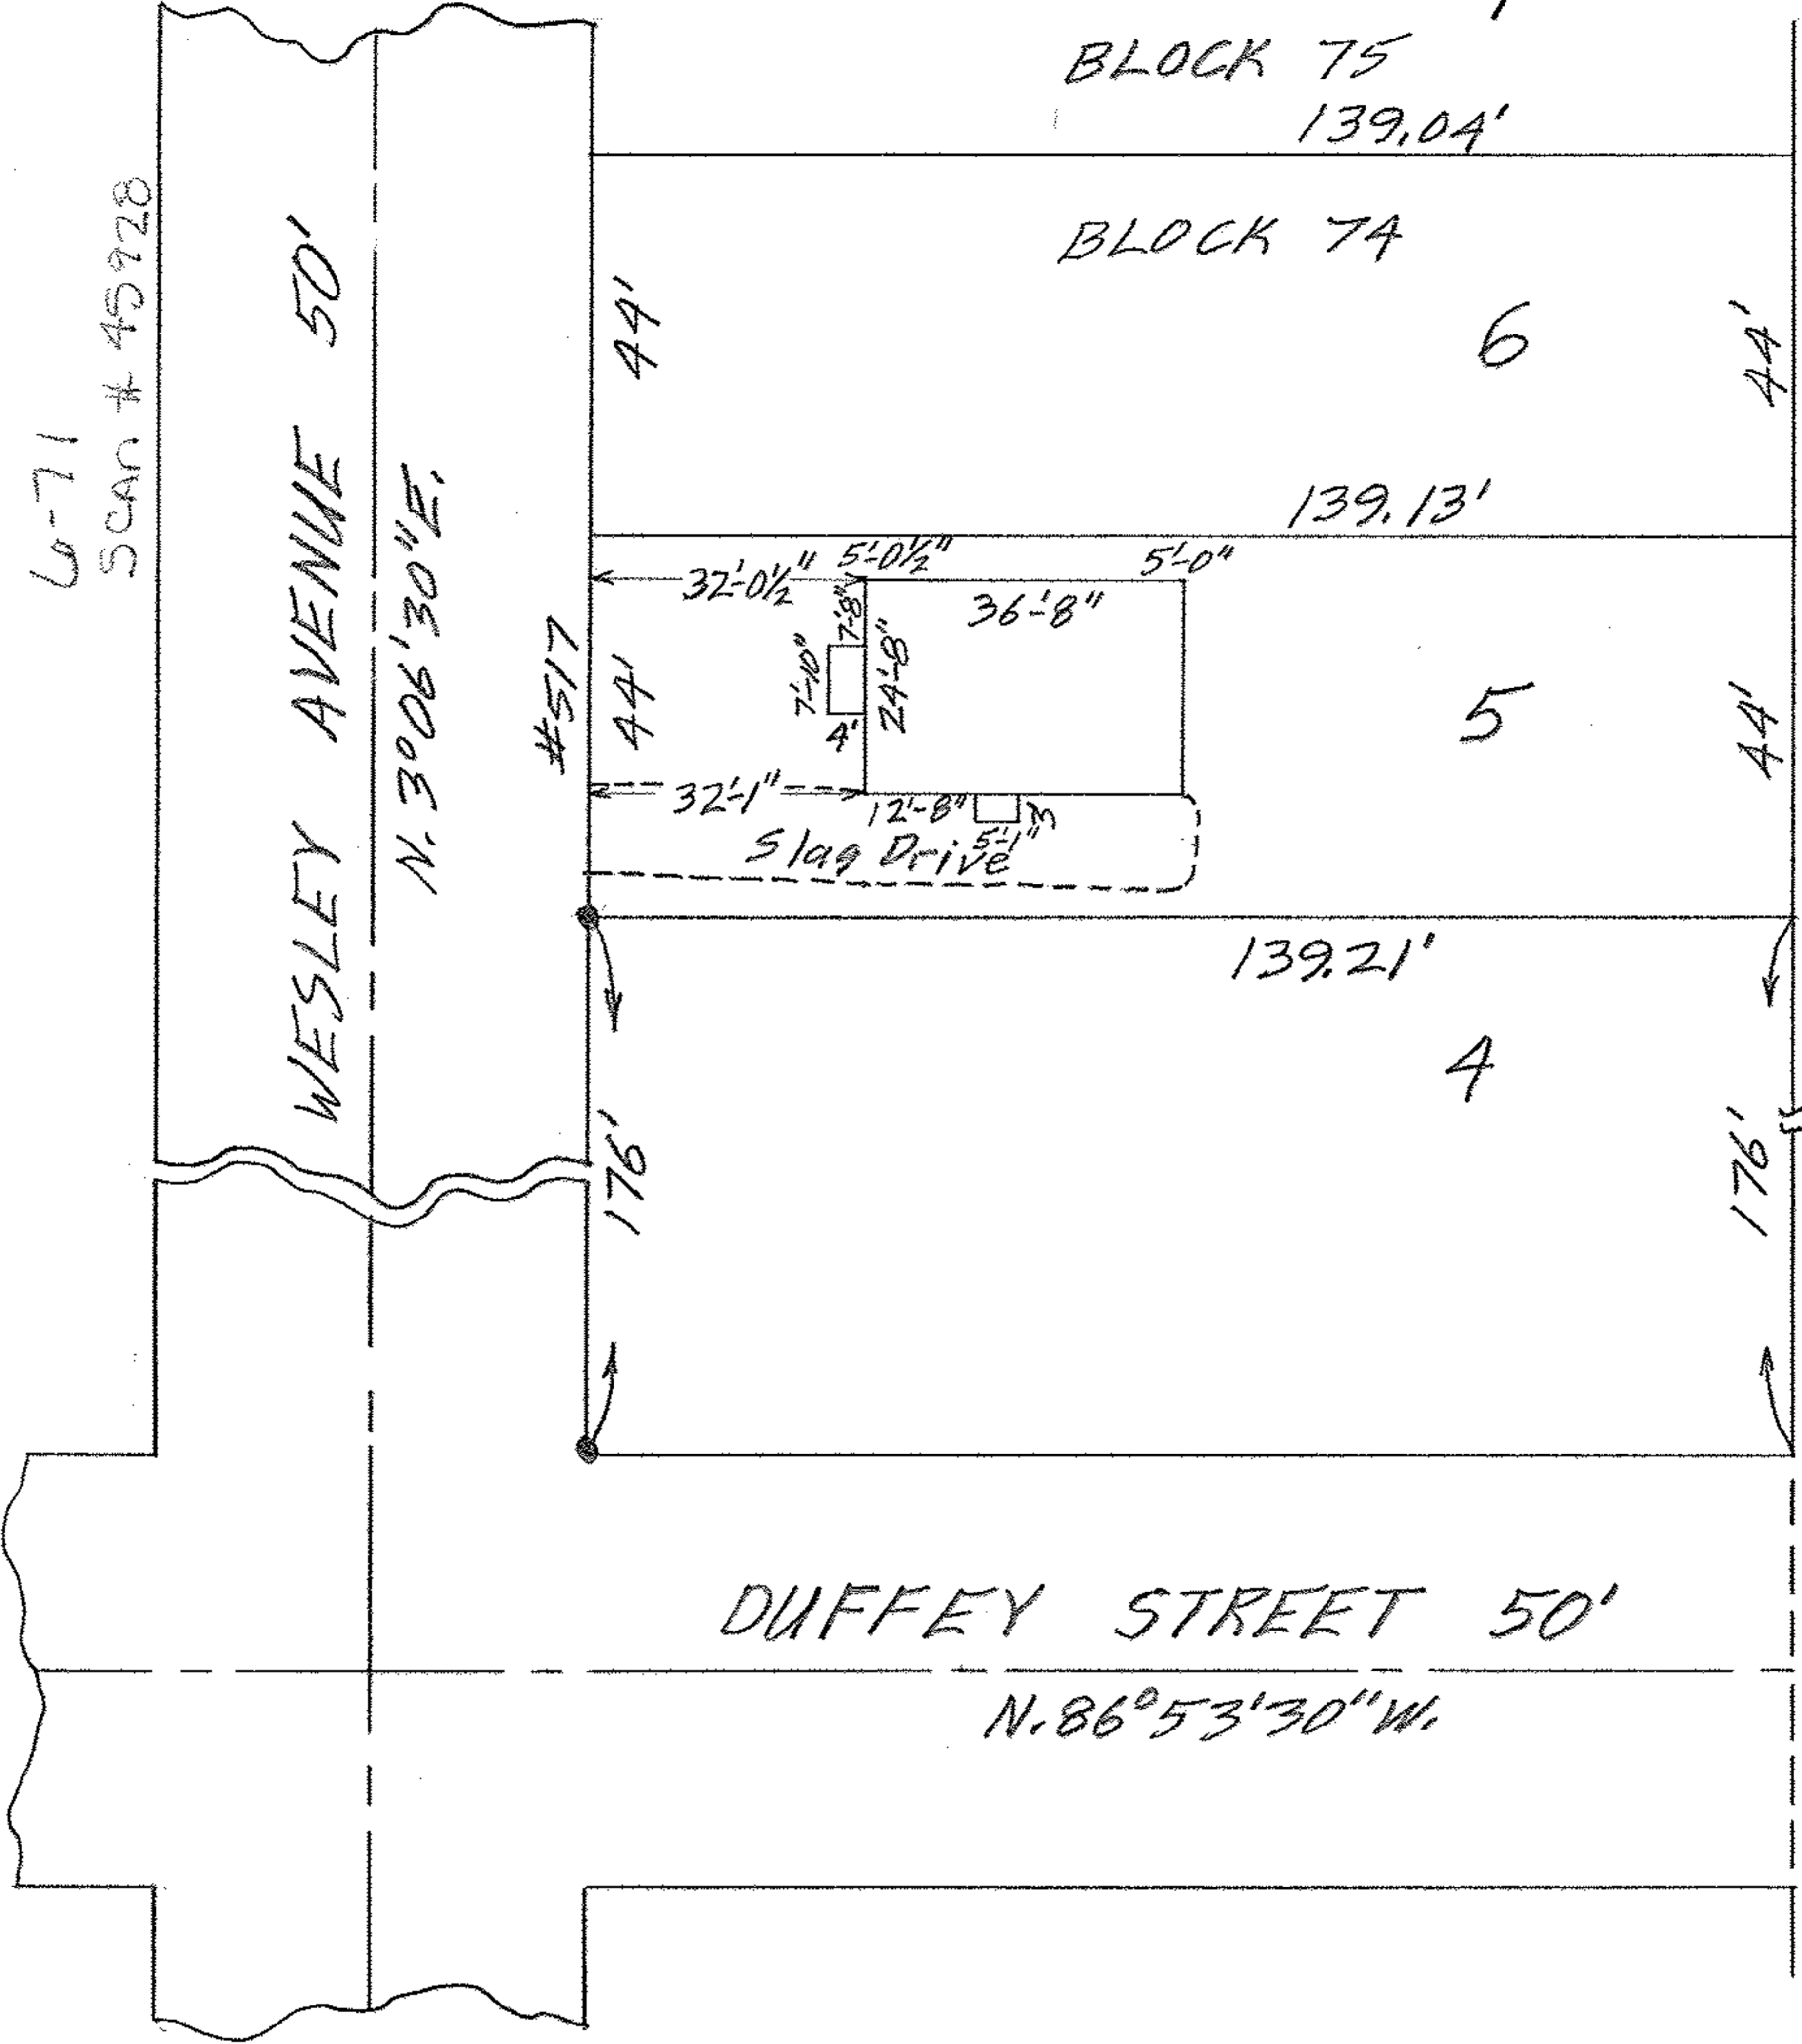

MAP OF SUB-LOT 5 BLOCK 74
 CITY FARMS ALL'T. VOL. 9 Pg. 3 PLATS
 ELYRIA TWP. ELYRIA CITY
 LORAIN COUNTY OHIO
 SCALE: 1"=30' JUNE 3-1963 4:30 P.M.
 Gary E. Perfound REG. SURVEYOR

James W. & Irene M. Thomas