


06-29-623-101-017  
6-71  
SCAN # 45929

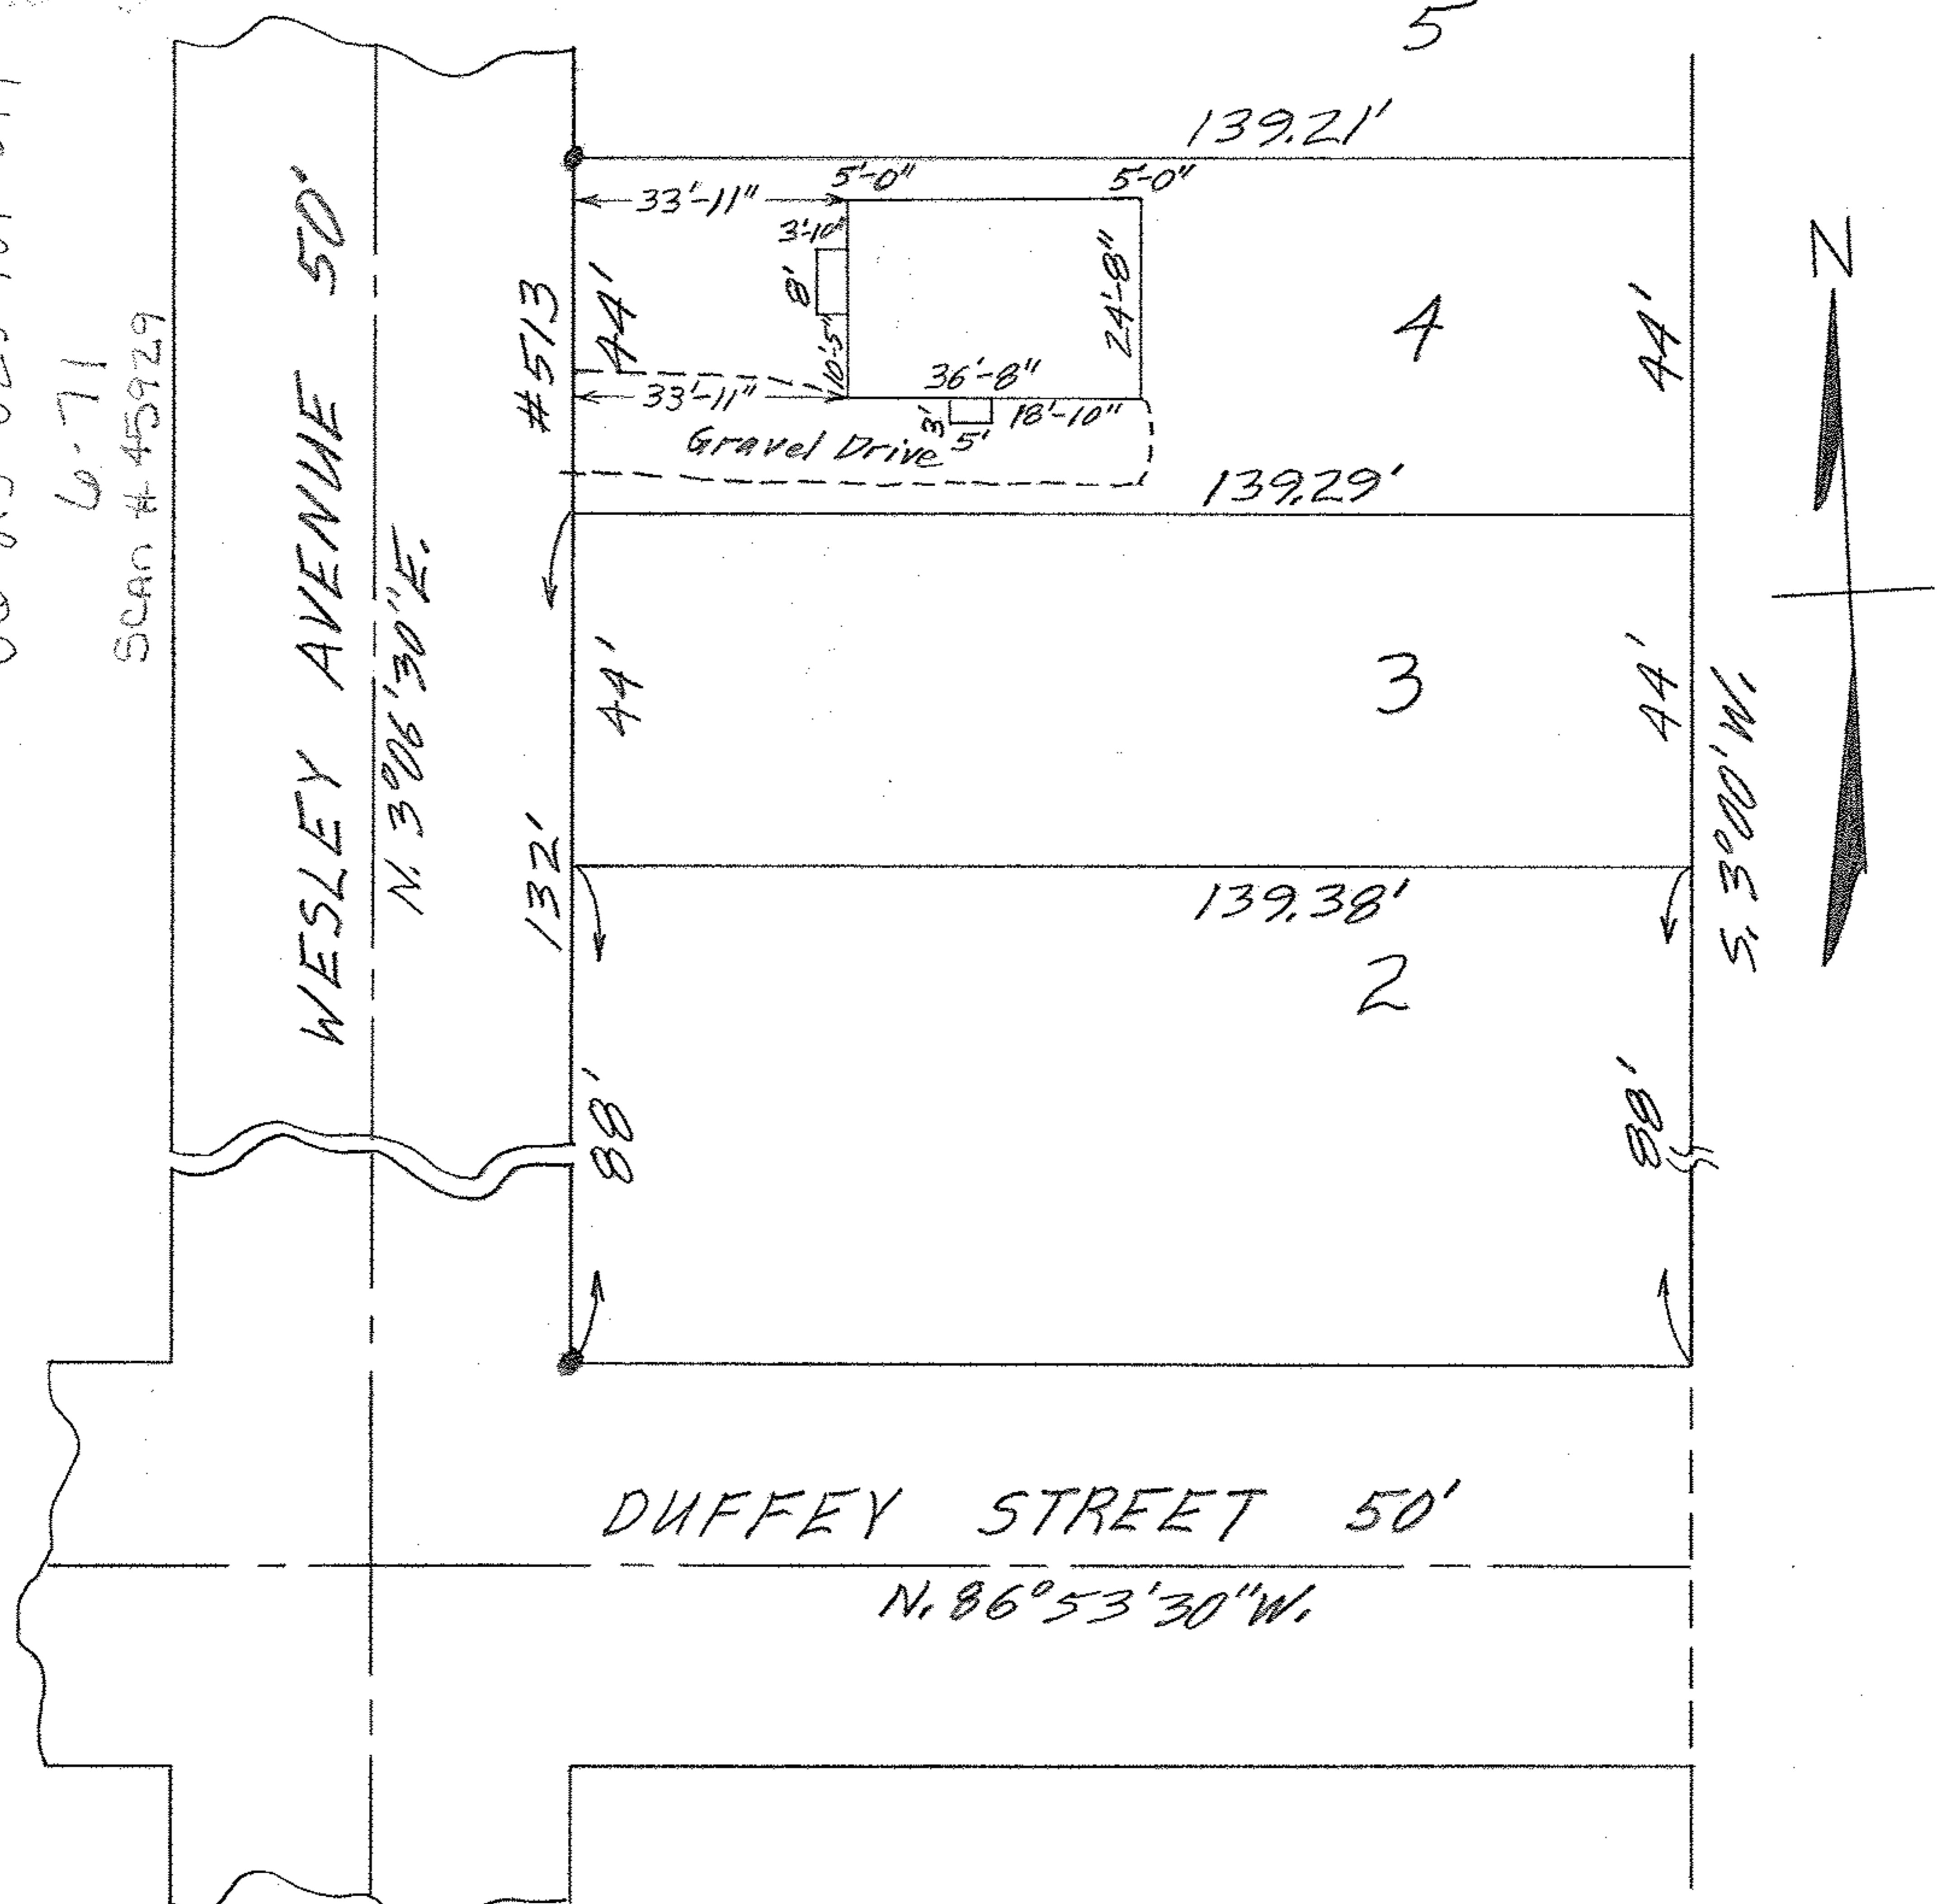

MAP OF SUB-LOT 4 BLOCK 74  
CITY FARMS ALL'T. Vol. 9 Pg. 3 PLATS  
ELYRIA TWP. ELYRIA CITY  
LORAIN COUNTY OHIO  
SCALE: 1"=30' APR. 23 - 1963 4:20 P.M.  
Mary E. Penfound REG. SURVEYOR

Orville L. & Eva C. Hall