
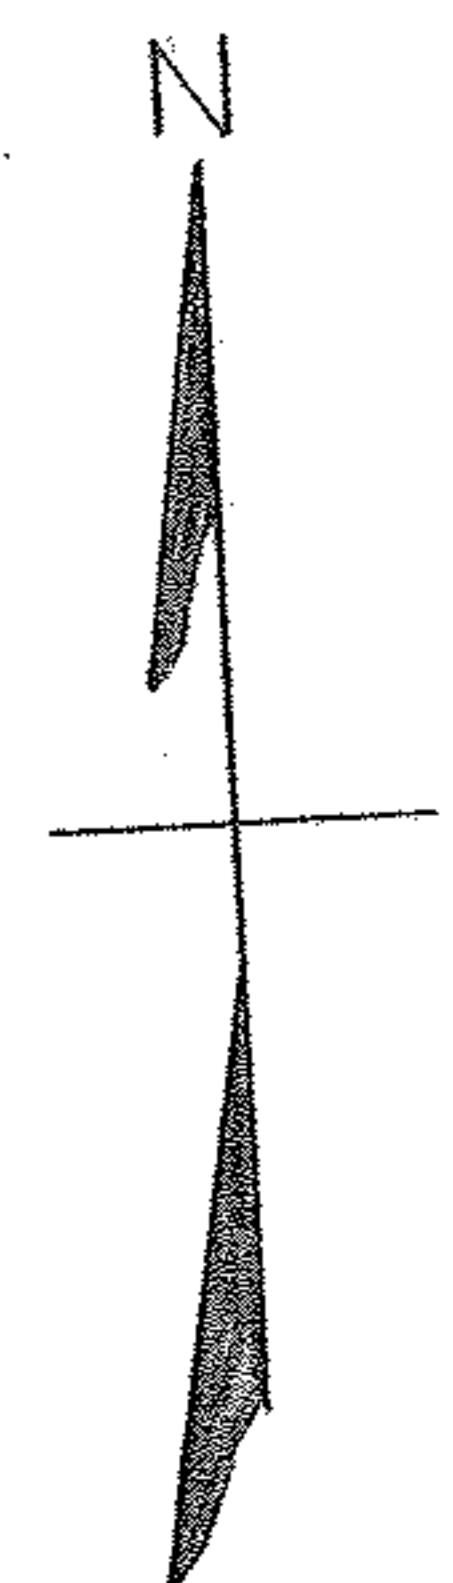


06-25-023-102-003
6-71
SCAN# 45934

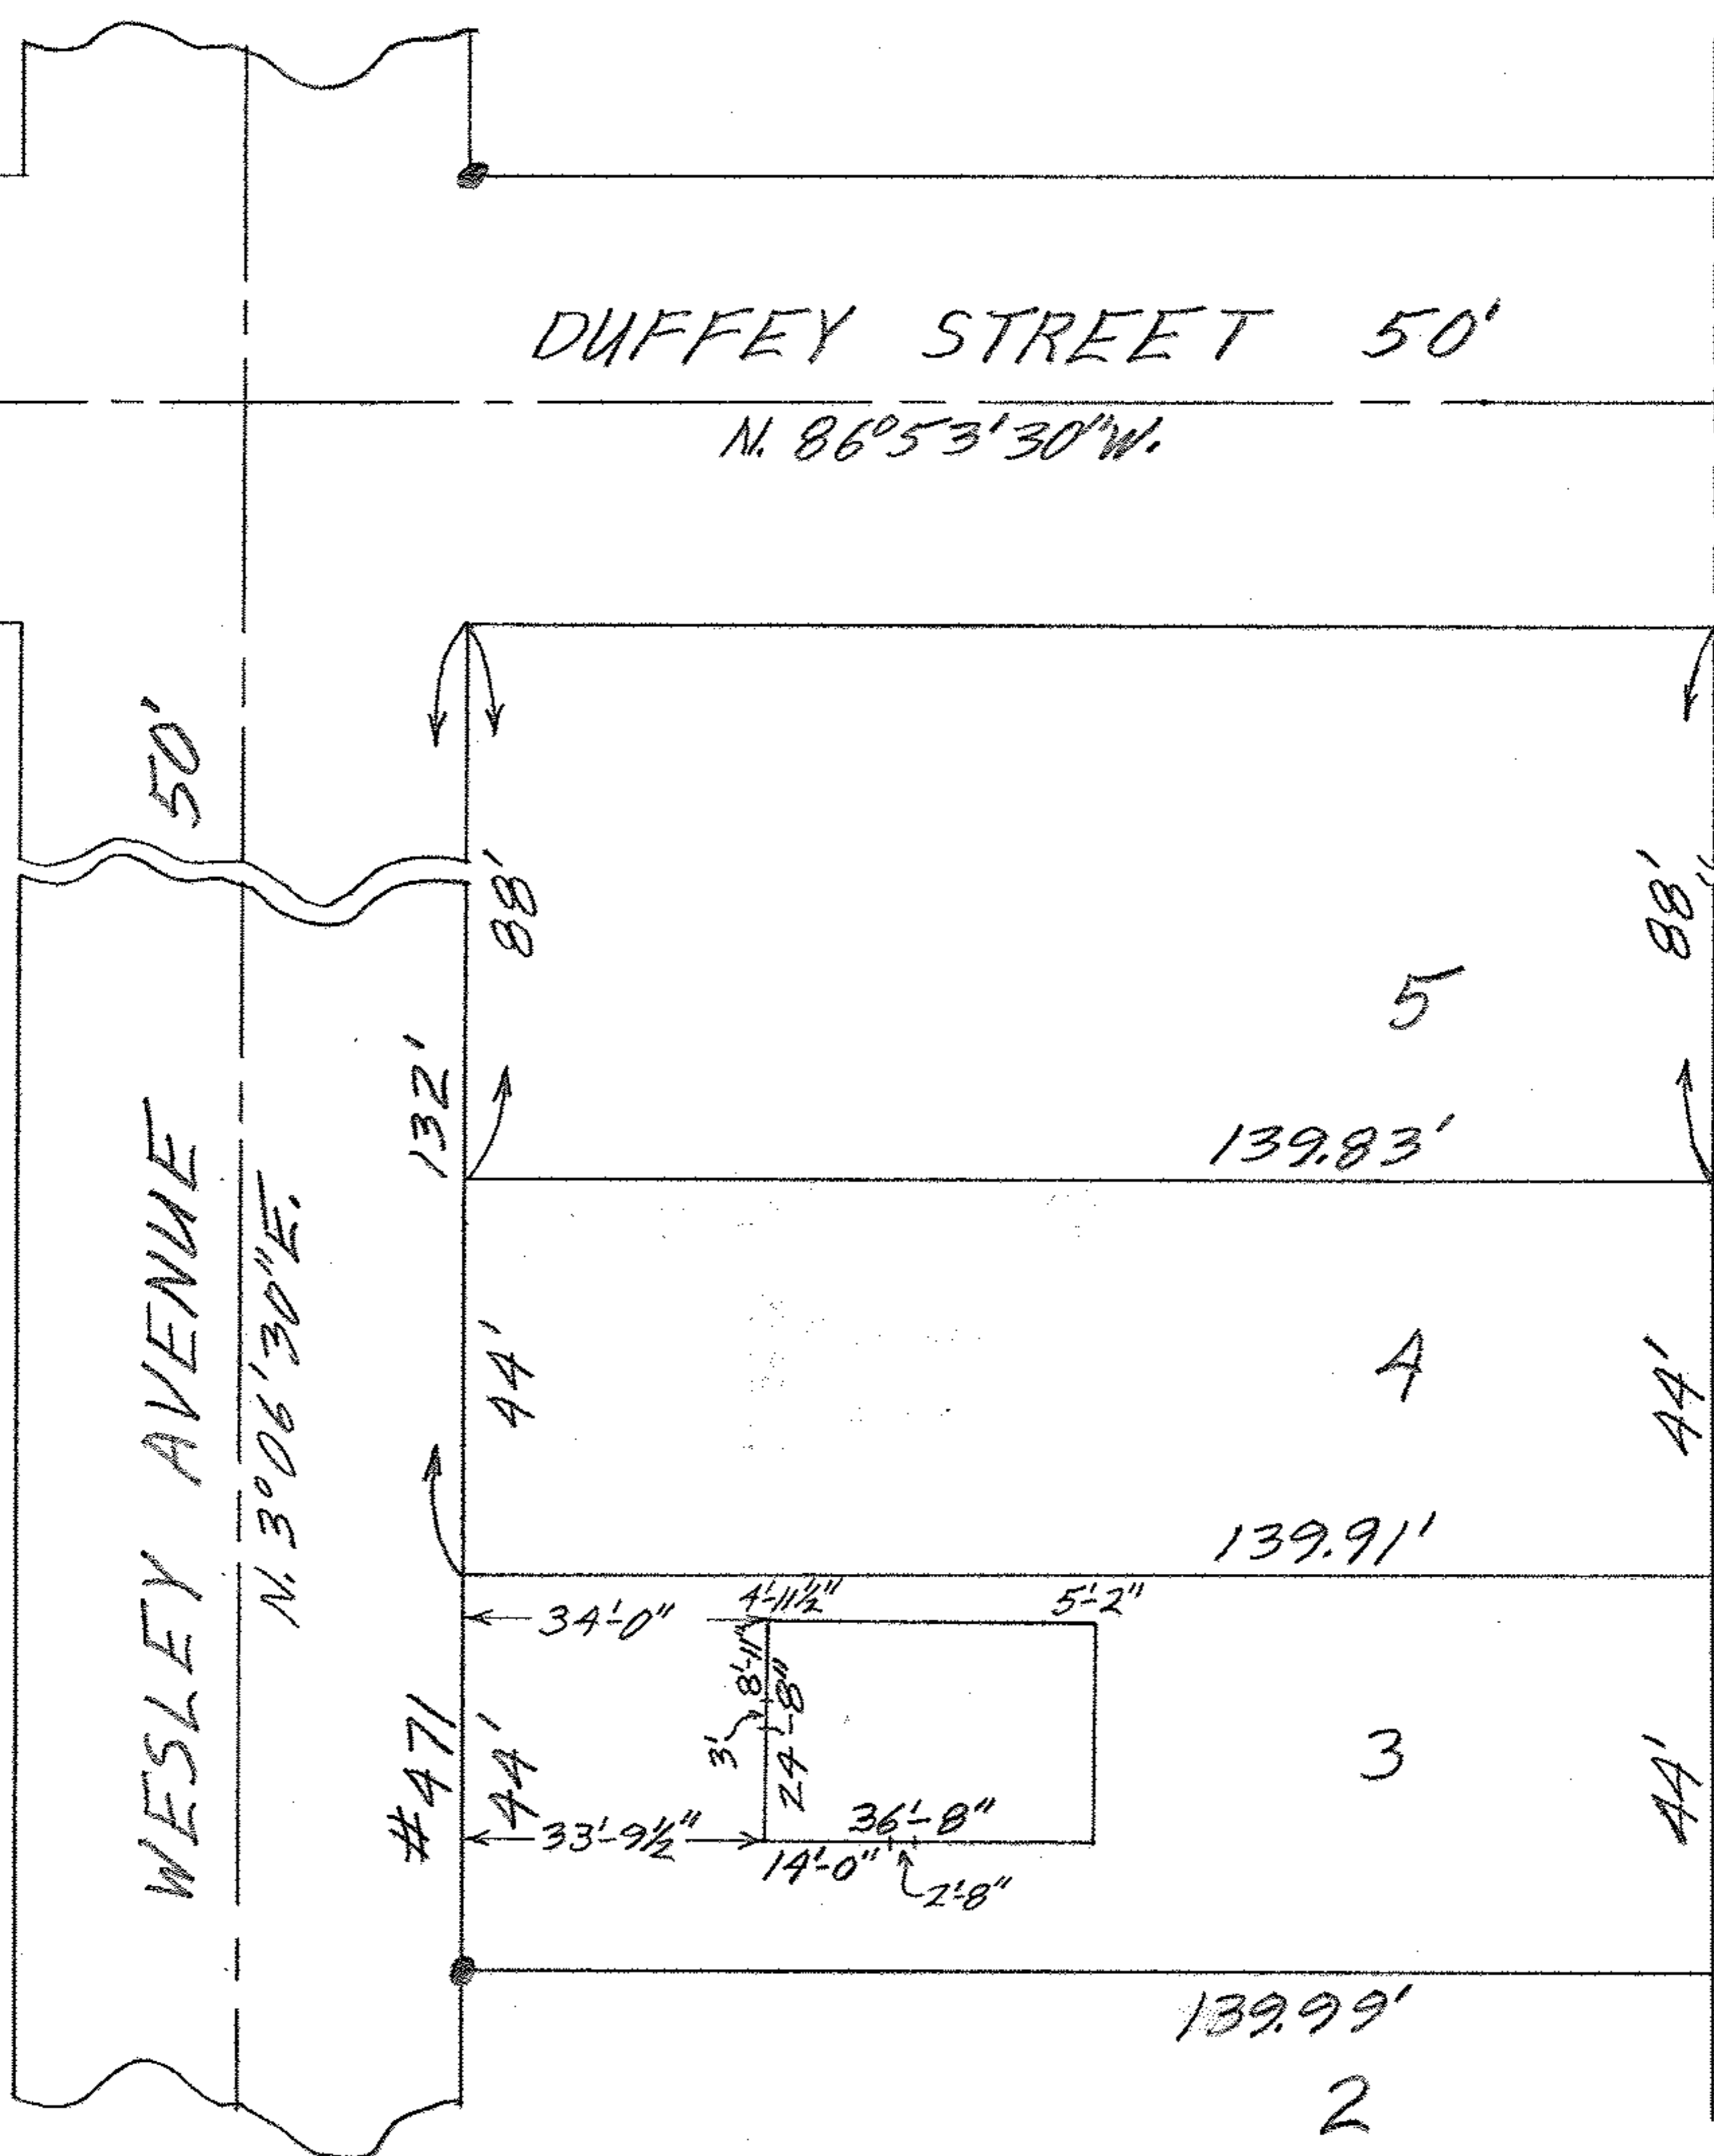

MAP OF SUB-LOT 3 - BLOCK 73
 CITY FARMS ALL'T. VOL. 9 Pg. 3 PLATS
 ELYRIA TWP. ELYRIA CITY
 LORAIN COUNTY OHIO
 SCALE: 1" = 30' FEB. 27 - 1963 4:30 P.M.
 Gary E. Penfound REG. SURVEYOR
 Edward W. Henderson