


06-25-023-102-022

6-71
Scan # 45937

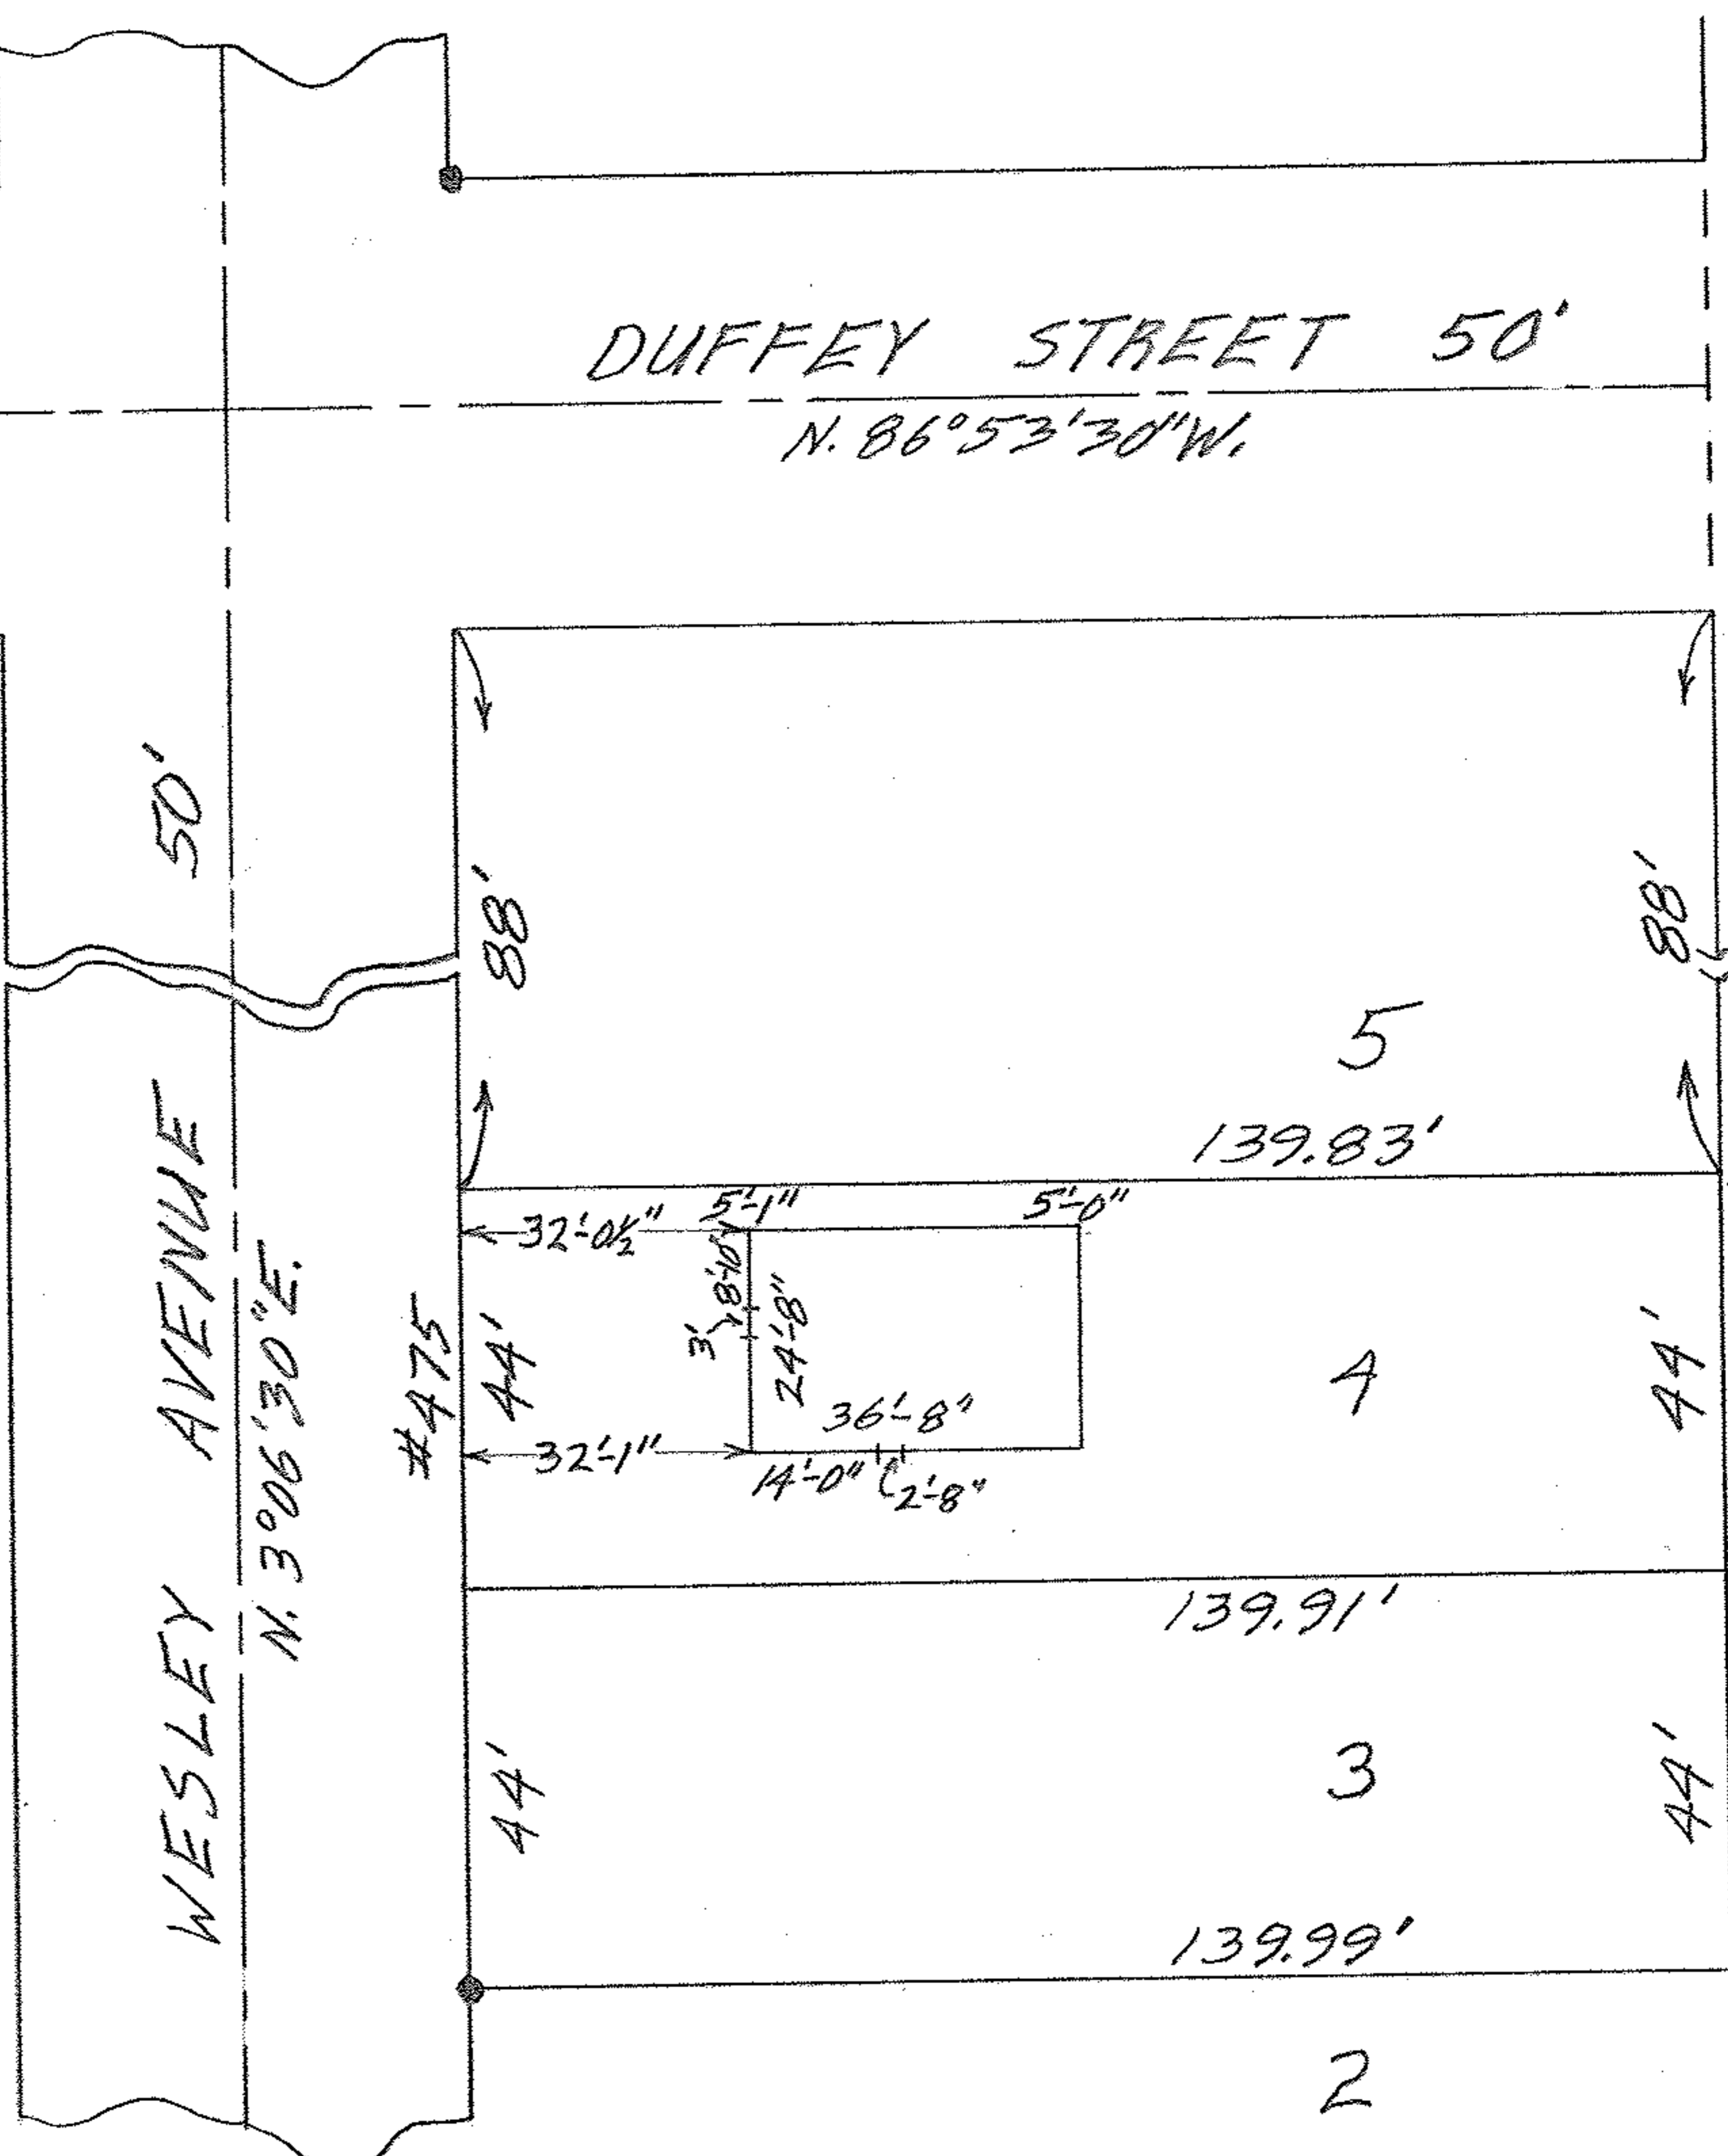

MAP OF SUB-LOT 4 - BLOCK 73
 CITY FARMS ALL'T. VOL. 9 Pg. 3 PLATS
 ELYRIA TWP. ELYRIA CITY
 LORAIN COUNTY OHIO
 SCALE: 1" = 30' MAR. 22-1963 1:45 P.M.
 Gary E. Penfound REG. SURVEYOR
 Nancy L. & Harvey L. Atterson