


06-25-023-102-630  
6-71  
SCAN # 45940

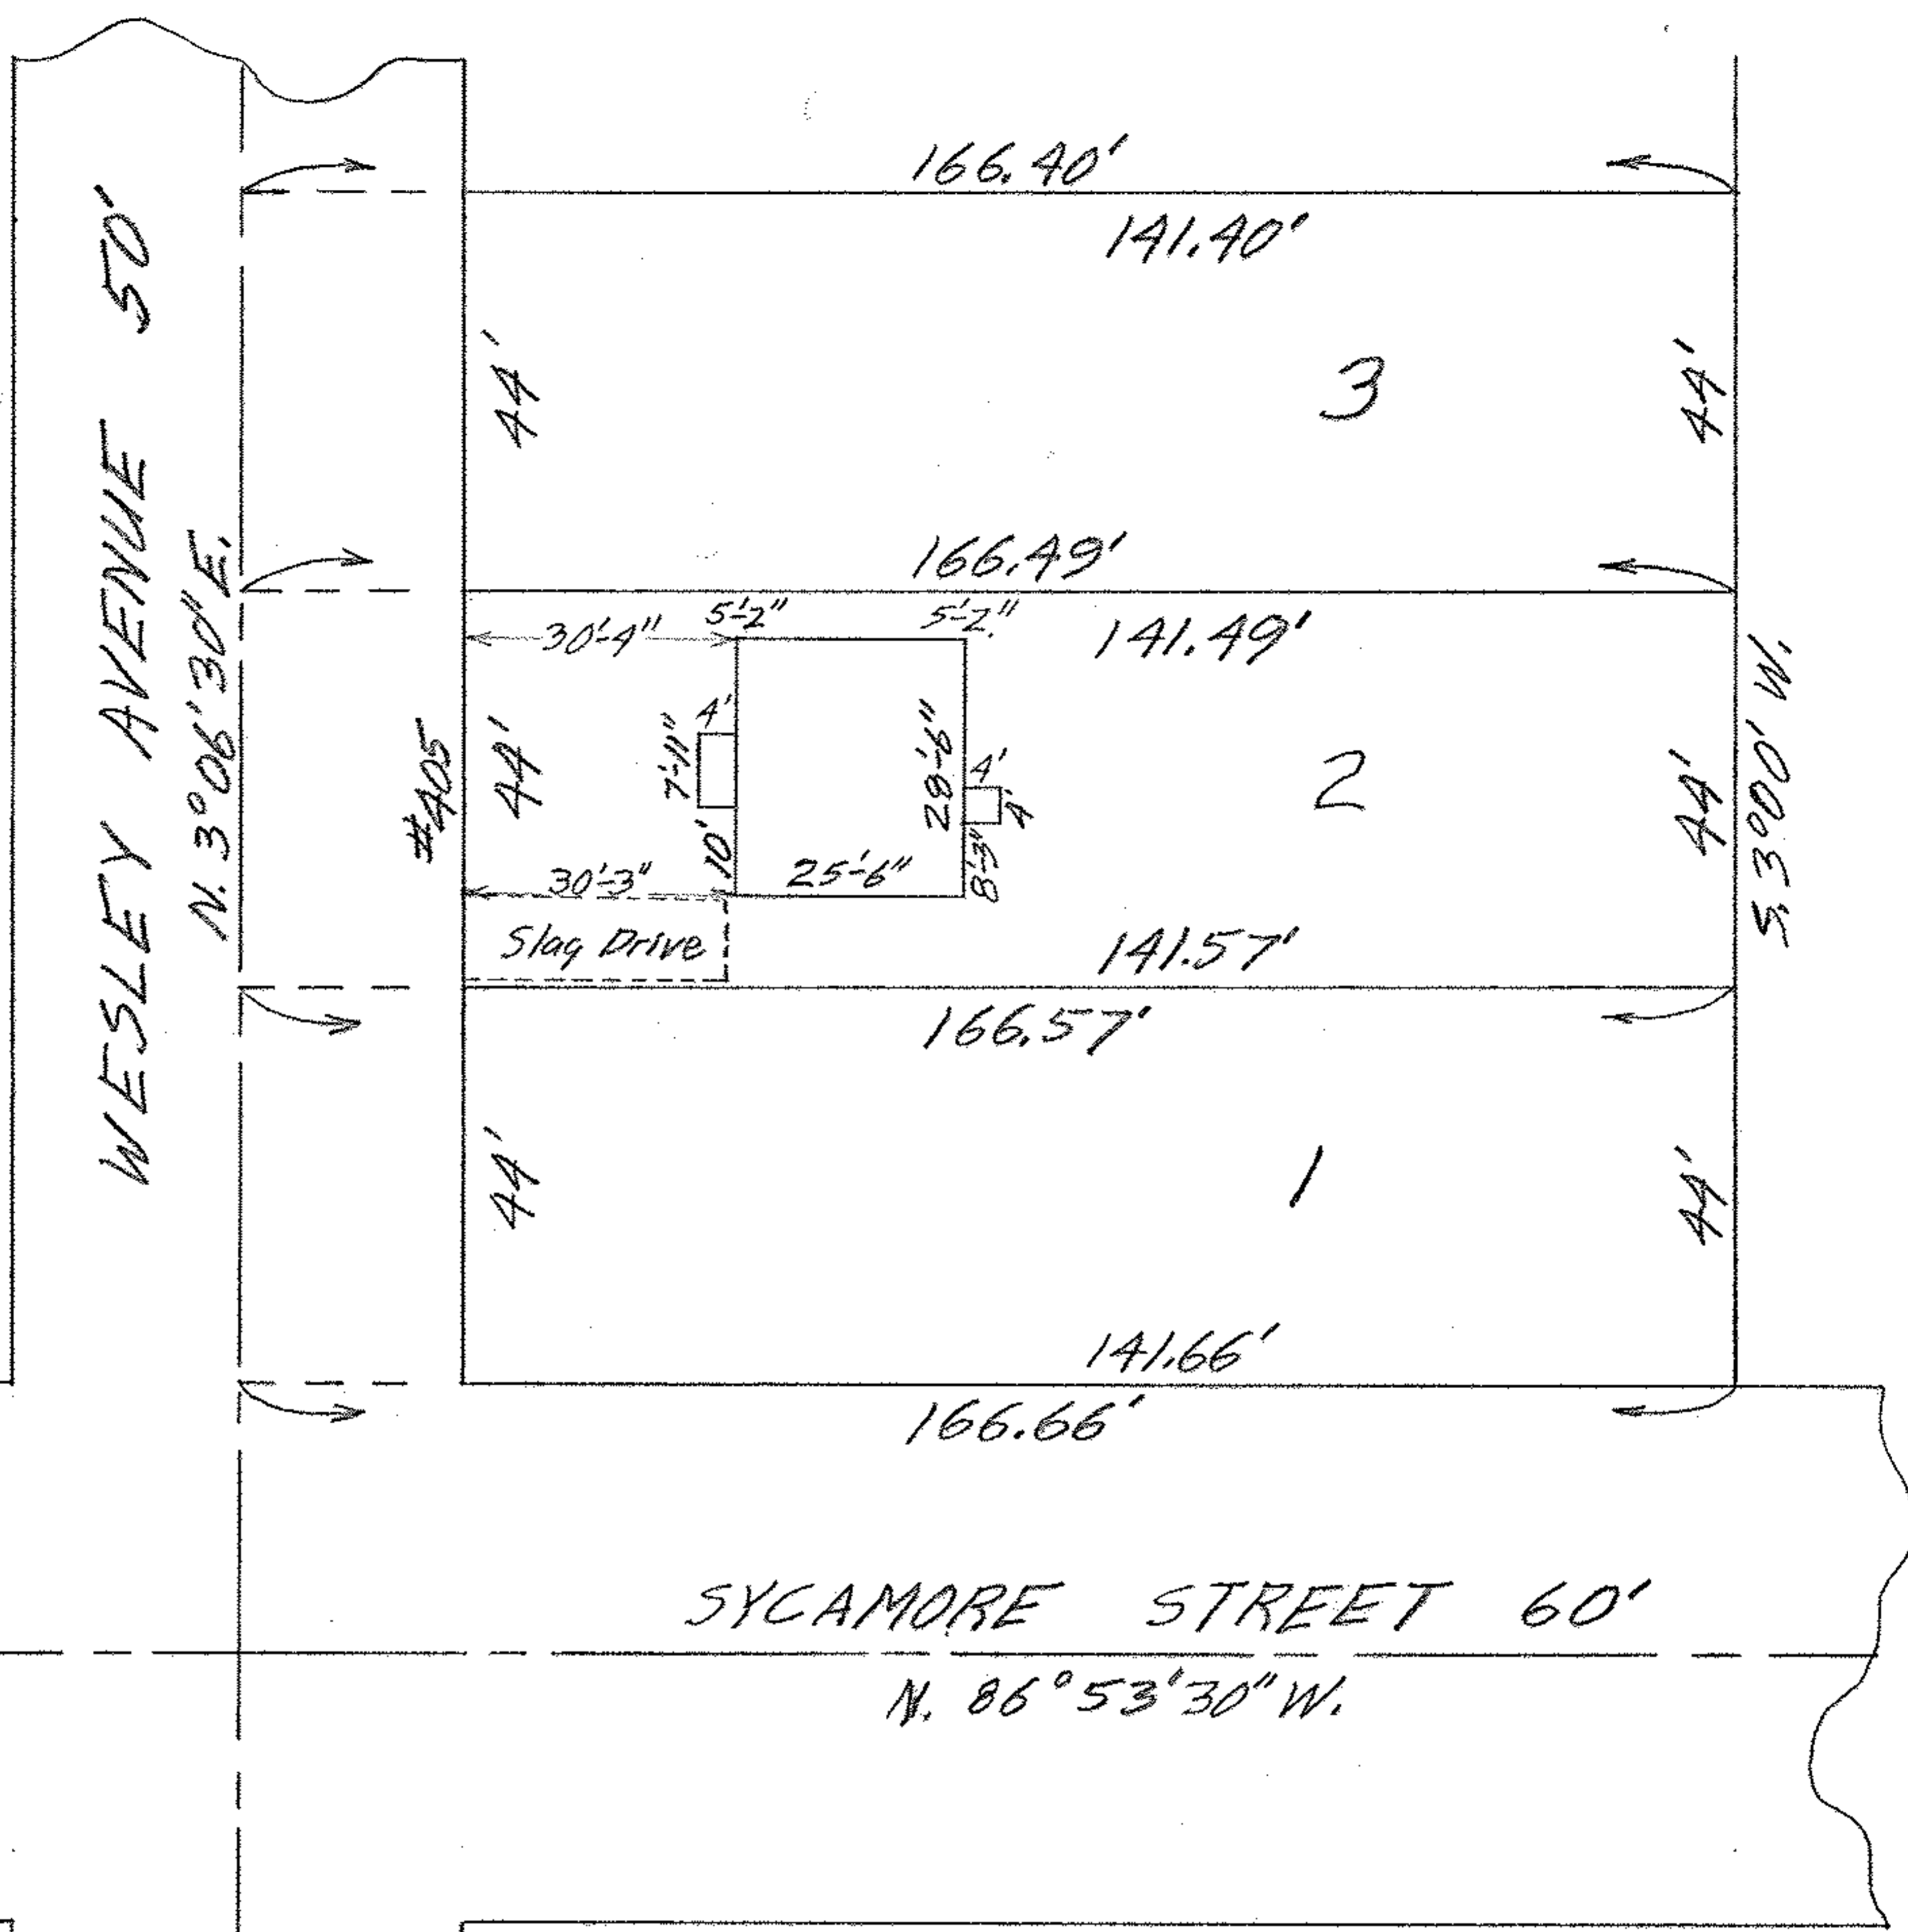

MAP OF SUB-LOT 2 BLOCK 70  
 CITY FARMS ALL'T. VOL. 9 PG. 3 PLATS  
 ELYRIA TWP. ELYRIA CITY  
 LORAIN COUNTY OHIO  
 SCALE: 1"=30' OCT. 26-1961 1:30 P.M.  
 Gary E. Penfound REG. SURVEYOR

Leonard C. Sesock