


06-25-023-103-020
 Z 6-89
 SCAC # 45942

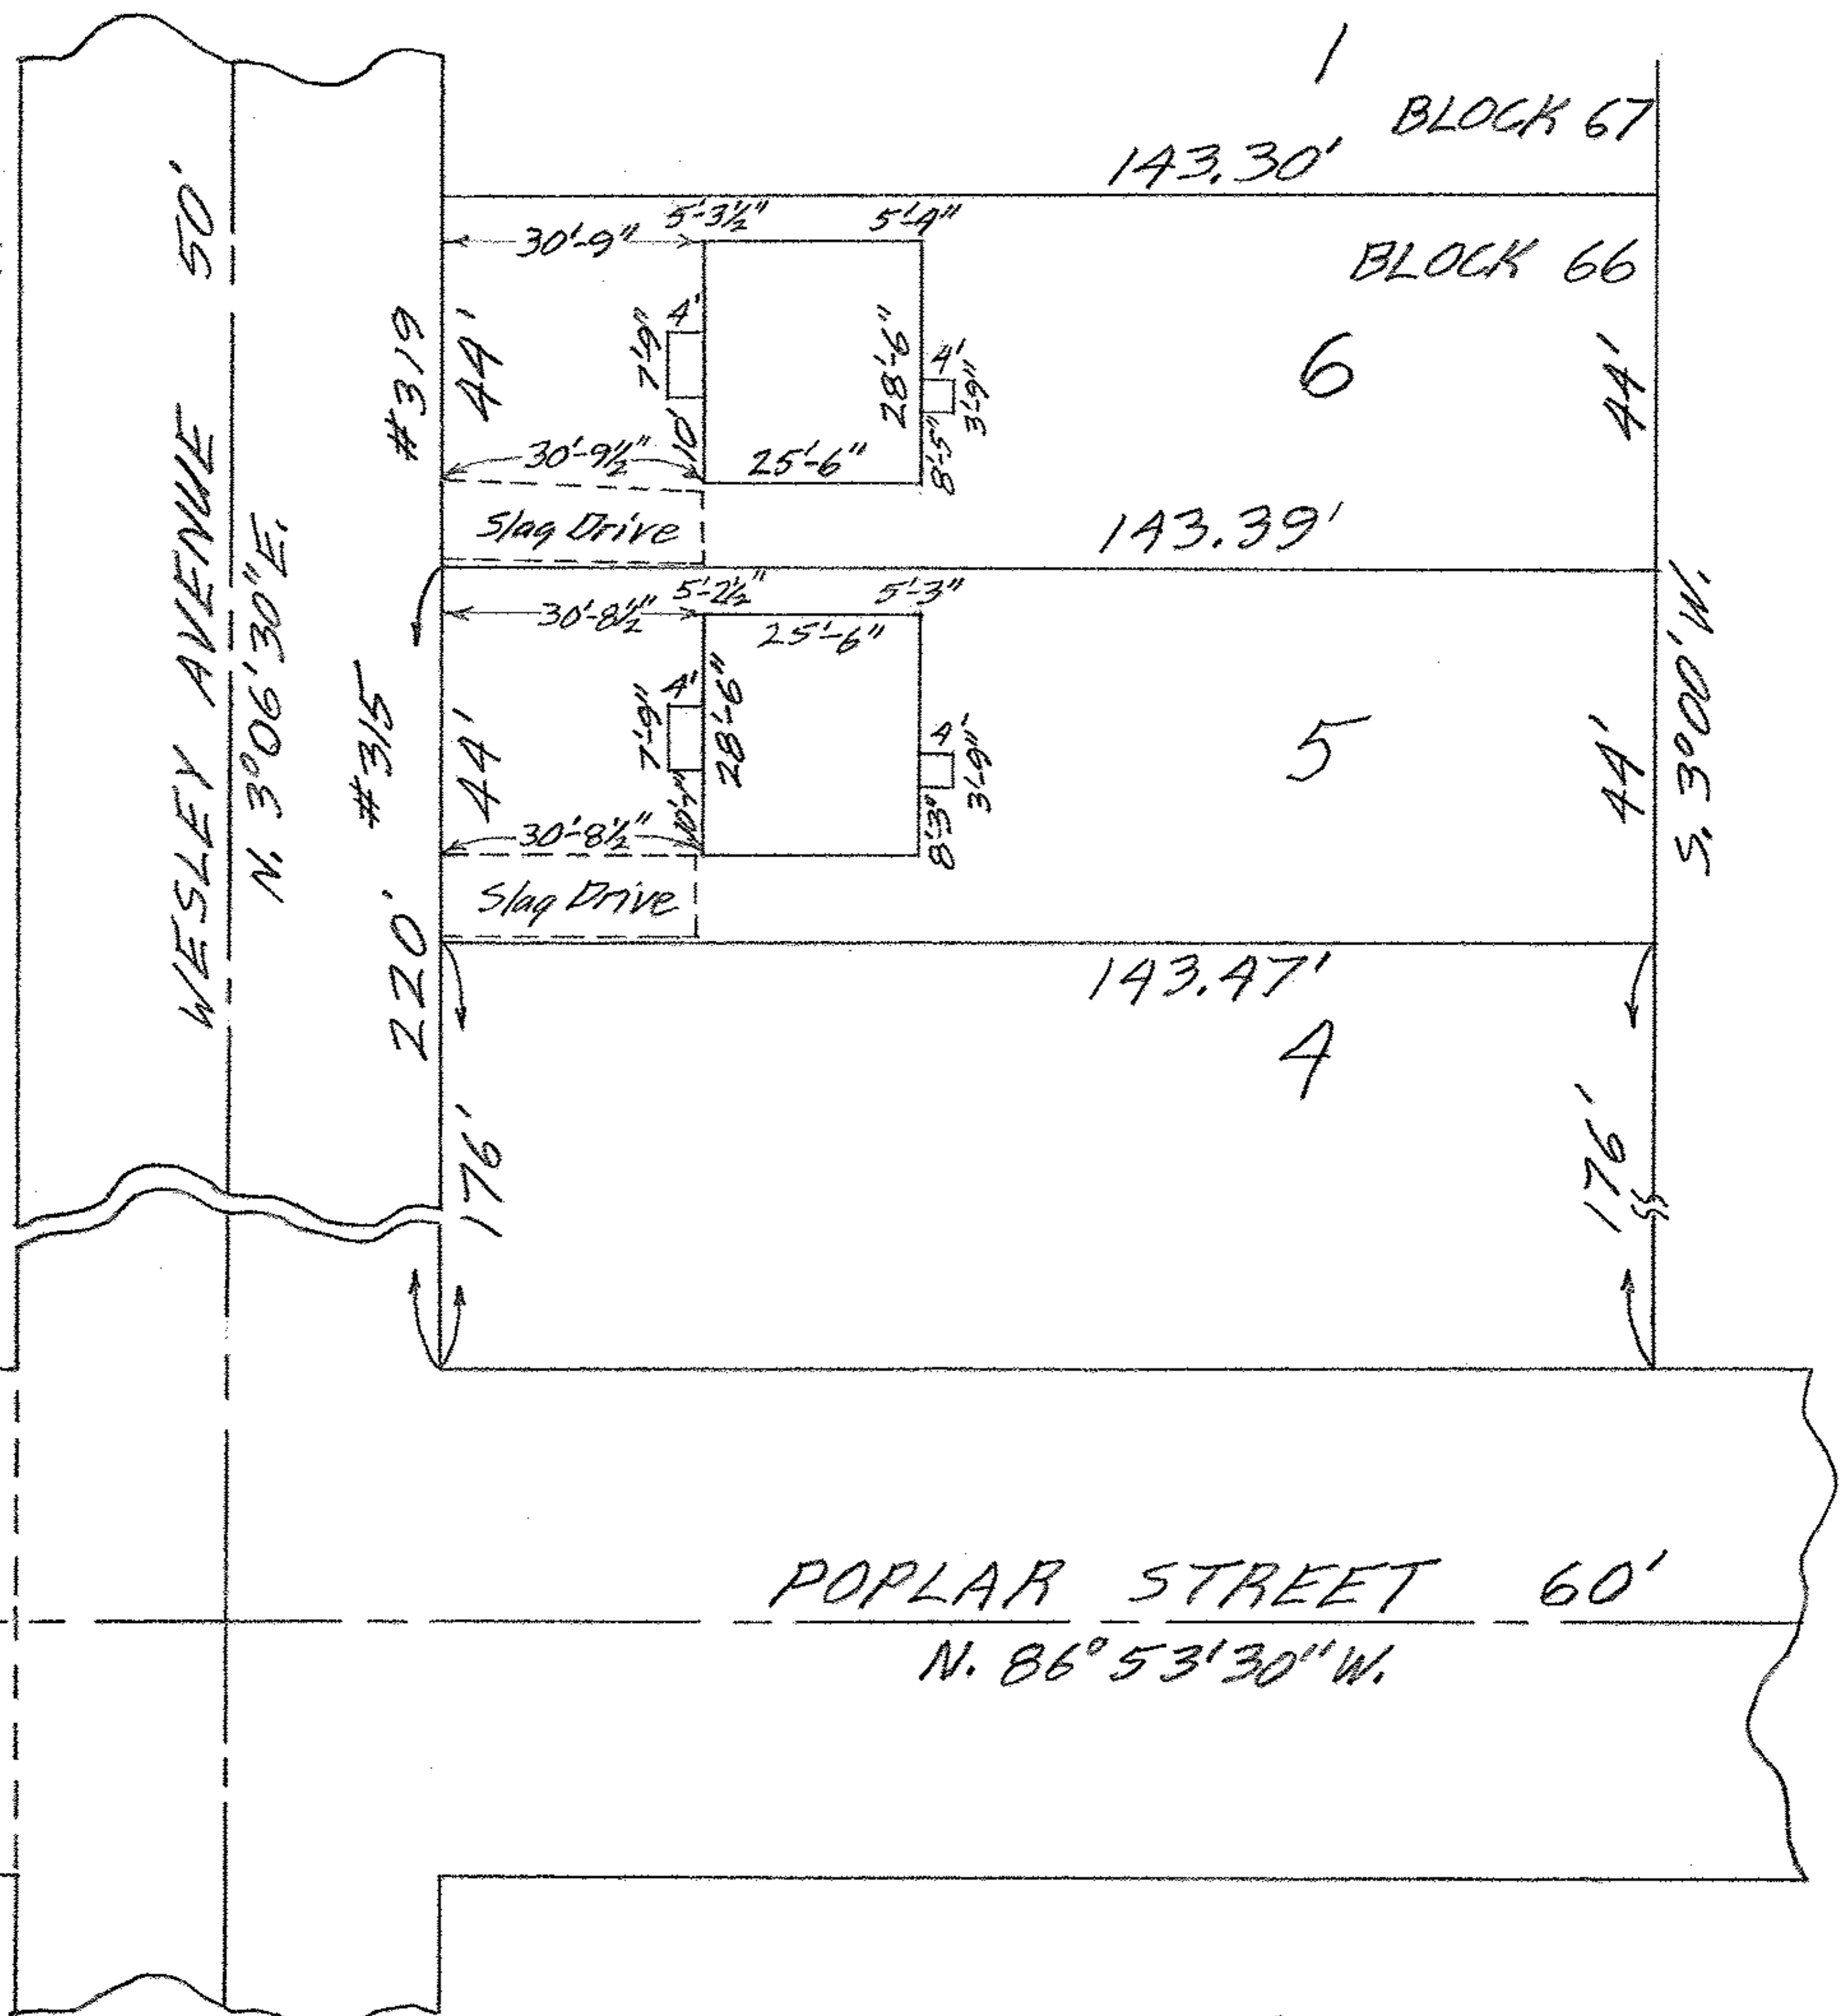

MAP OF SUB-LOT 5 BLOCK 66
 CITY FARMS ALL'T. VOL. 9 Pg. 3 PLATS
 ELYRIA TWP. ELYRIA CITY
 LORAIN COUNTY OHIO
 SCALE: 1" = 30' JAN. 16-1962 4:15 P.M.
 Gary E. Perfound REG. SURVEYOR

William R. Gibbons