


00-25-028-100-004

6-54
SCAN # 45967

CITY TITLE Co. Order No. E-828
Gale R. & Joanne H. Downey
to Joseph T. Militello

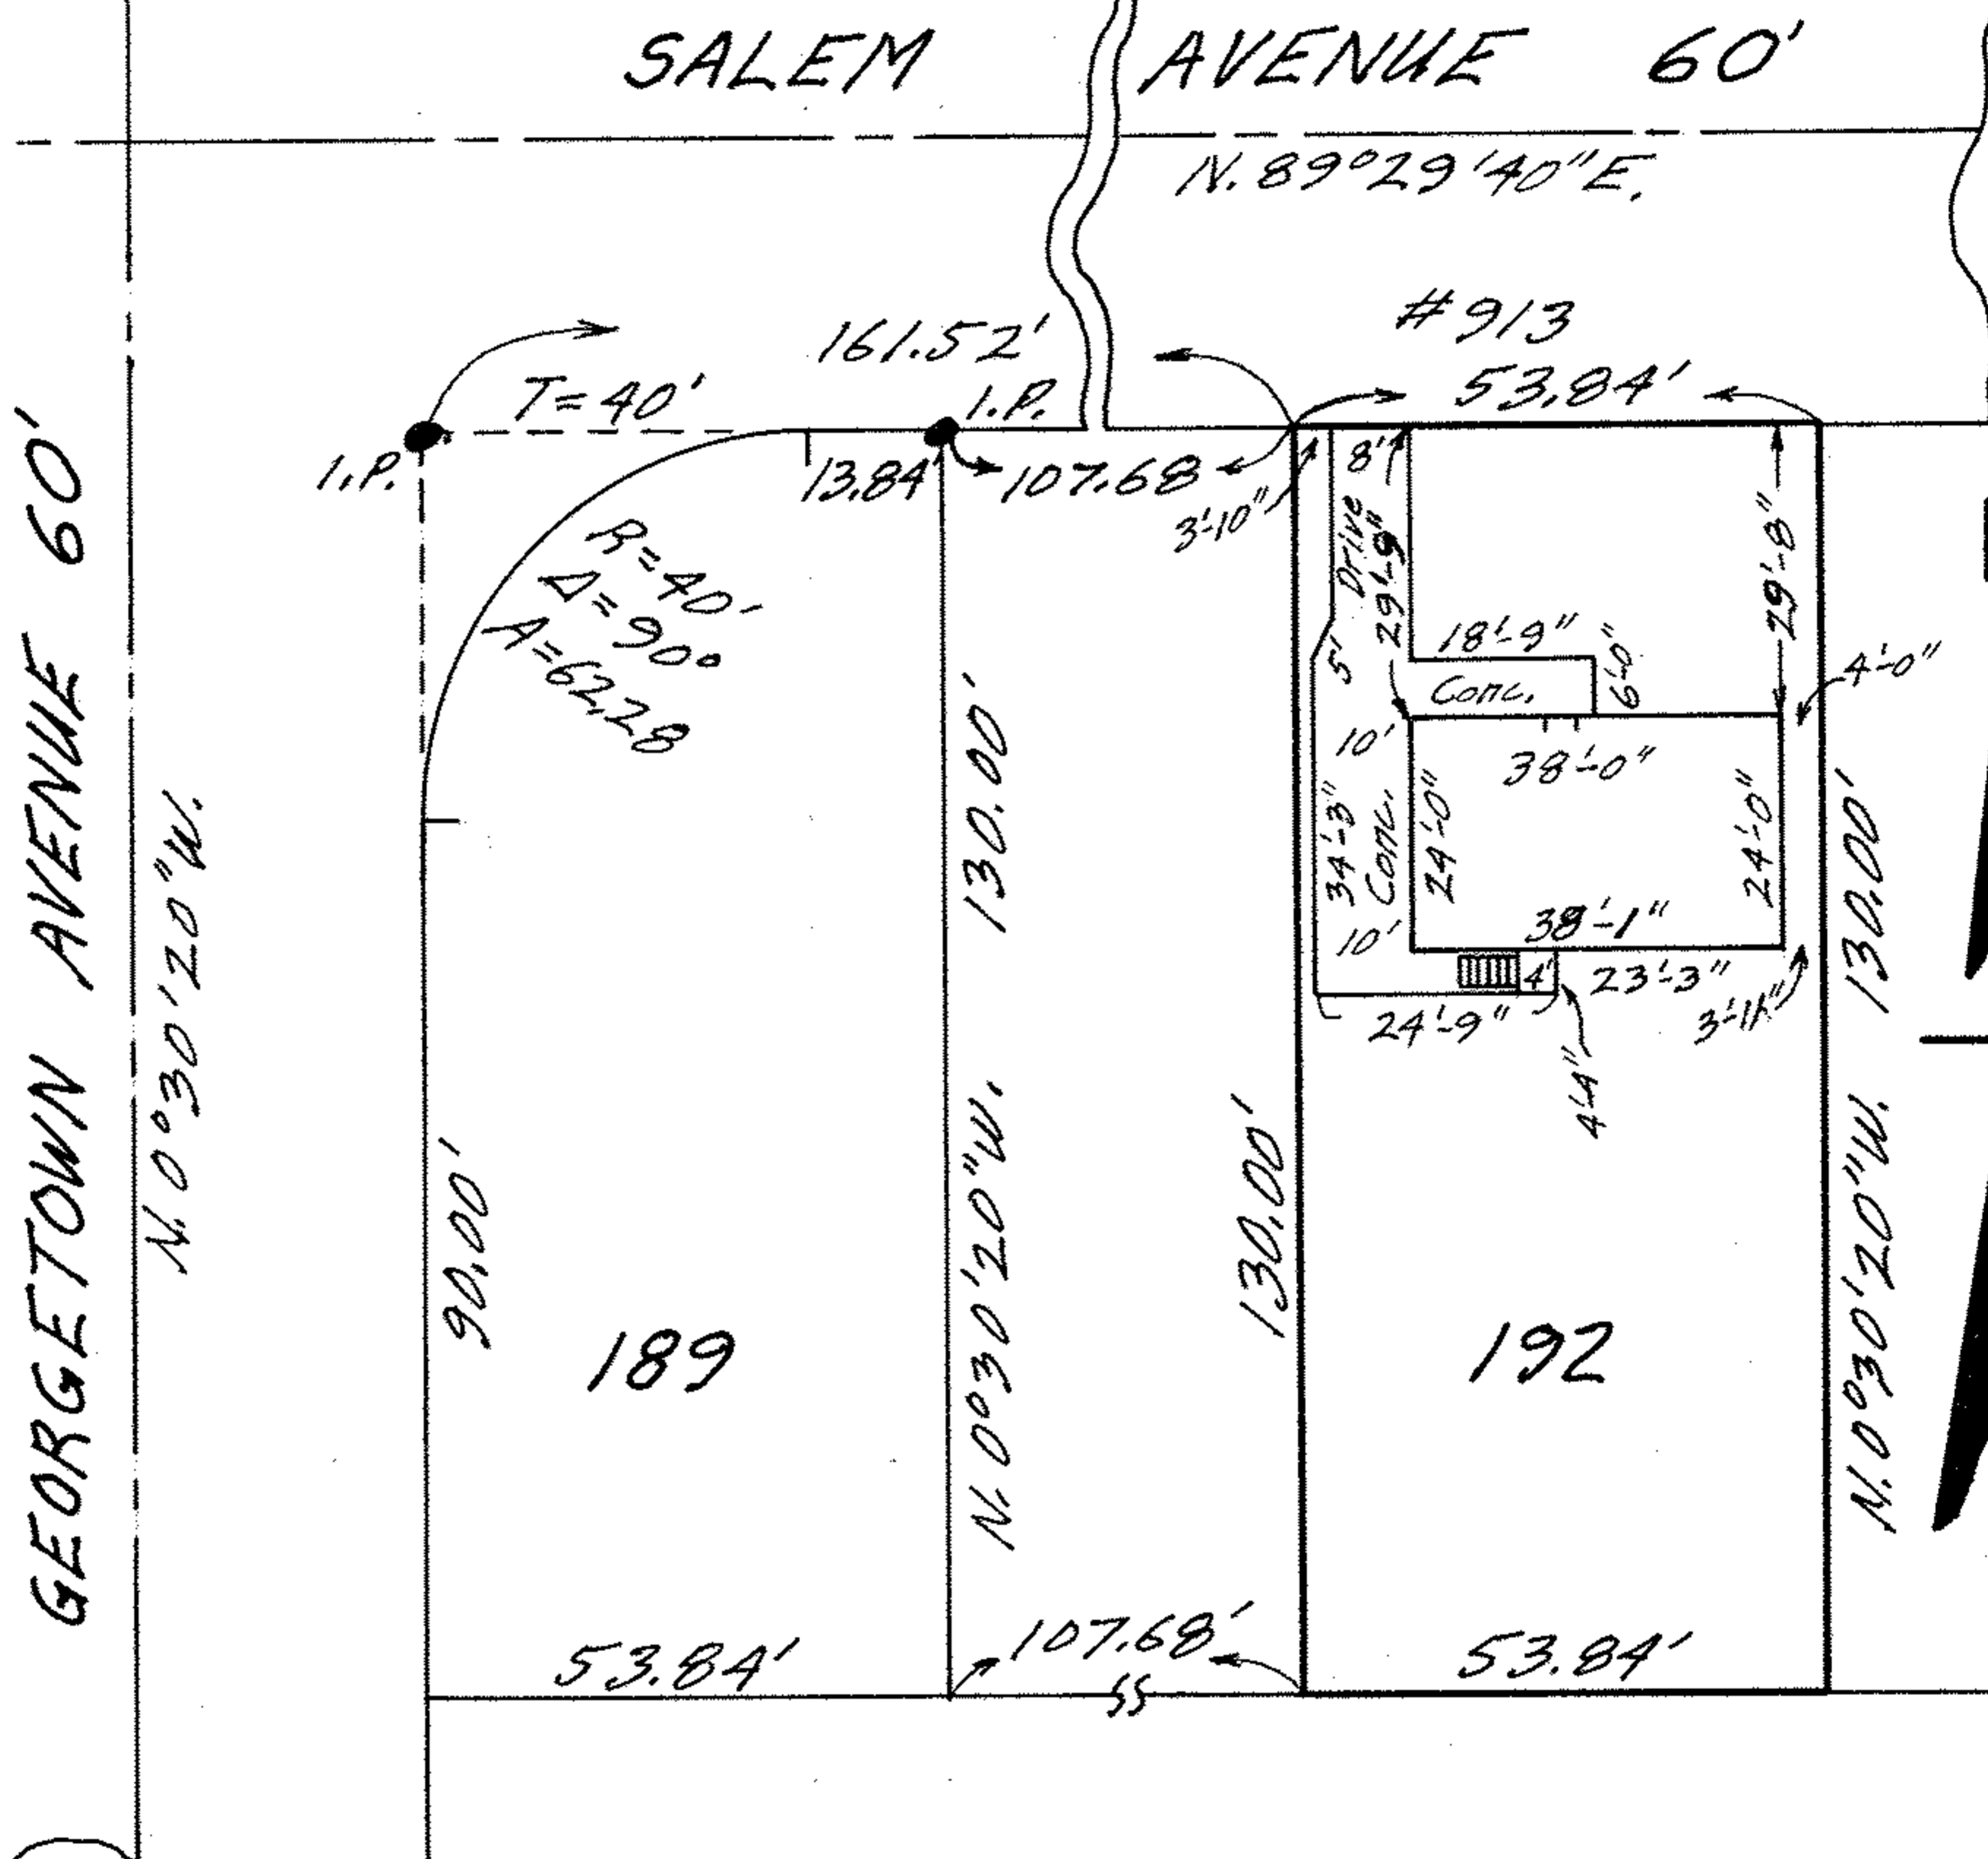

MAP OF SUB-LOT NO. 192
 AUDITOR'S PLAT OF FAIRWOOD SUB'N. NO. 1 REVISED
 VOL. 23 Pgs. 18 & 19 PLATS
 ORIG. LOT 28 - EAST OF BLACK RIVER - ELYRIA TWP.
 ELYRIA CITY LORAIN COUNTY OHIO
 SCALE: 1" = 30' SEPT. 9 - 1969 4:45 P.M.
 NOTE: There are no encroachments on the above property.
 Gary E. Penfound REG. SURVEYOR NO. 4457