


06.25.032.106.01-014

6-68

E WEST HILLIARD RD. 100' SCAN # 45981

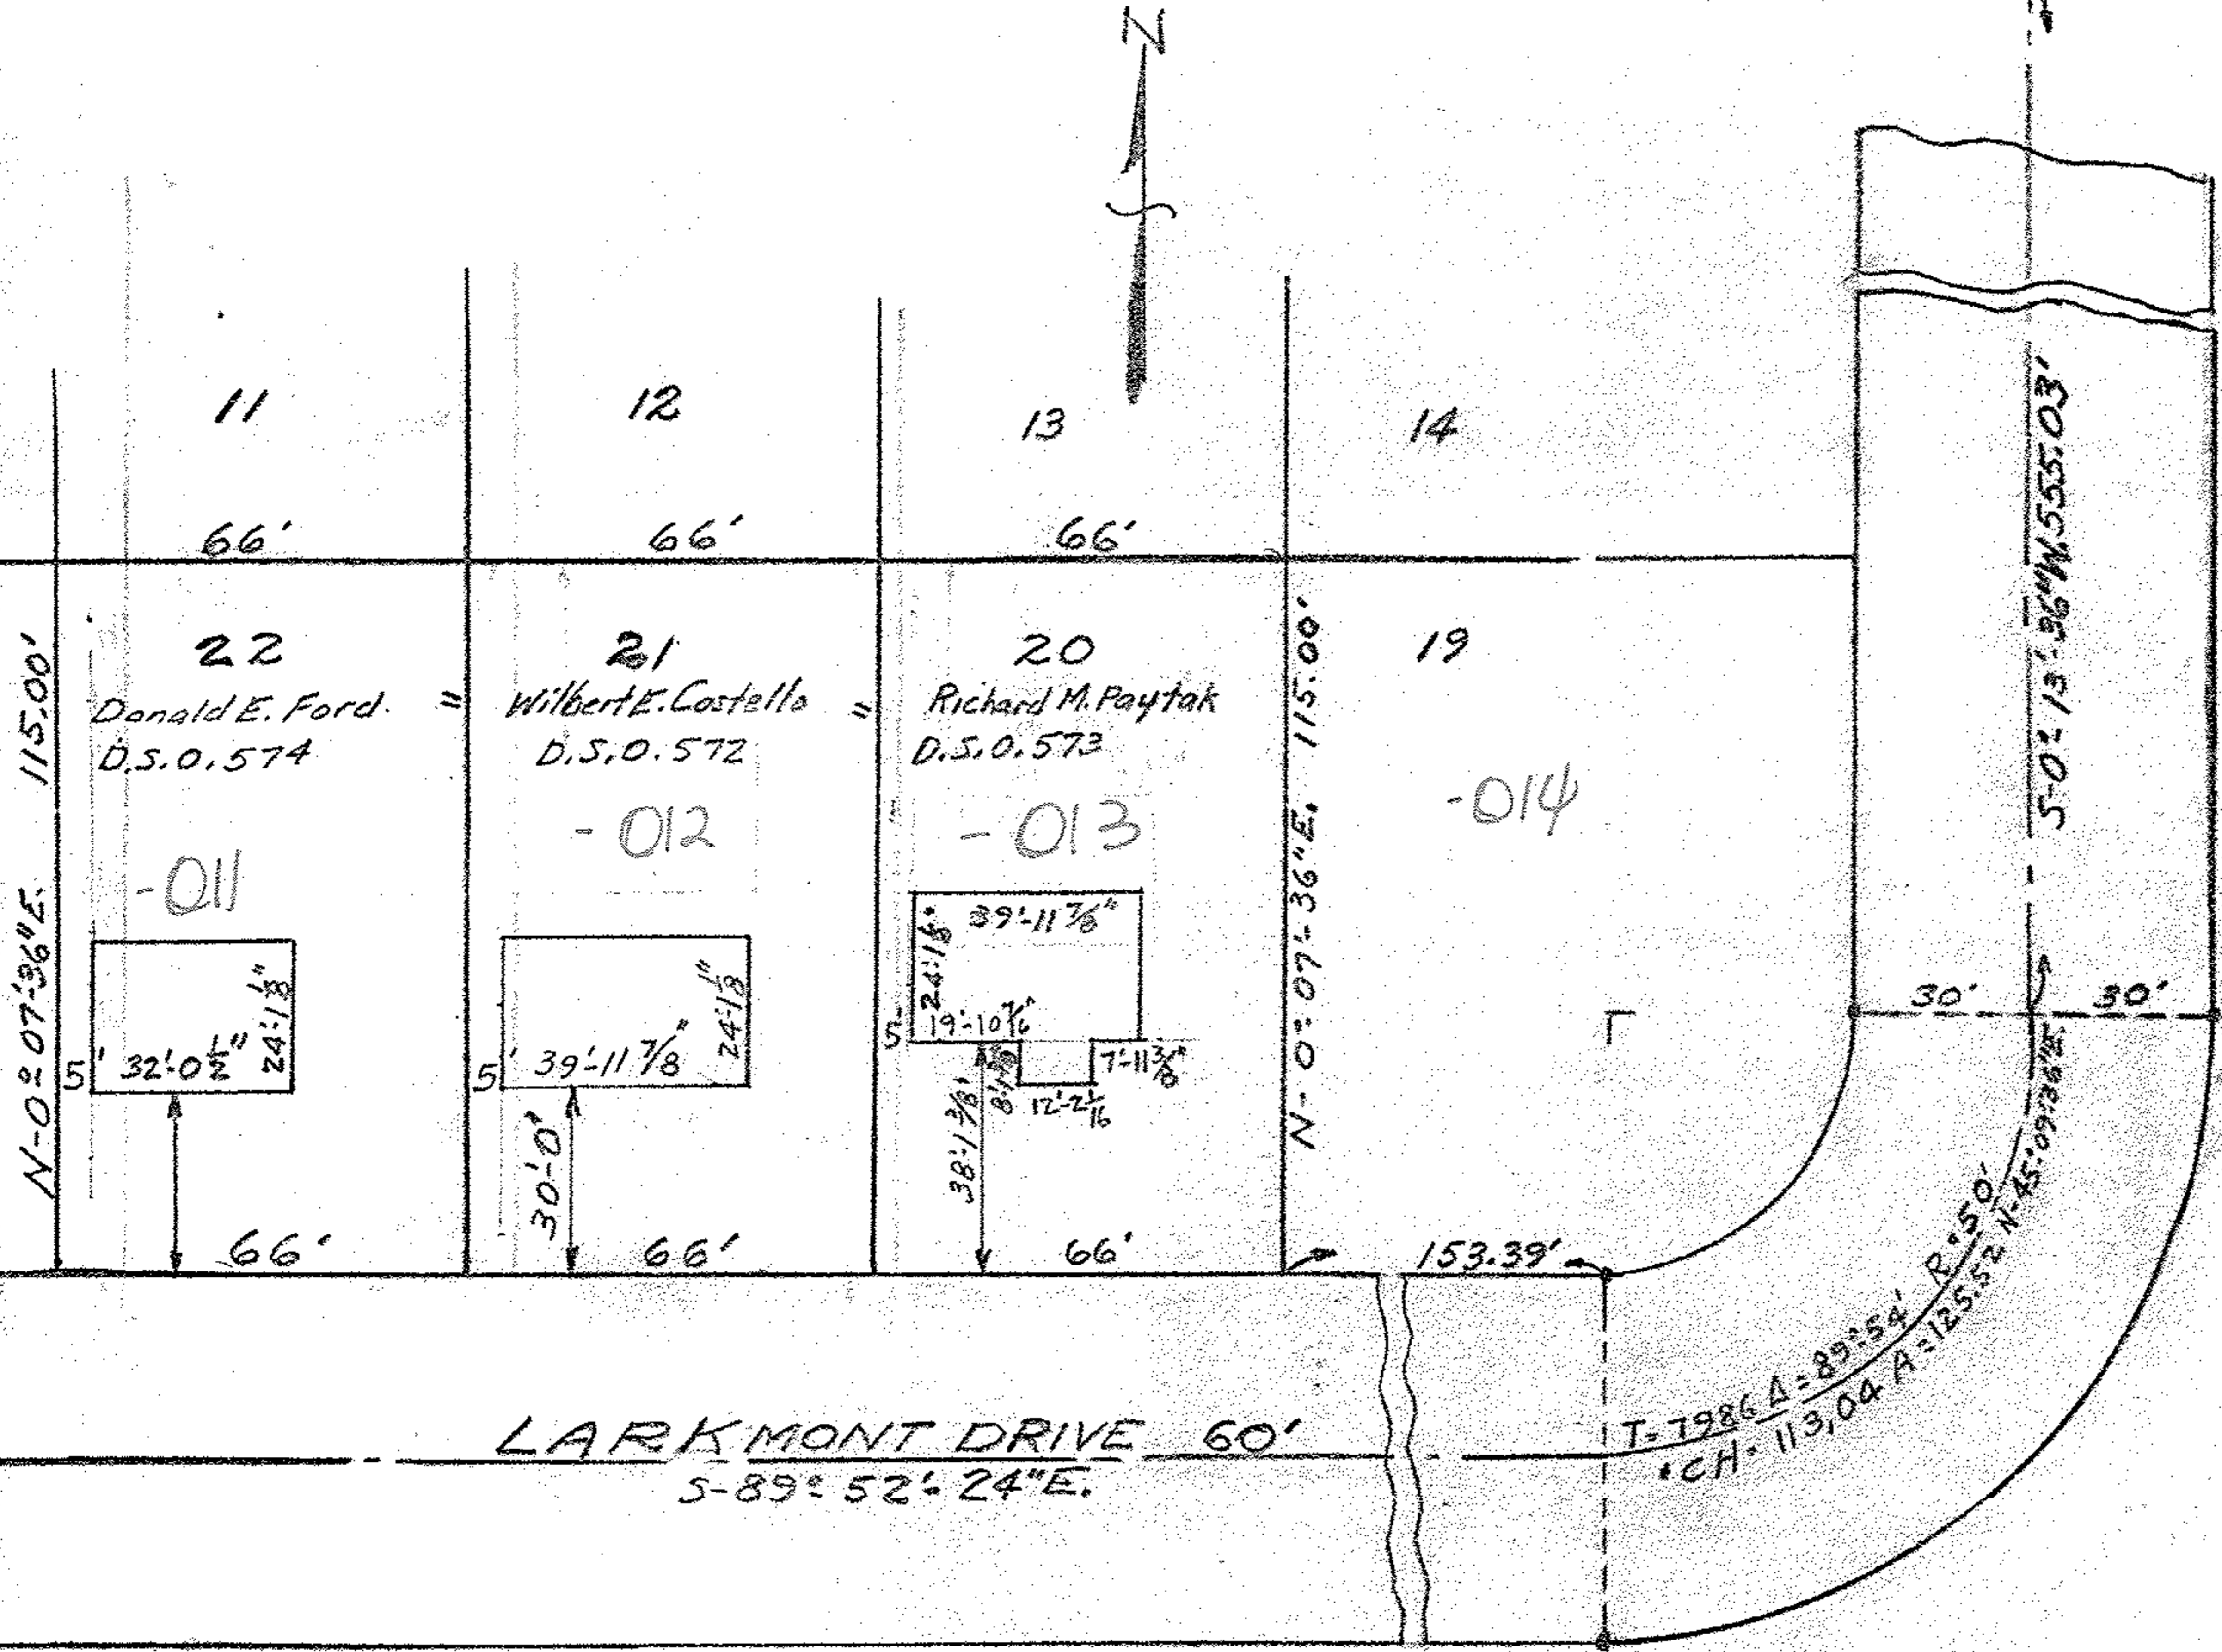

SURVEY FOR THE MEISTER CO.
 & MAP OF SUB-LOT NO. 8
 SPRING VALLEY SUBIN NO. 8 VOL. 18 PG. 28
 OL. 32-33 ELYRIA TWP. EAST OF BLACK RIVER
 LORAIN COUNTY OHIO
 SCALE 1"=40' 1956
 C.E. Engfound Registered Surveyor

