

06-25-033-103-004,005

6-84

SCAN # 45989

BRANDSTON AVENUE 50'



#371

I.P.

I.P.

POPLAR STREET 60'

5.89°33'E.

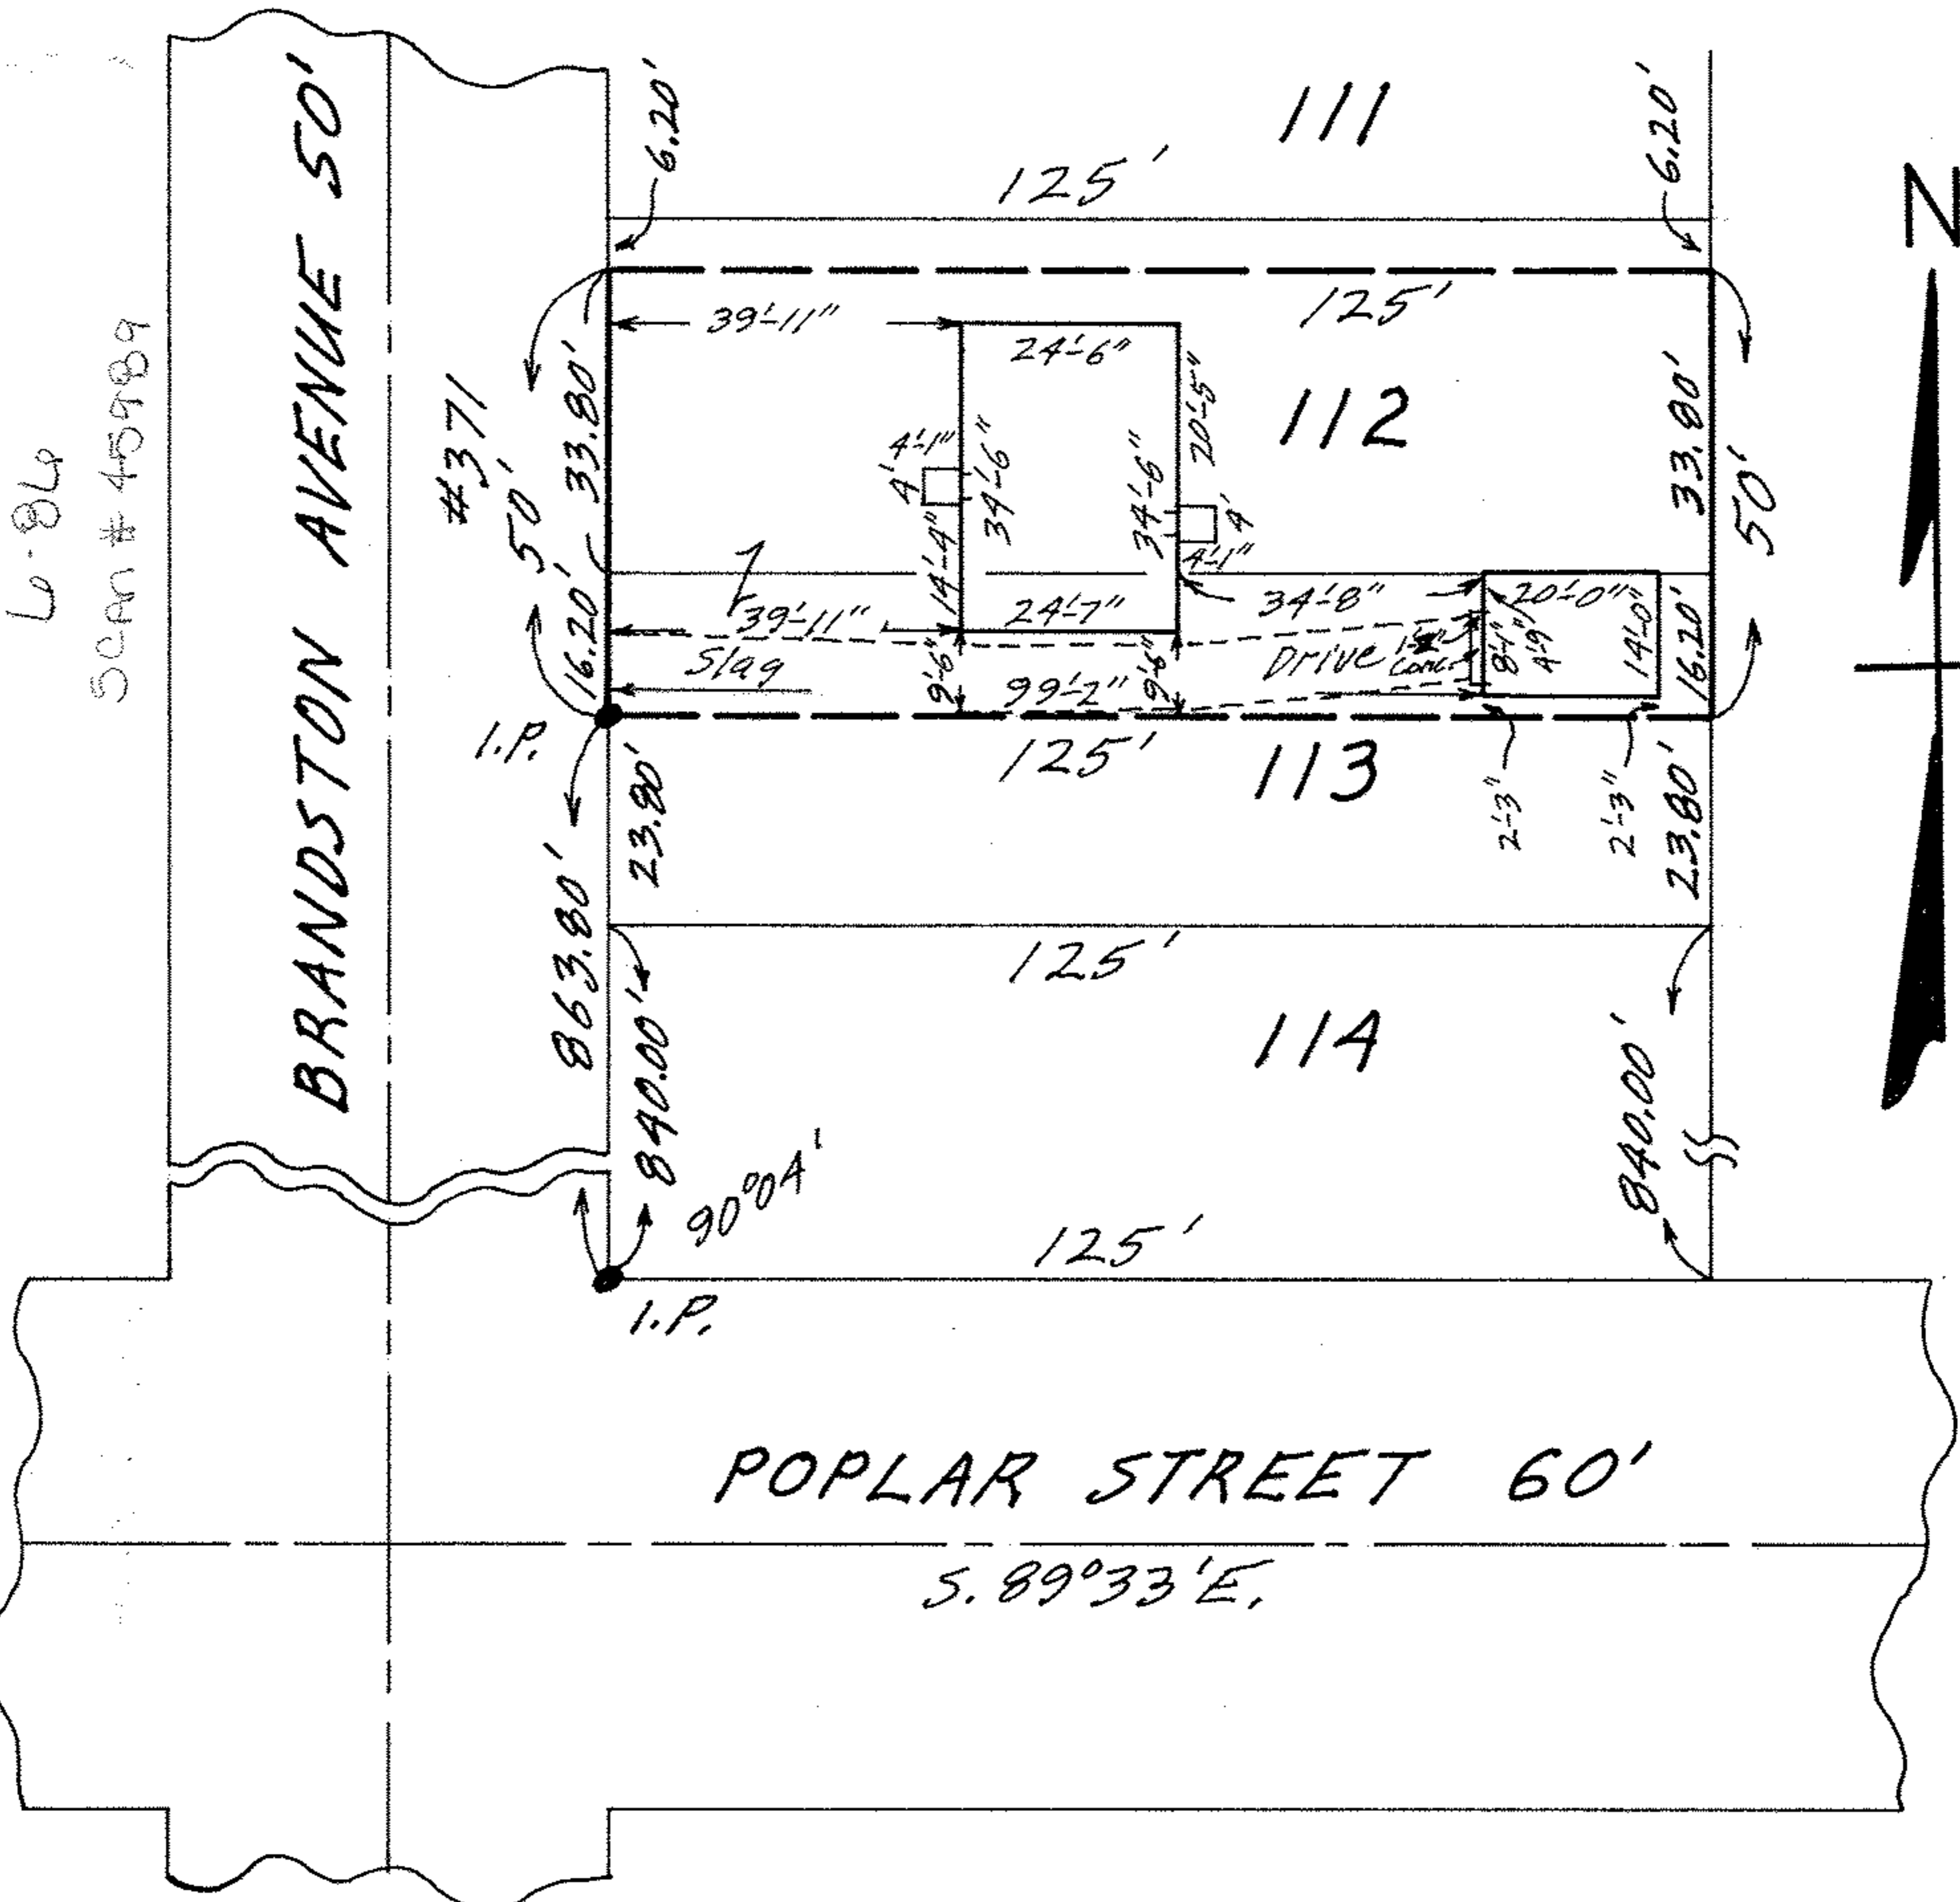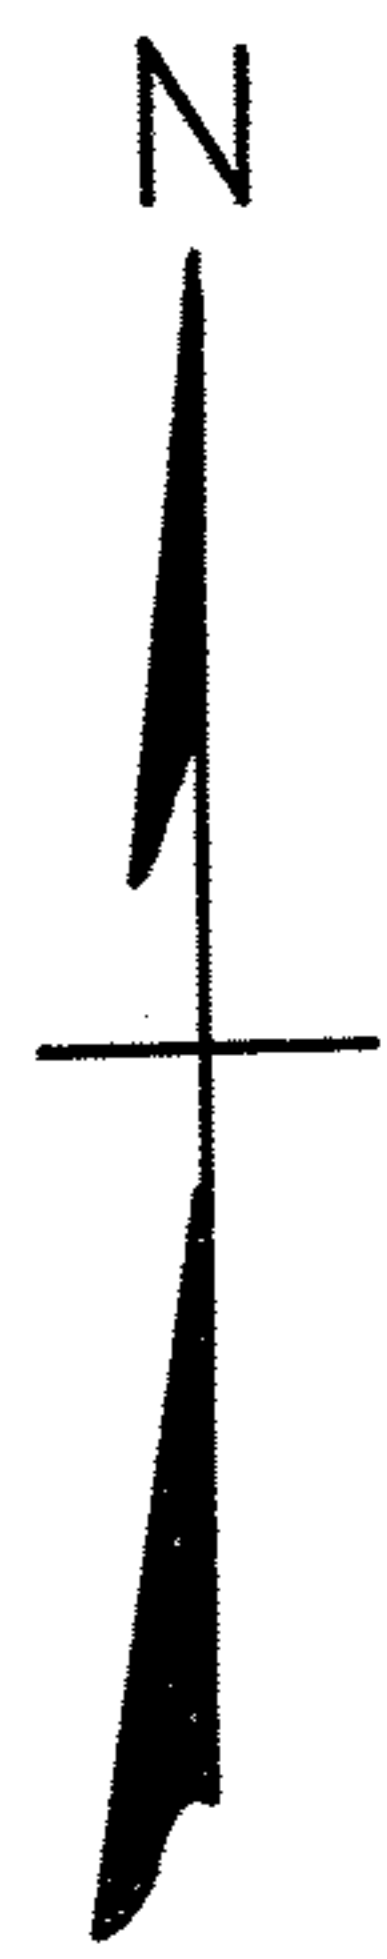

MAP OF THE SOUTHERLY 33.80' FEET OF SUB-LOT NO. 112 AND THE NORTHERLY 16.20 FEET OF SUB-LOT NO. 113 PASADENA PARK ALL'T. VOL. 10 PG. 7 PLATS ORIG. LOTS 17 & 33 - EAST OF BLACK RIVER - ELYRIA TWP. ELYRIA CITY LORAIN COUNTY OHIO SCALE: 1"=30' APRIL 3-1970 5:45 P.M.

NOTE: There are no encroachments on this property.

Gary E. Penfound REG. SURVEYOR NO. 4457
 CITY TITLE Co. Order No. E-1080-1
 Higgins Electric Co. to Bernard K. & Elizabeth Mills