


06-25-034-104-017, 020, 008, 007

6-104 SCAN # 45990

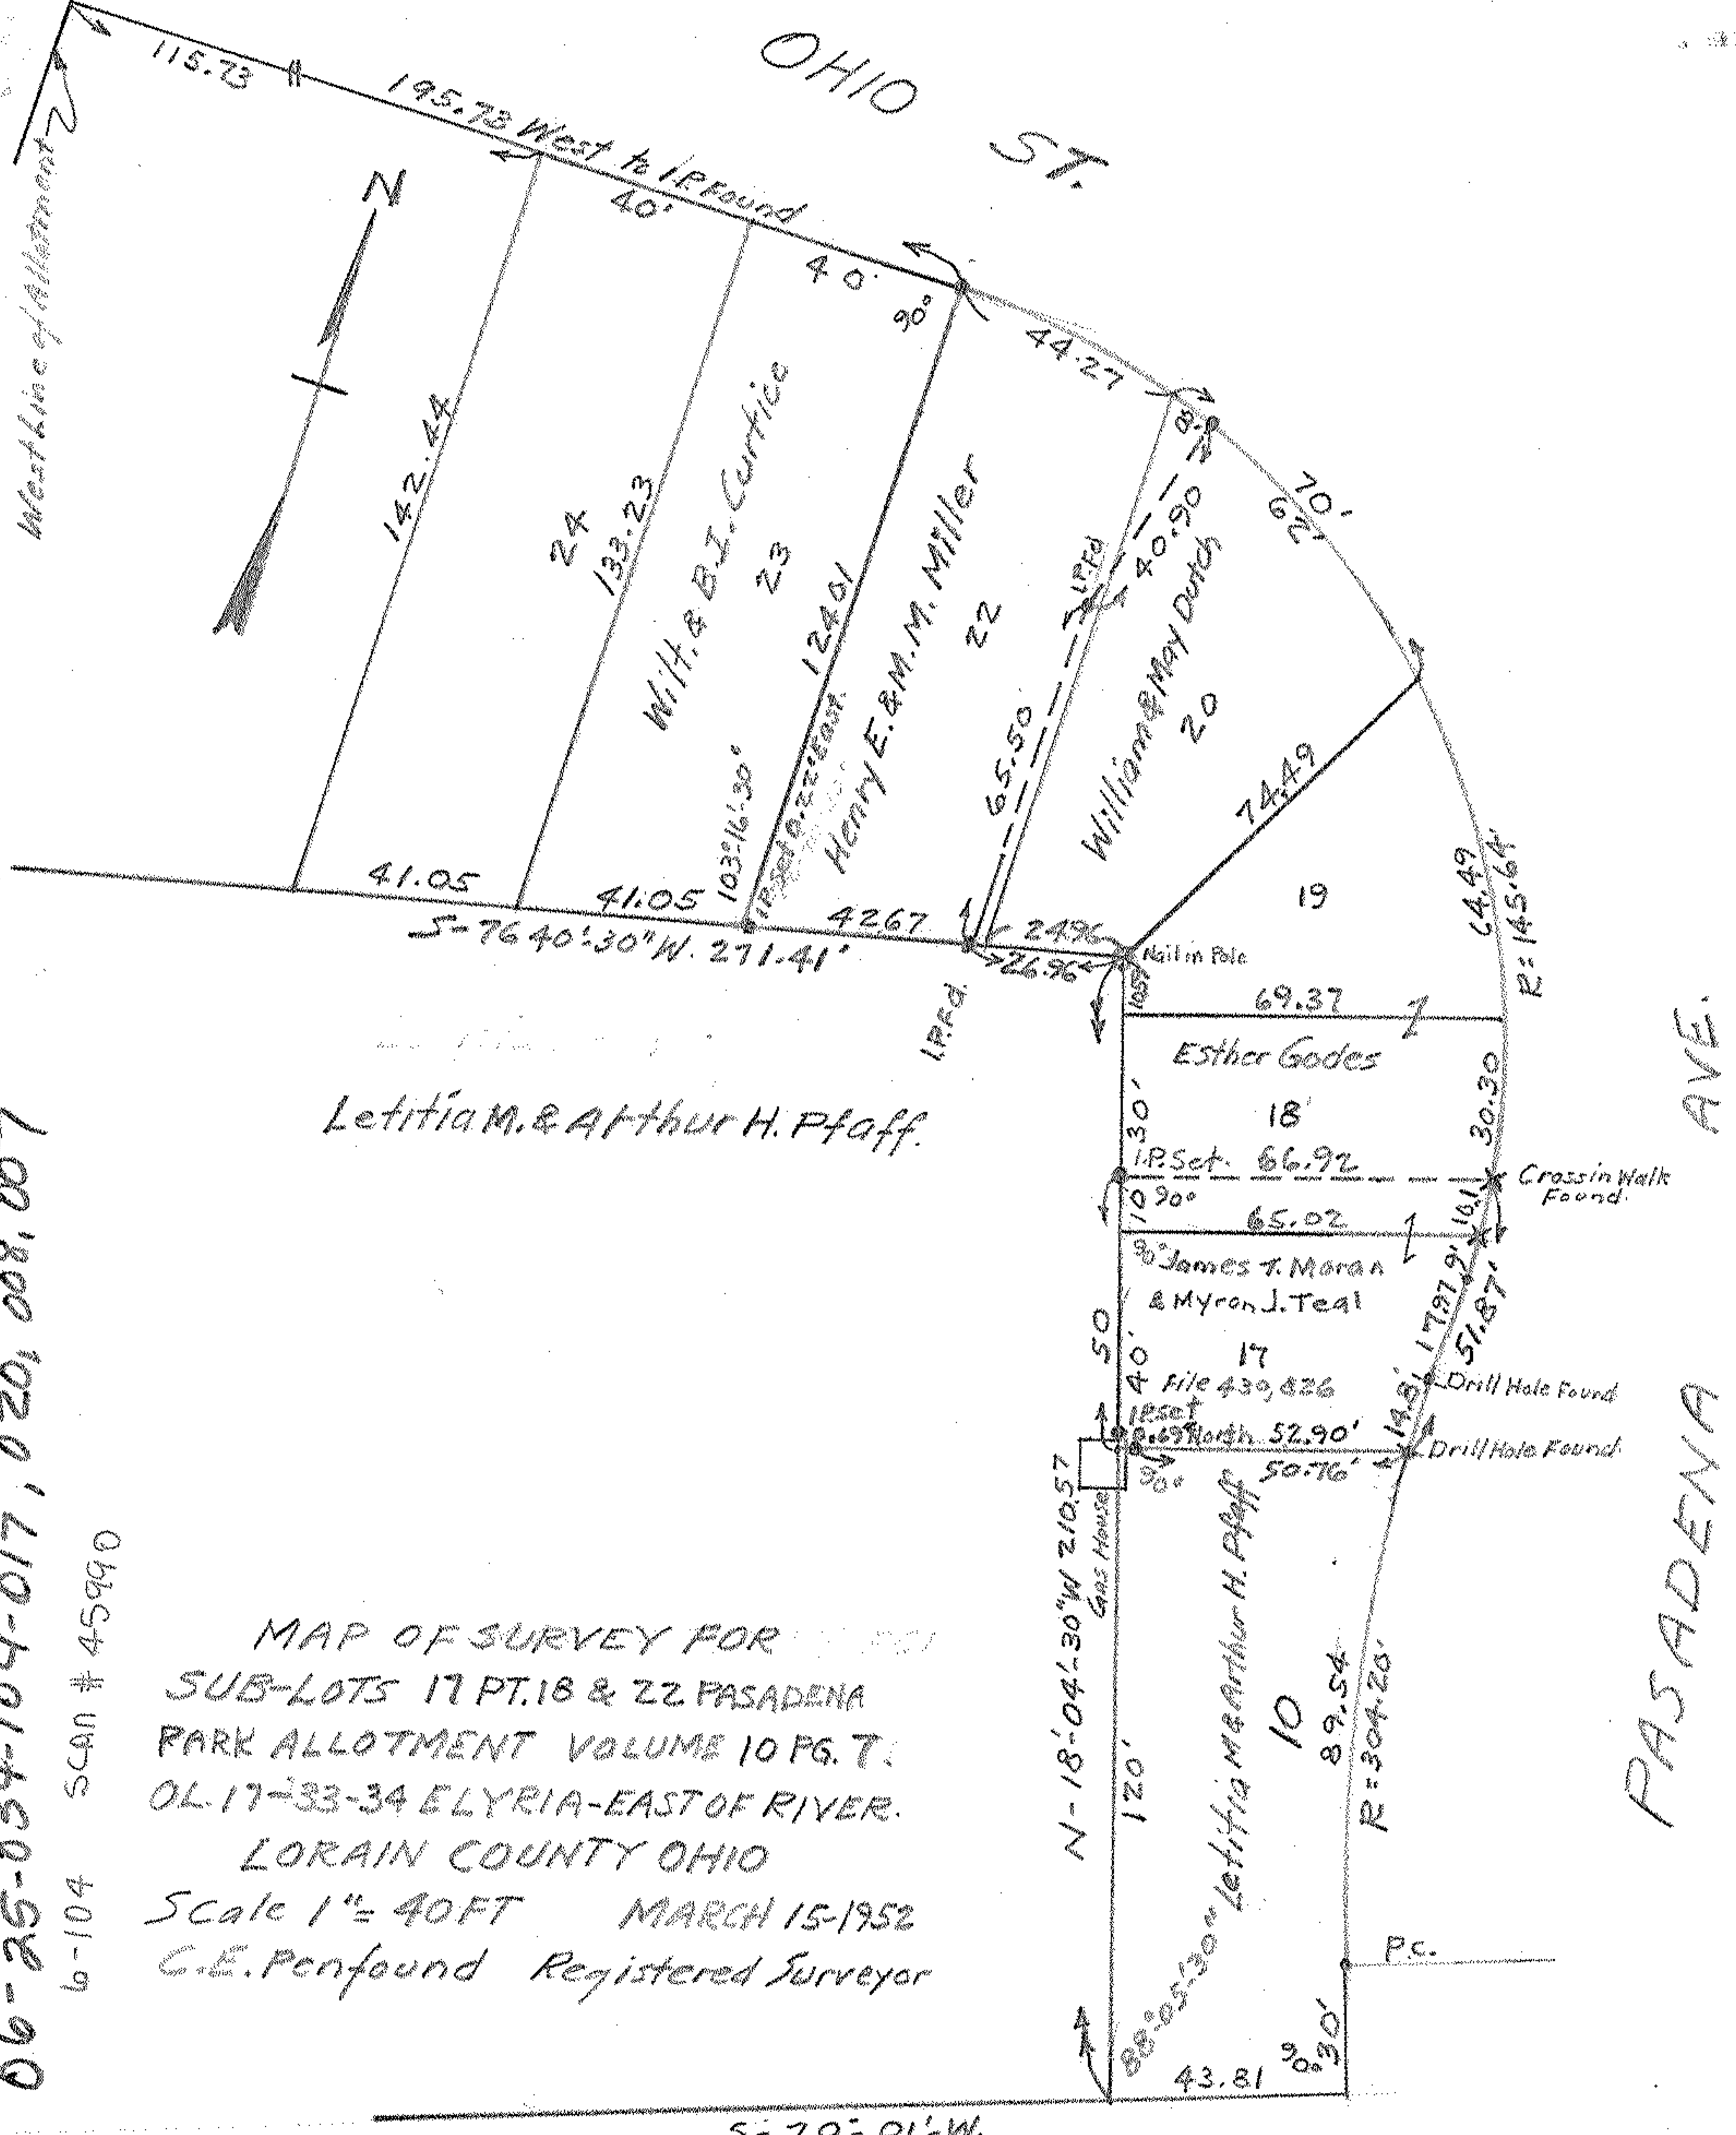

Letitia M. & Arthur H. Pfaff.


MAP OF SURVEY FOR  
 SUB-LOTS 17 PT. 18 & 22 PASADENA  
 PARK ALLOTMENT VOLUME 10 PG. 7  
 OL. 17-33-34 ELYRIA-EAST OF RIVER.  
 LORAIN COUNTY OHIO  
 Scale 1" = 40 FT MARCH 15-1952  
 G.E. Penfound Registered Surveyor

CLEVELAND STREET.

PASADENA AVE.

OHIO ST.

West Line of Allotment 2

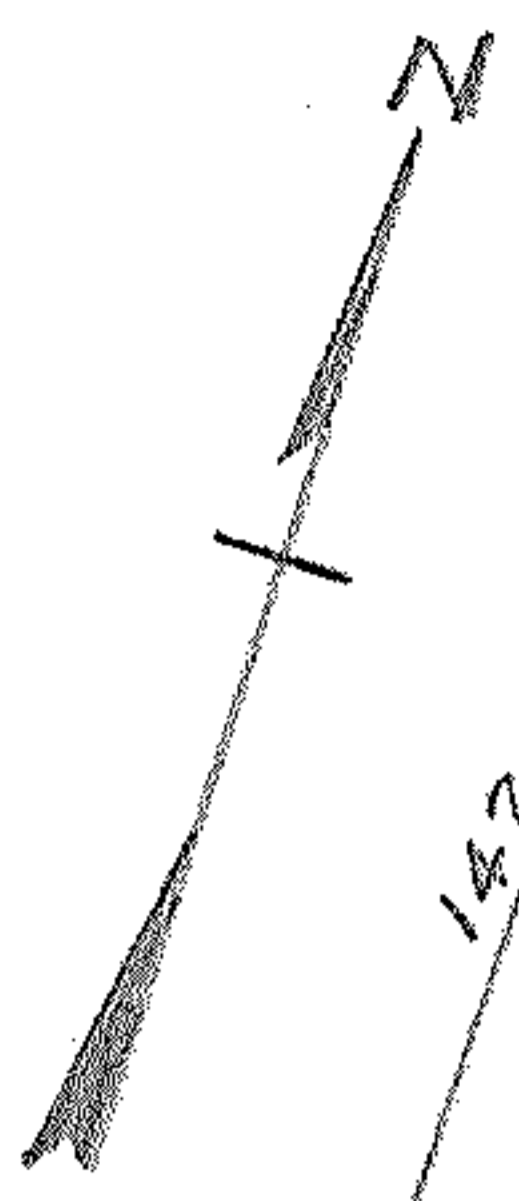

S-70-01'-W.

Pc.

43.81

10

89.54

R=304.20'

N-18-04'-30"W 210.57

Gas House

50'

40'

17

File 439, 826

18 set

2.69 North

52.90'

50.76'

51.87'

1797.9101

30.30

65.02

10 90°

18 set

66.92

50

40

17

James T. Moran & Myron J. Teal

18

Esther Godes

69.37

1059

Nail in Pole

26.76'

24%

4267

41.05

41.05

S-76 40'-30"W 271.41'

20

70'

70'

20

65.50

44.27

80°

40

40

20

124.01

103°16'30"

133.23

24

142.24

115.73

195.73 West to IR Found

40'

40'

20

65.50

44.27

80°

40

40

20

124.01

103°16'30"

133.23

24

142.24

115.73

195.73 West to IR Found

40'

40'

20

65.50

44.27

80°

40

40

20

124.01

103°16'30"

133.23

24

142.24

115.73

195.73 West to IR Found

40'

40'

20

65.50

44.27

80°

40

40

20

124.01

103°16'30"

133.23

24

142.24

115.73

195.73 West to IR Found

40'

40'

