


06.25.035.109.004 -006
6-84
SCAN #45995

06.25.035.109.004 -006

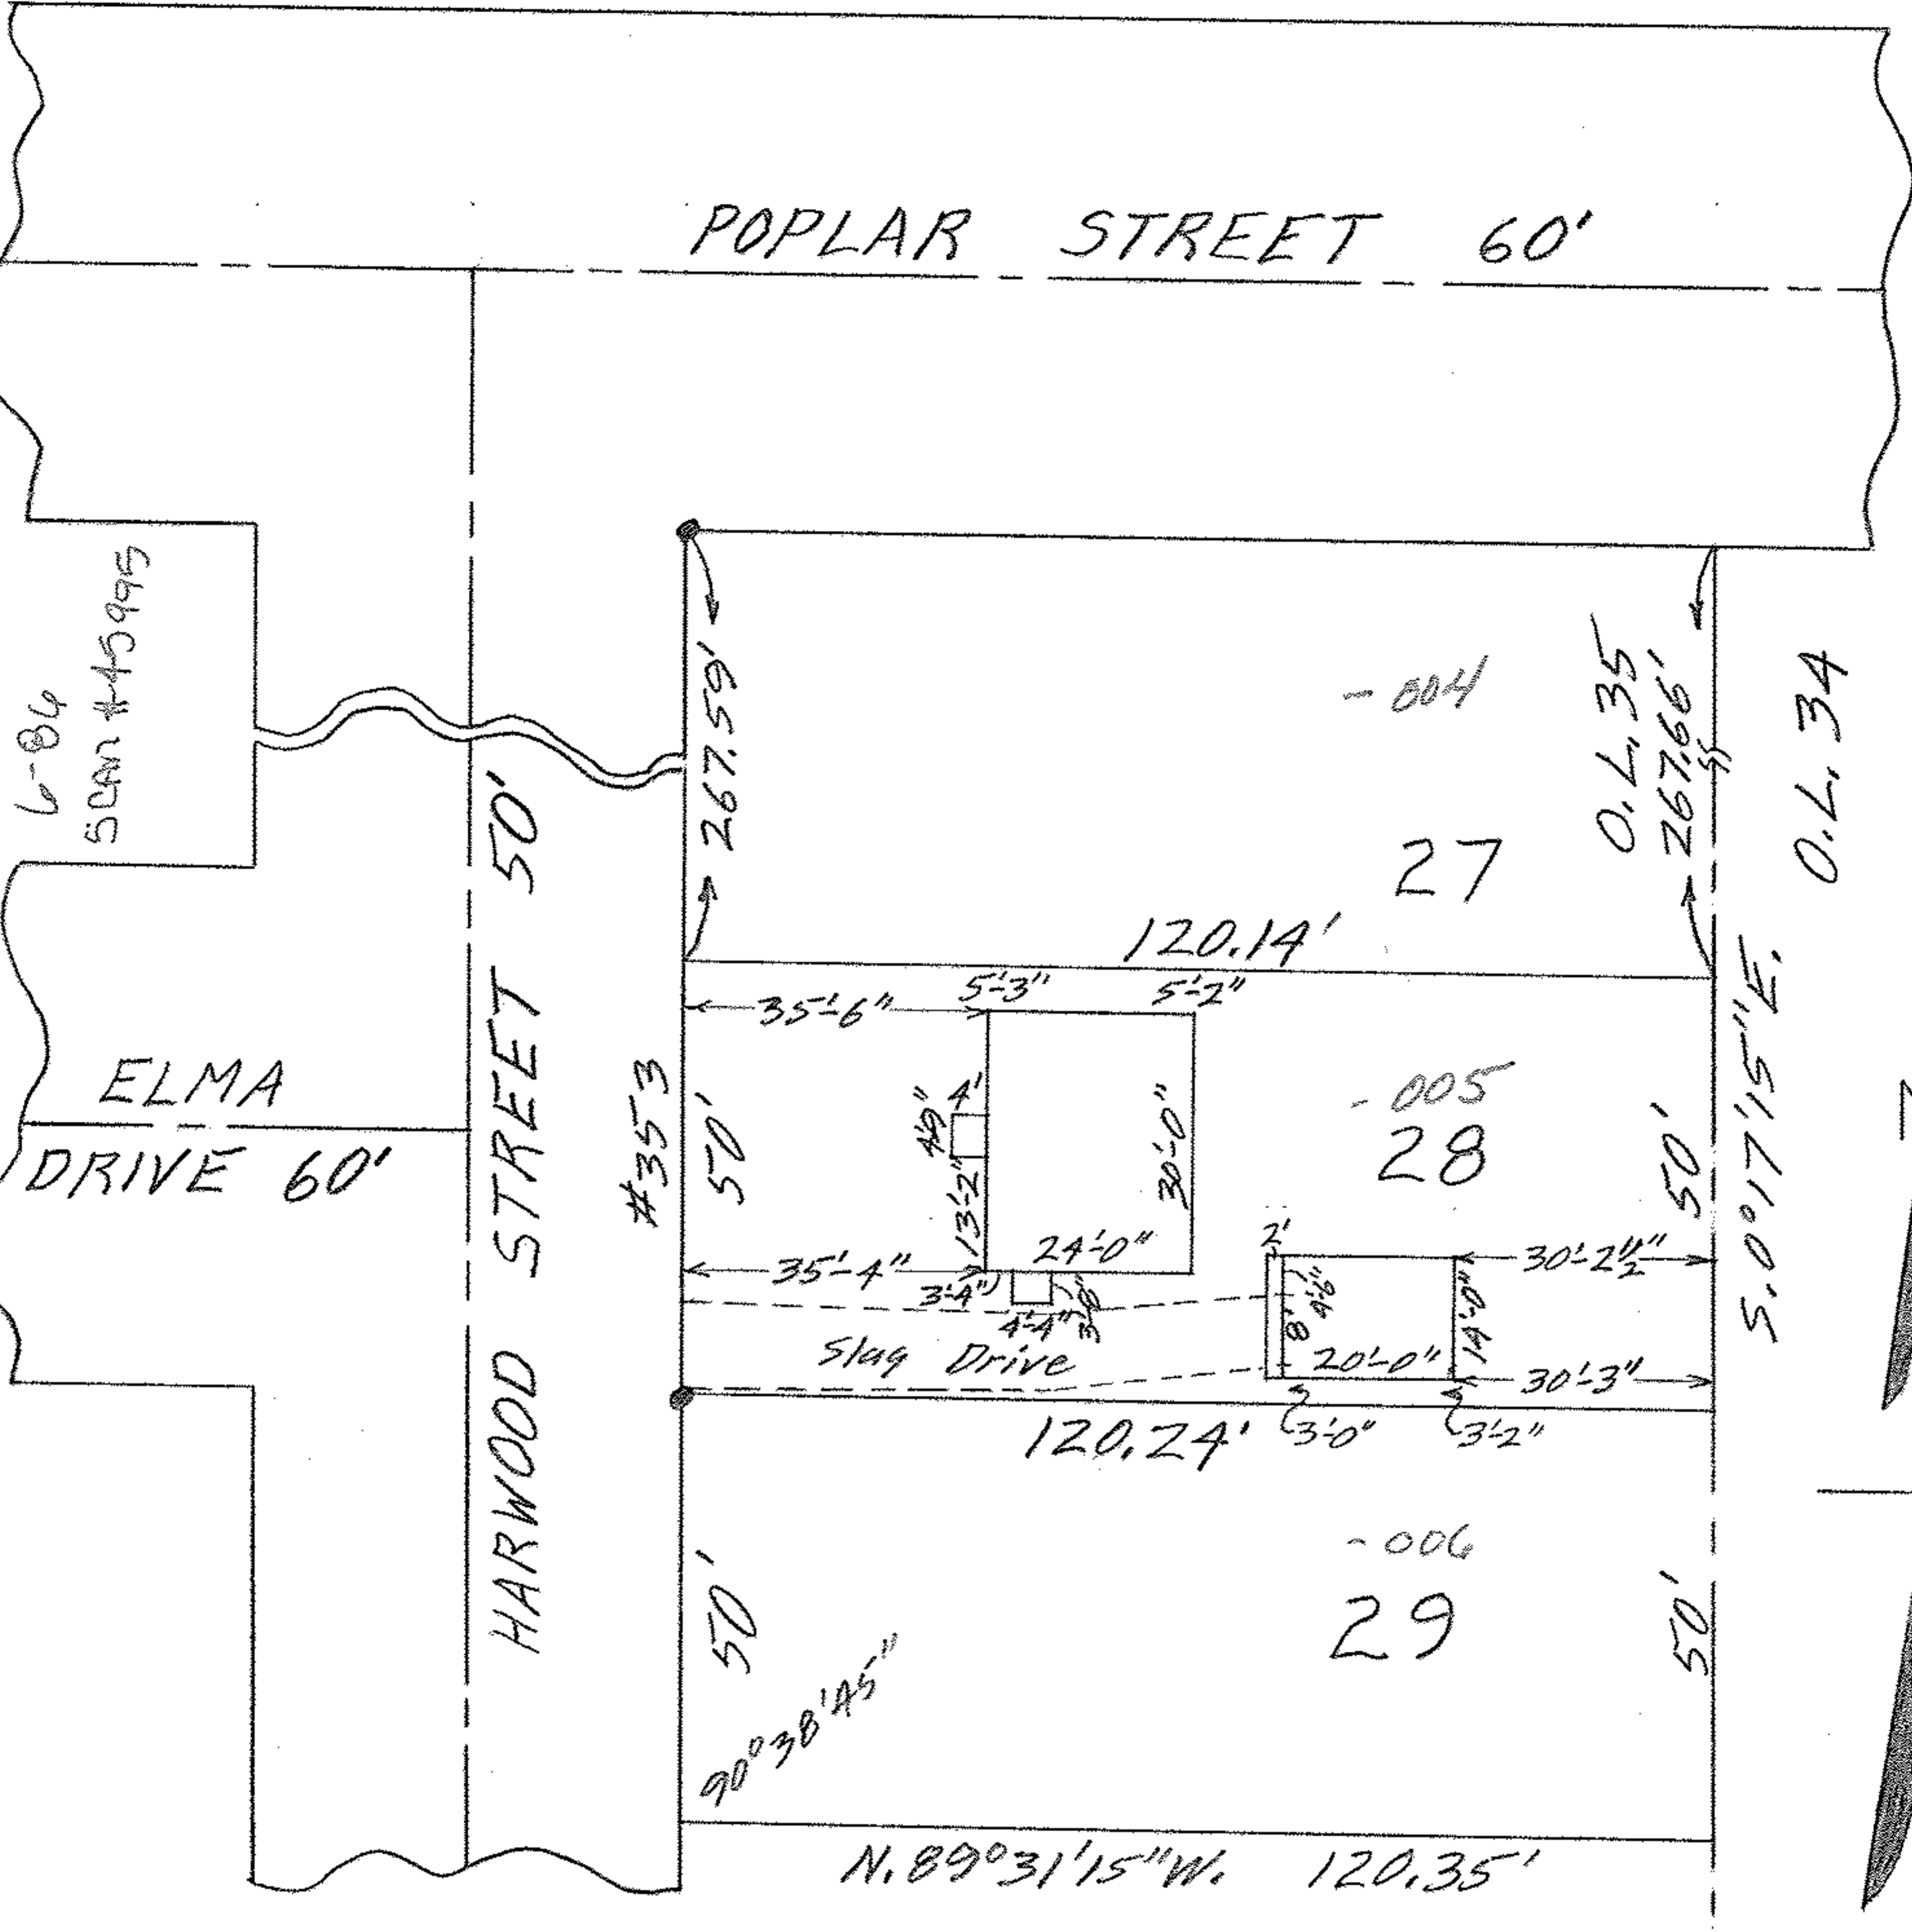

MAP OF SUB-LOT NO. 28

GULFHURST SUB'N. NO. 1 Vol. 13 Pg. 26
O.L. 35 EAST OF RIVER ELYRIA TWP.
ELYRIA CITY LORAIN CO. OHIO
SCALE: 1" = 30' AUG. 23-1962 4:00 P.M.

Gary E. Penfound REG. SURVEYOR

Charles W. & Suzanne Mason W W